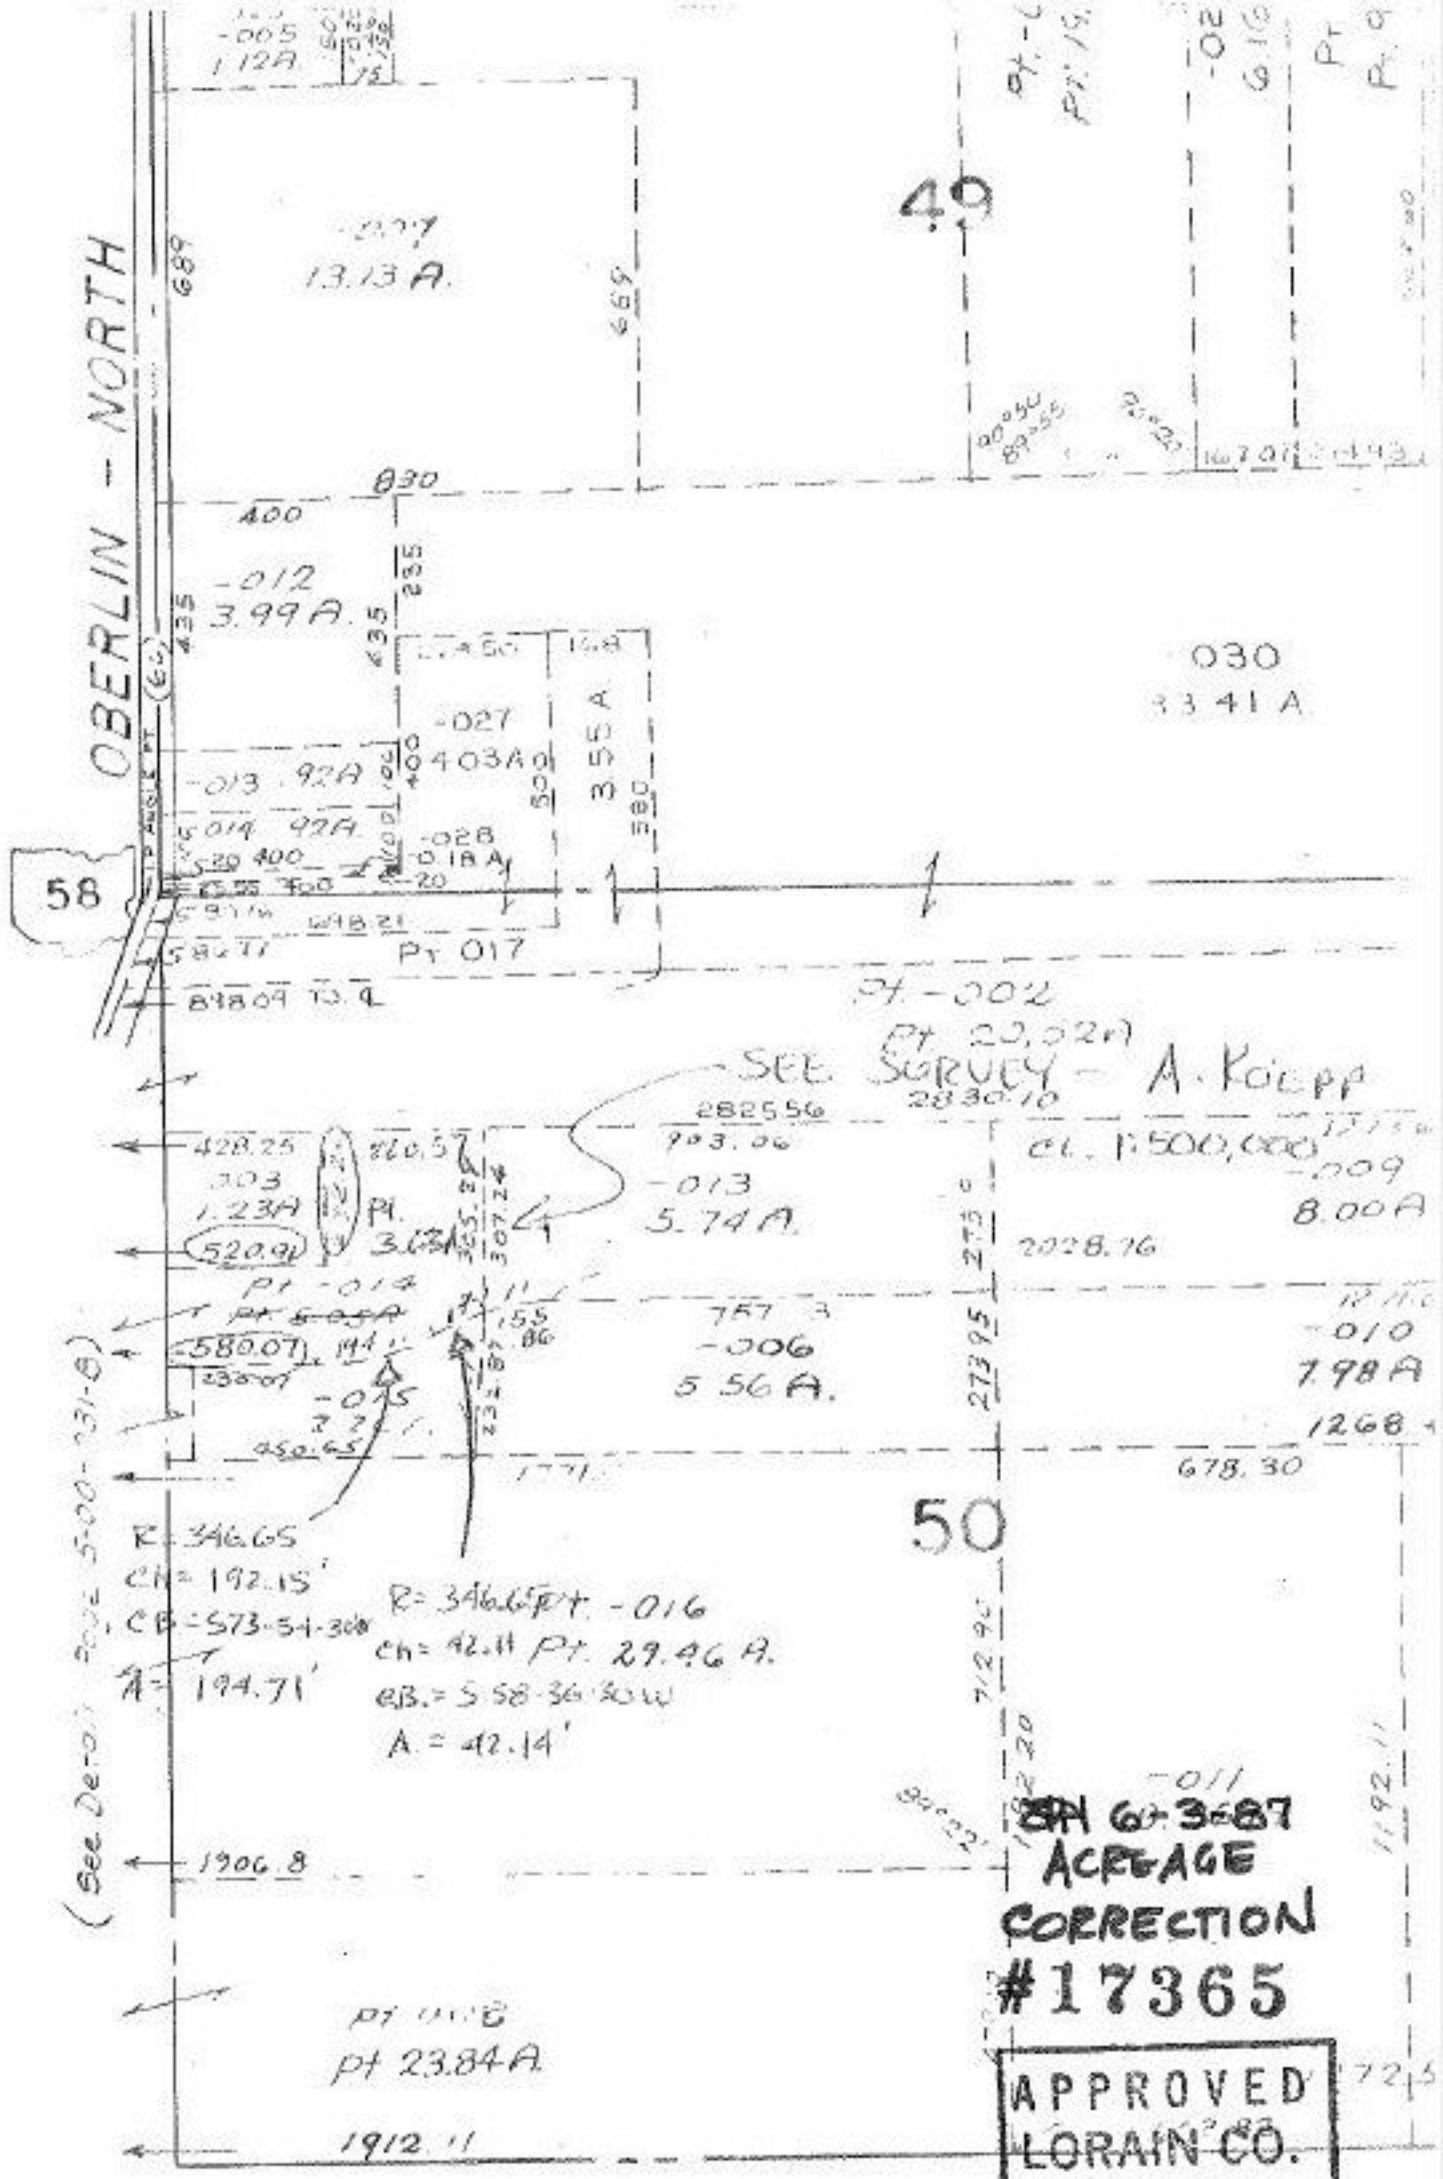

SPH 6-3-87
ACREAGE
CORRECTION
#17365

APPROVED
LORAIN CO.
MAP DEPT.
DATE 4-8-87
PAGE 5-G
BY T. McMain
VOID AFTER

#17365

AMHERST TWP