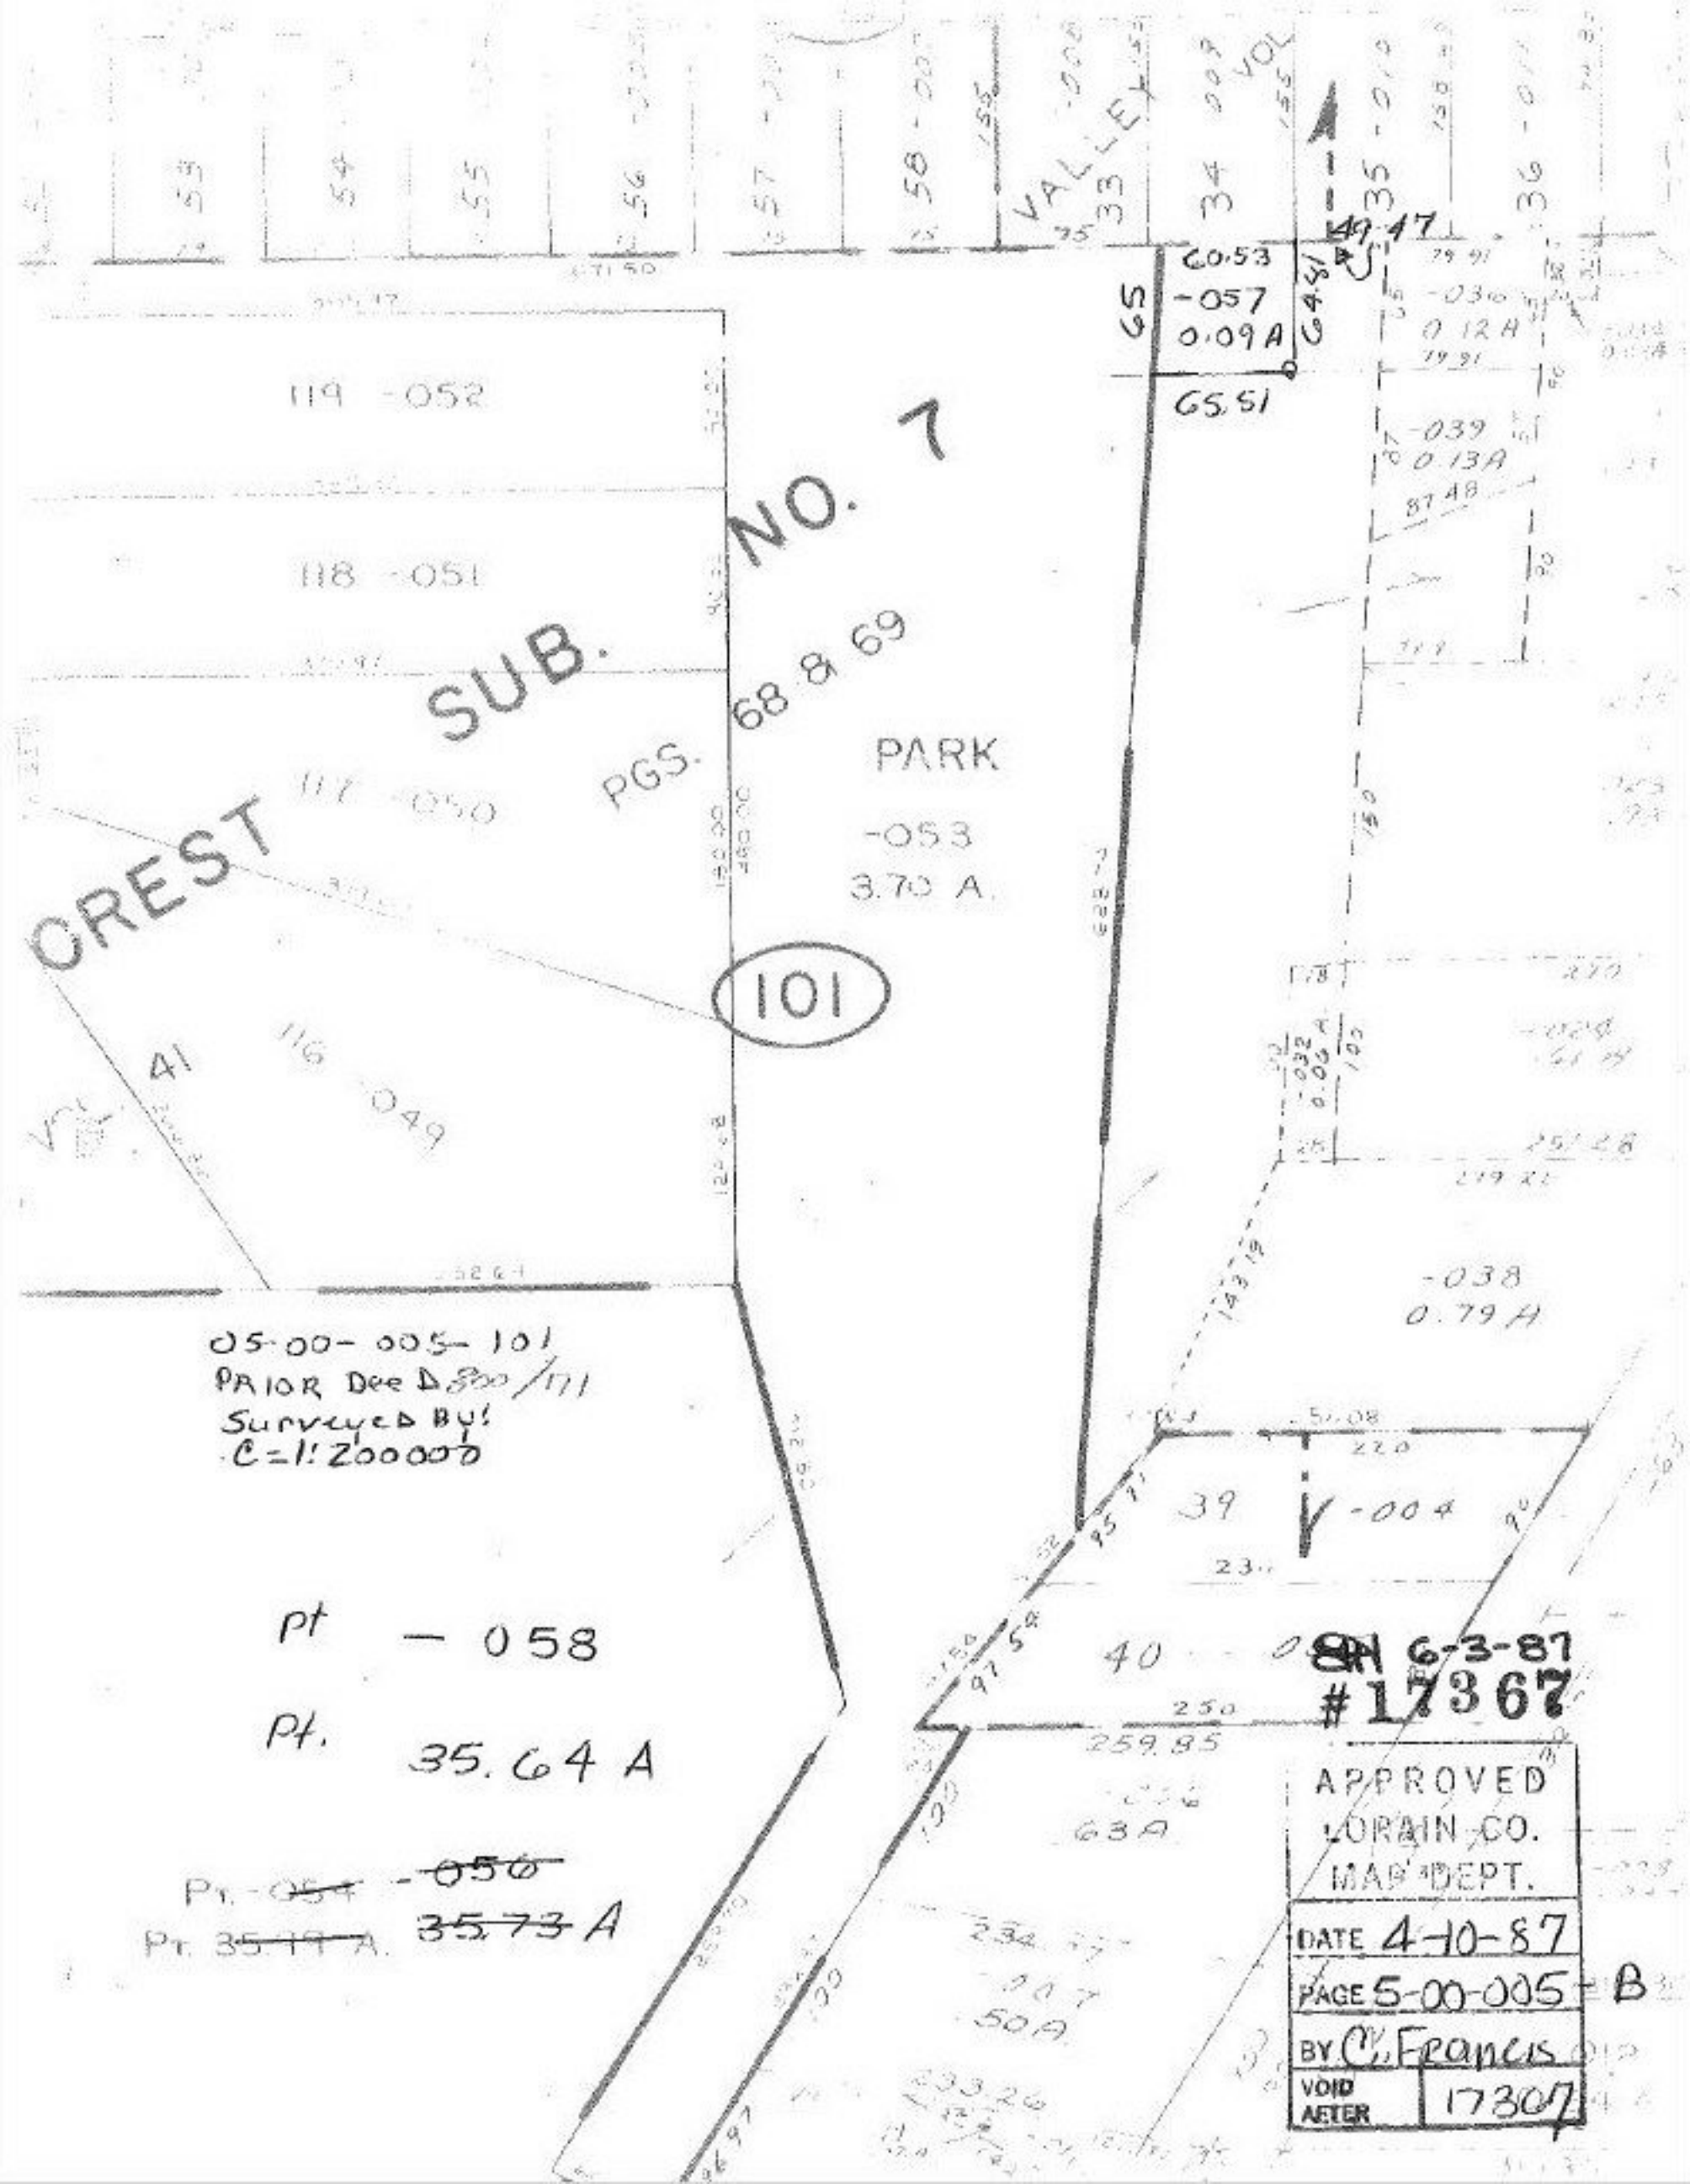

VALLEY VOL
33
34
35
36
49.47
60.53
-057
0.09 A
65
64.81
65.51
-036
0.12 A
-039
0.13 A
119 -052
118 -051
117 -050
116 -049
CREST SUB. NO. 7
PGS. 68 & 69
PARK
-053
3.70 A.
101
41
-038
0.79 A
05-00-005-101
PRIOR Dee D 800/171
Surveyed By:
C=1:200000
39
-004
40
259.85
63 A
50 A
pt - 058
Pt. 35.64 A
Pt. ~~-054~~ ~~-056~~
Pt. ~~35.19 A.~~ ~~35.73~~ A
6-3-87
#17367
APPROVED
LORAIN CO.
MAP DEPT.
DATE 4-10-87
PAGE 5-00-005-B
BY C. Francis
VOID AFTER 17307