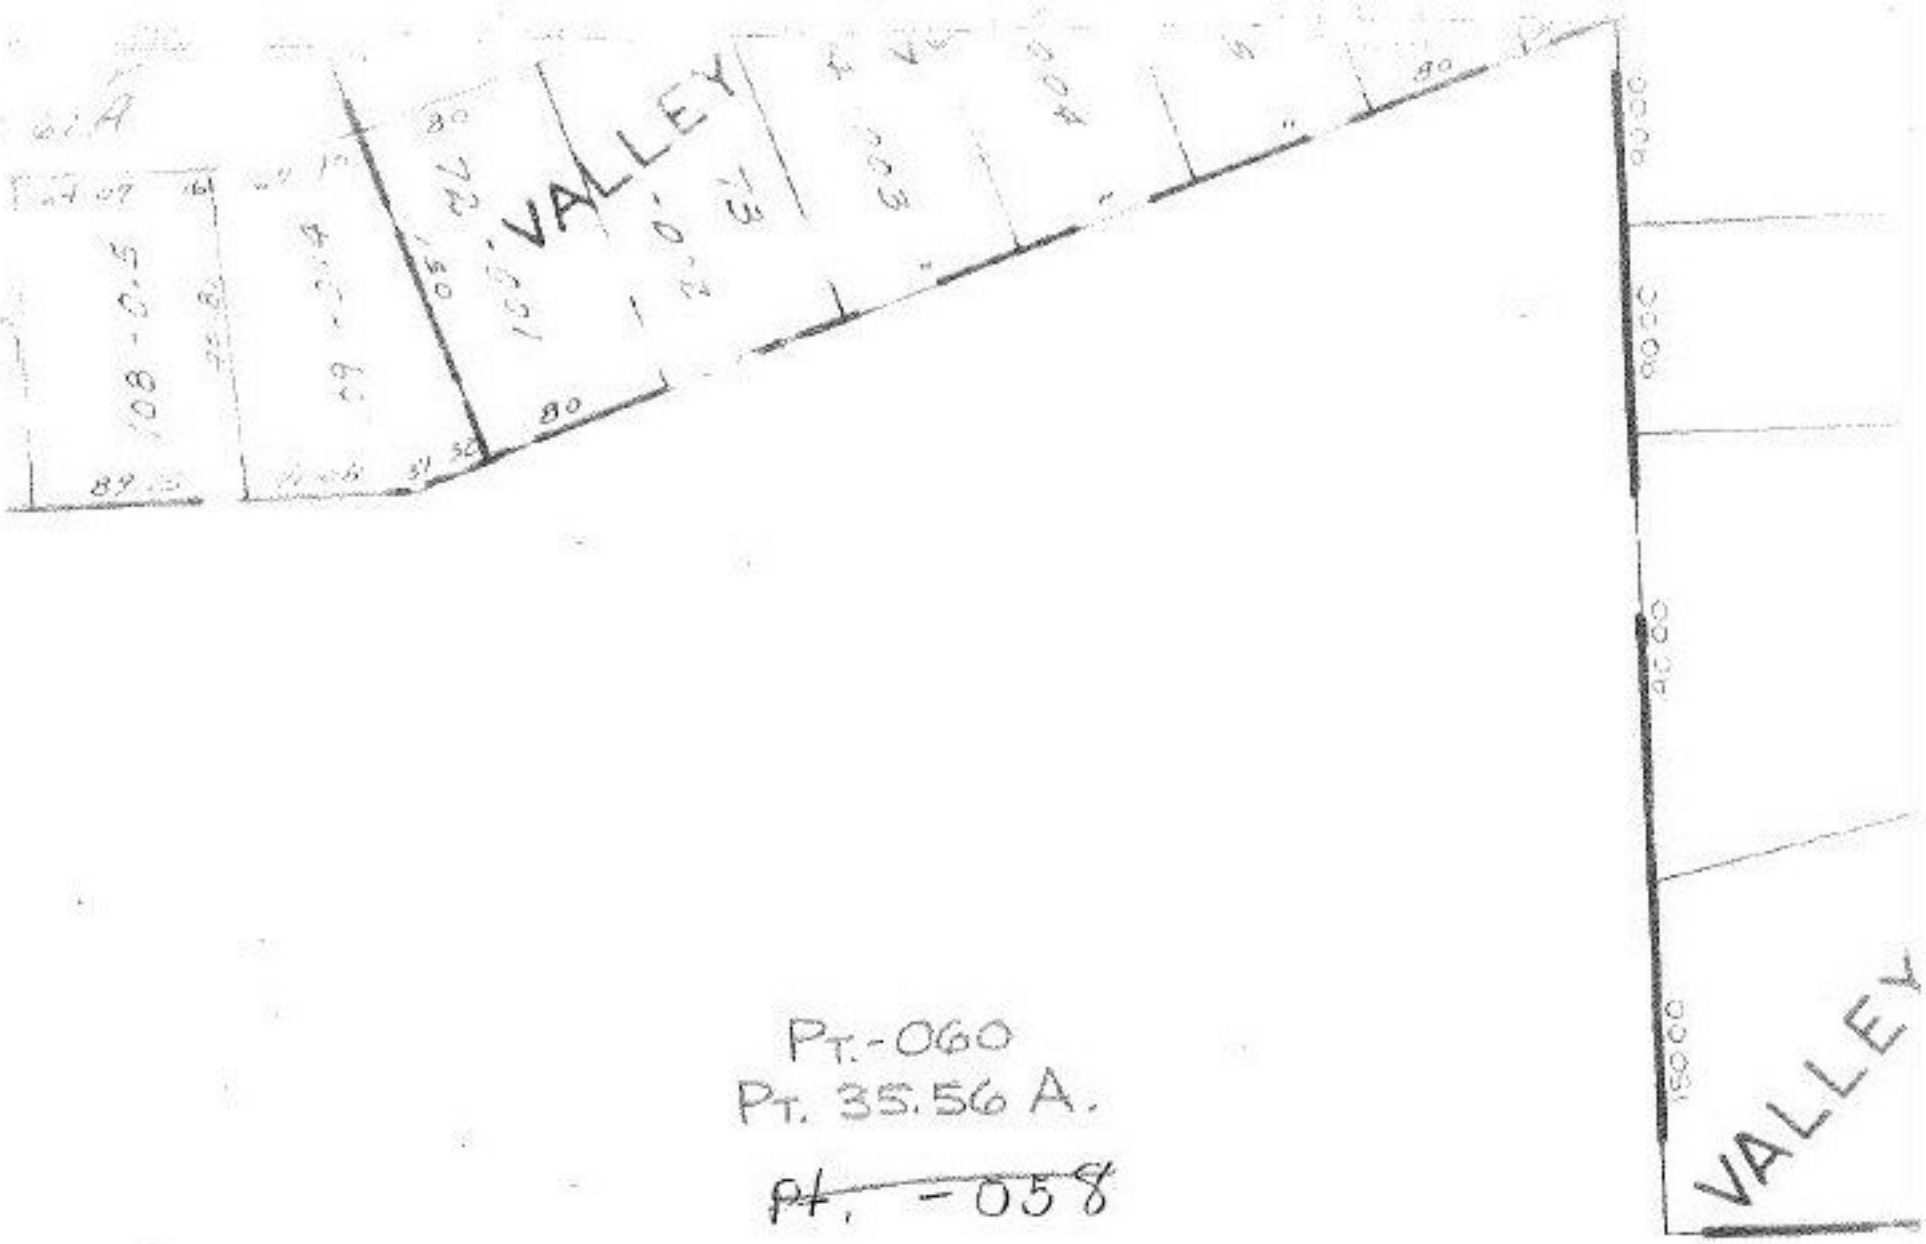


Pt.-060
Pt. 35.56 A.

~~Pt. -058~~

~~Pt. 35.64 A~~

~~-056~~

101

~~35.73 A~~

Pt. ~~-054~~

Pt. ~~35.99 A~~

~~SPH~~ 6-3-87
#17367

APPROVED
LORAIN CO.
MAP DEPT.
DATE 4-10-87
PAGE 5-00-005 A
BY C. Francis
VOID AFTER 17367