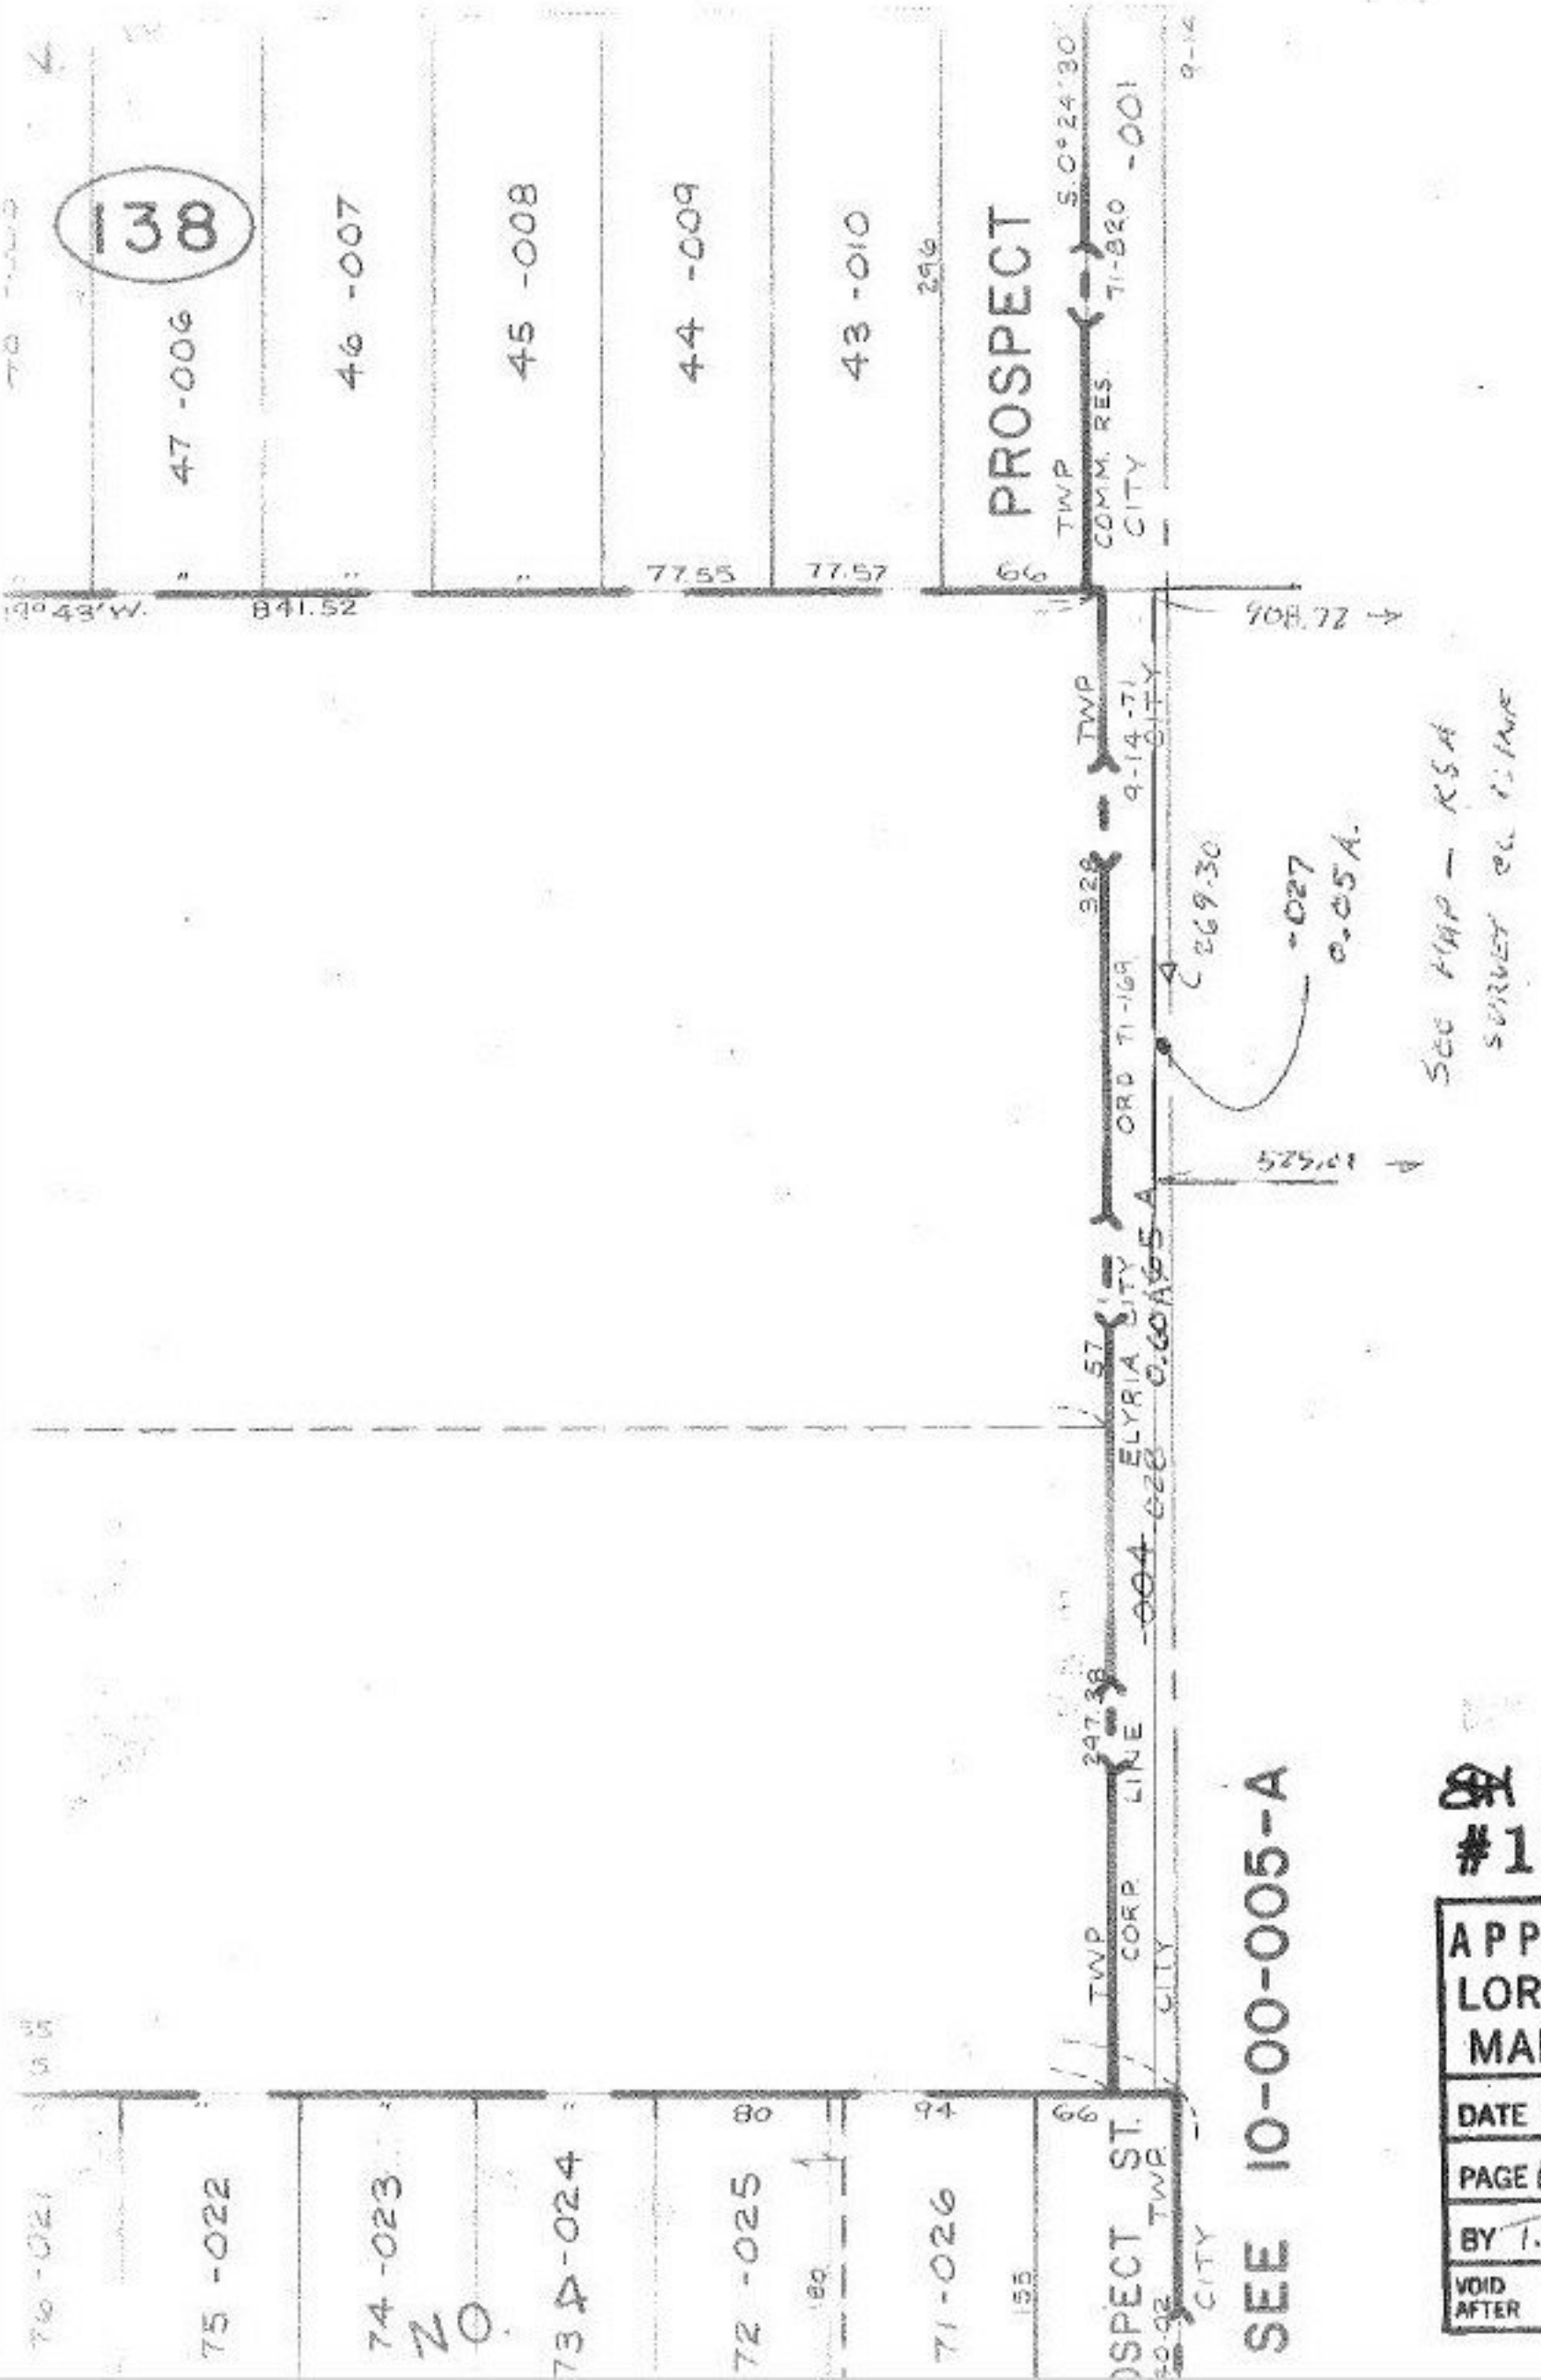

SH 7-15-87
#17372

APPROVED
LORAIN CO.
MAP DEPT.

DATE 4.15.87
PAGE 10.00.004.P
BY T. McNair
VOID AFTER