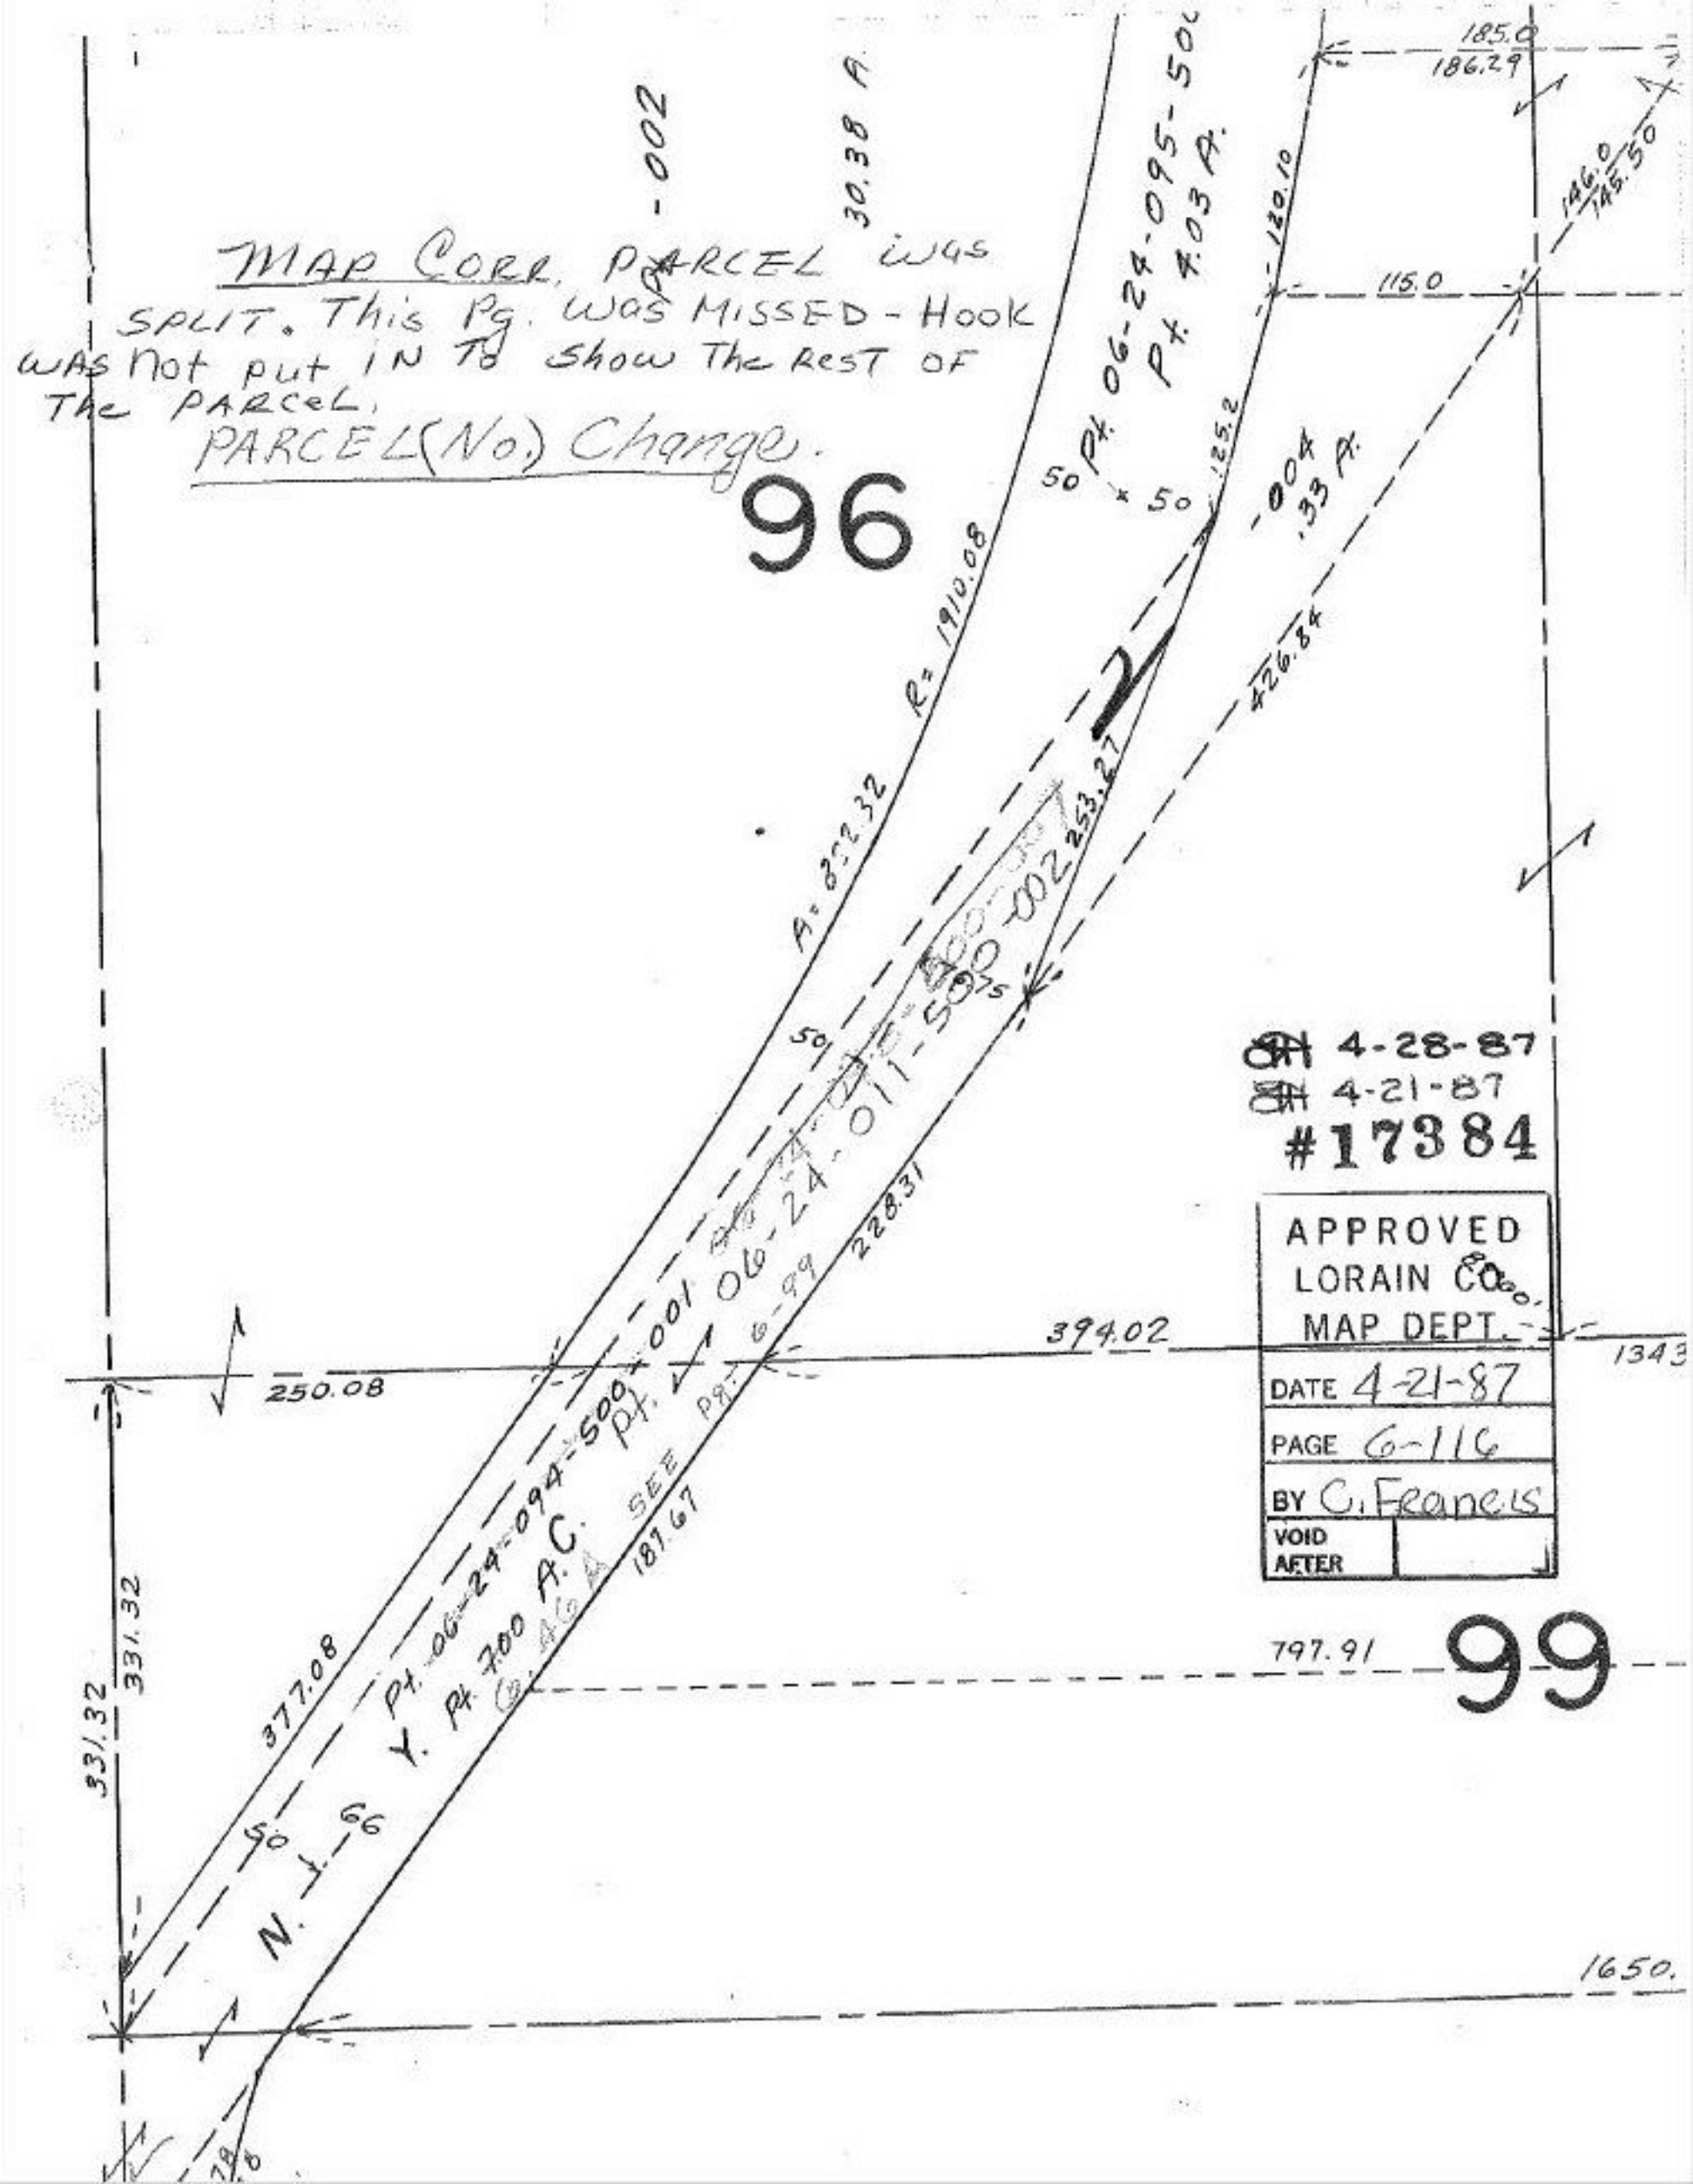
MAP CORR. PARCEL WAS SPLIT. This Pg. WAS MISSED - HOOK WAS Not put IN To Show The Rest OF The PARCEL.
PARCEL (No.) Change.
96
99
-002
30.38 A.
Pt. 06-24-095-500
Pt. 4.03 A.
185.0
186.29
146.0
145.50
120.10
115.0
125.2
-004
.33 A.
426.84
R= 1910.08
A= 852.32
253.27
Pt. 06-24-011-500-002
228.31
394.02
250.08
1343
Pt. 06-24-094-500-001
Pt. 700 A.C.
SEE Pg. 6-99
187.67
377.08
331.32
797.91
1650.
N.Y.
66
50
4-28-87
4-21-87
#17384
APPROVED
LORAIN CO.
MAP DEPT.
DATE 4-21-87
PAGE 6-116
BY C. Francis
VOID AFTER