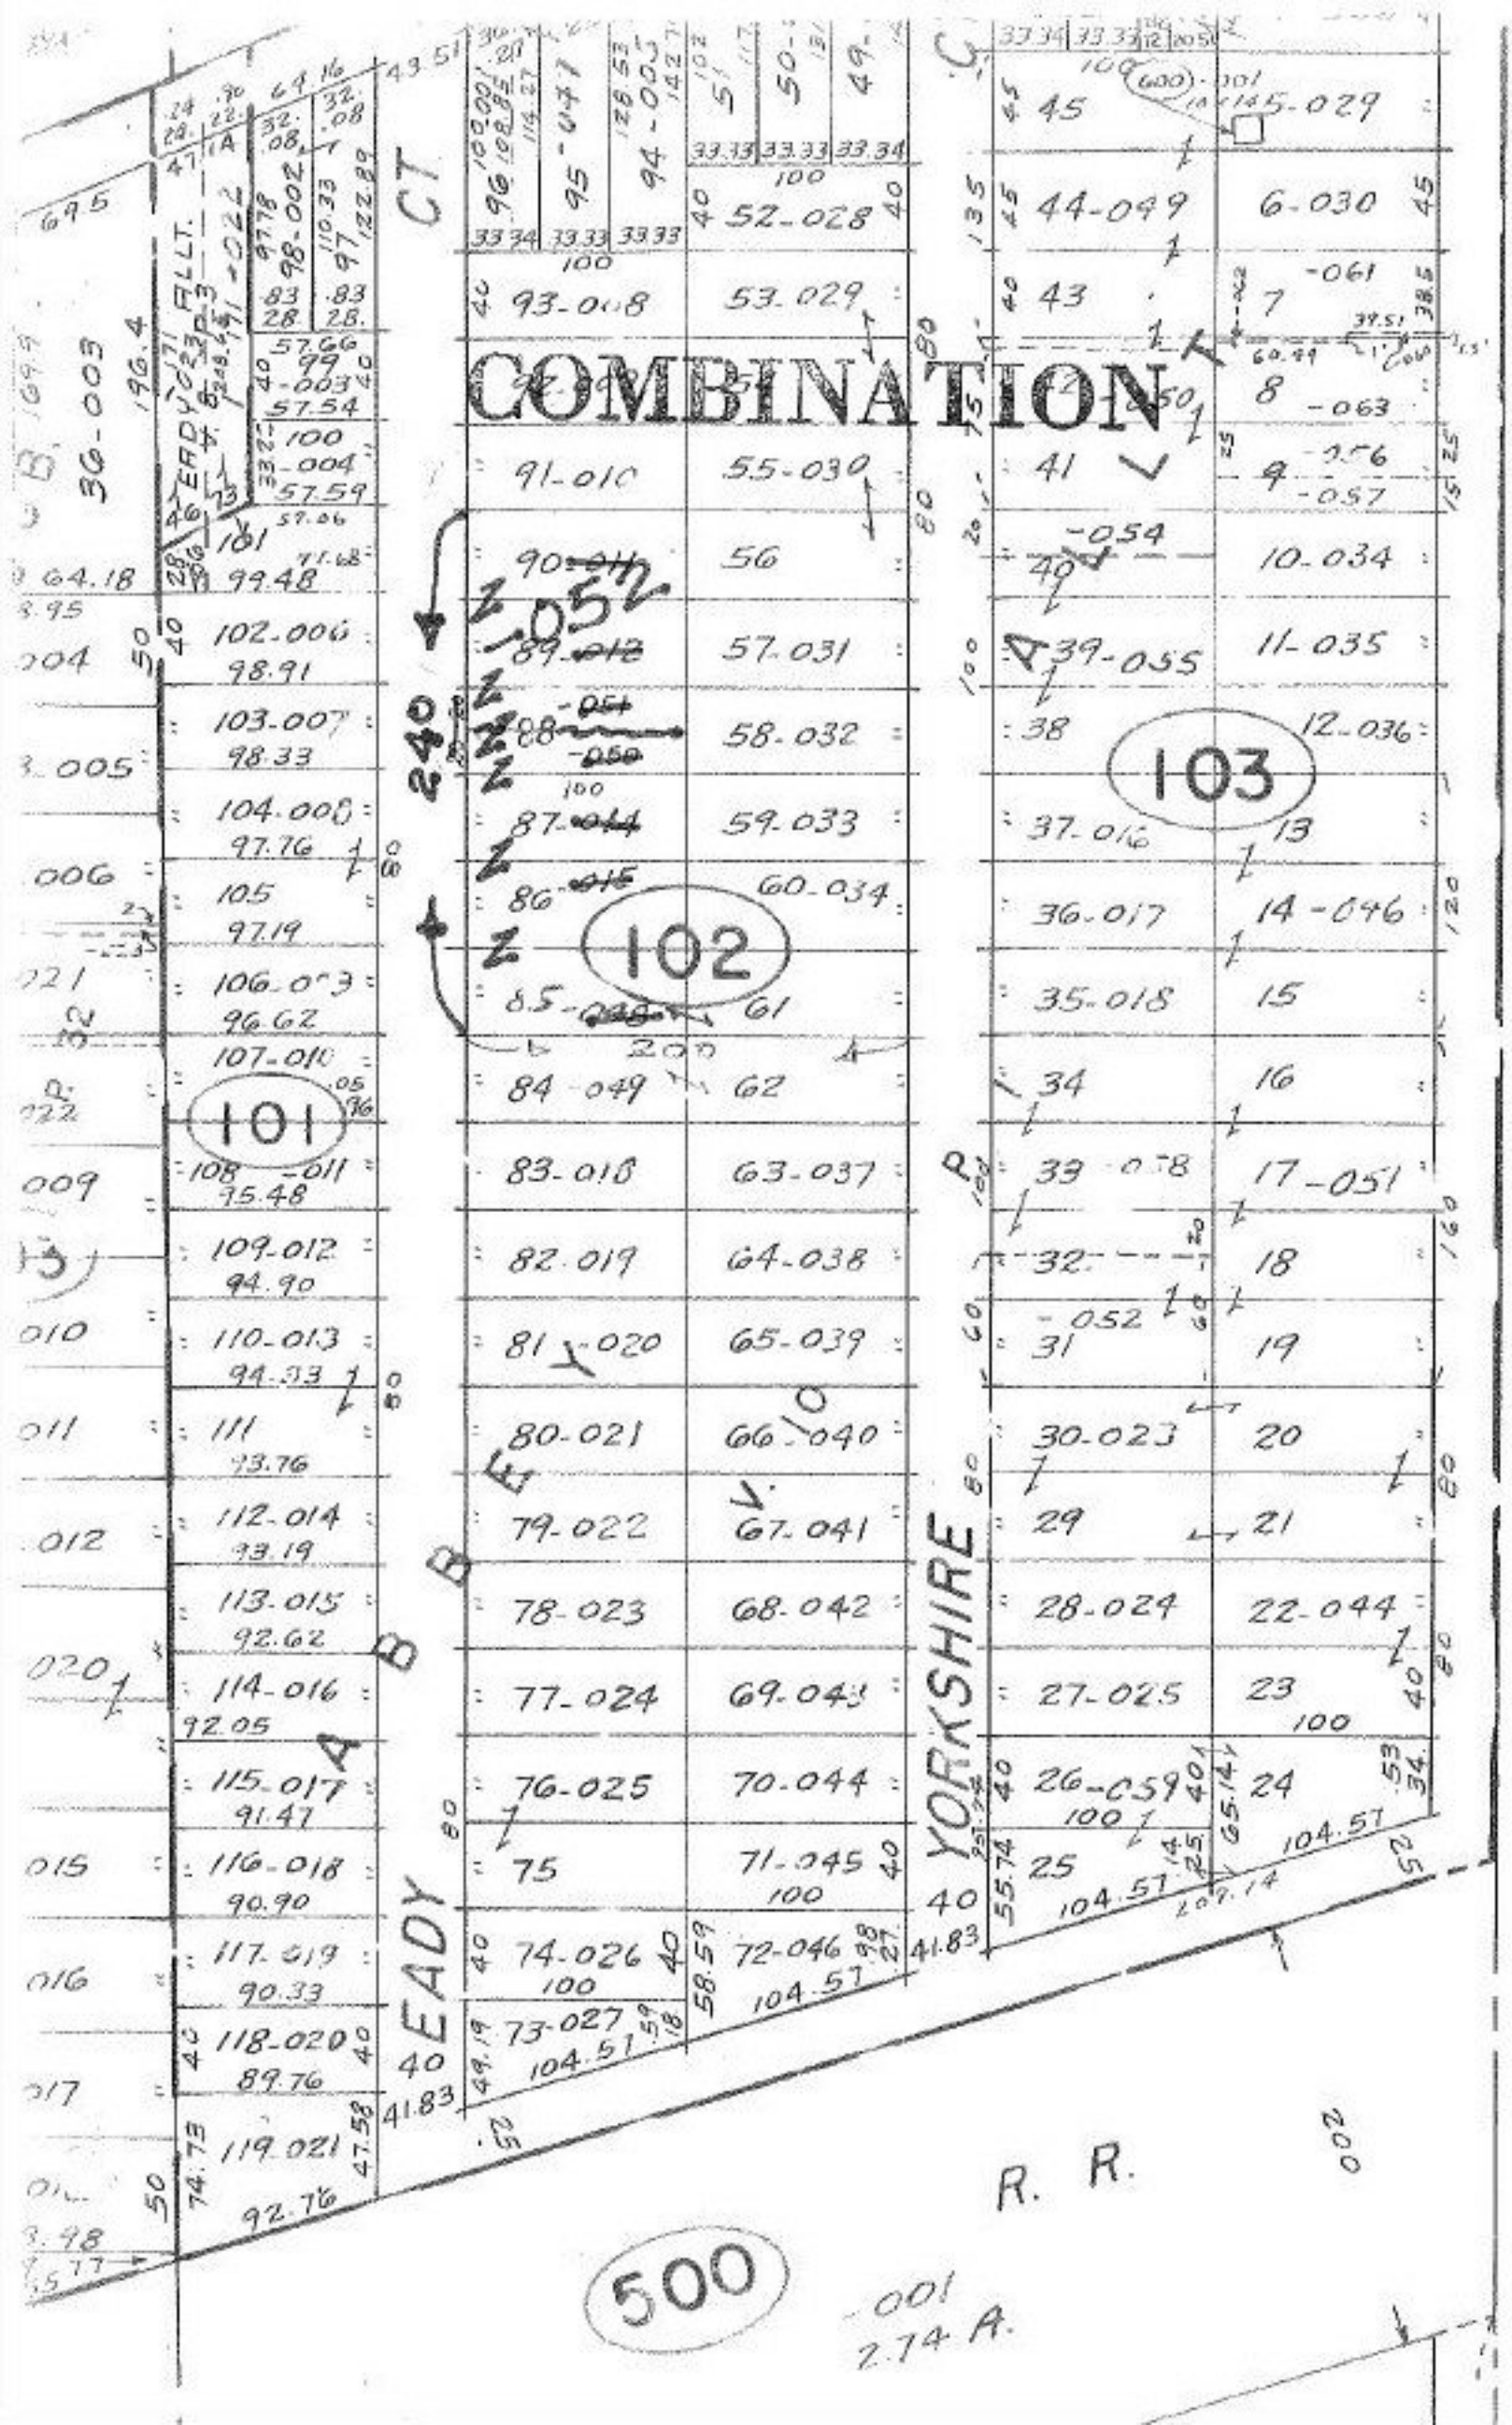

SH 4-28-87
#17388

APPROVED
LORAIN CO.
MAP DEPT.
DATE 4-23-87
PAGE 6-106
BY C. Francis
VOID AFTER 17388