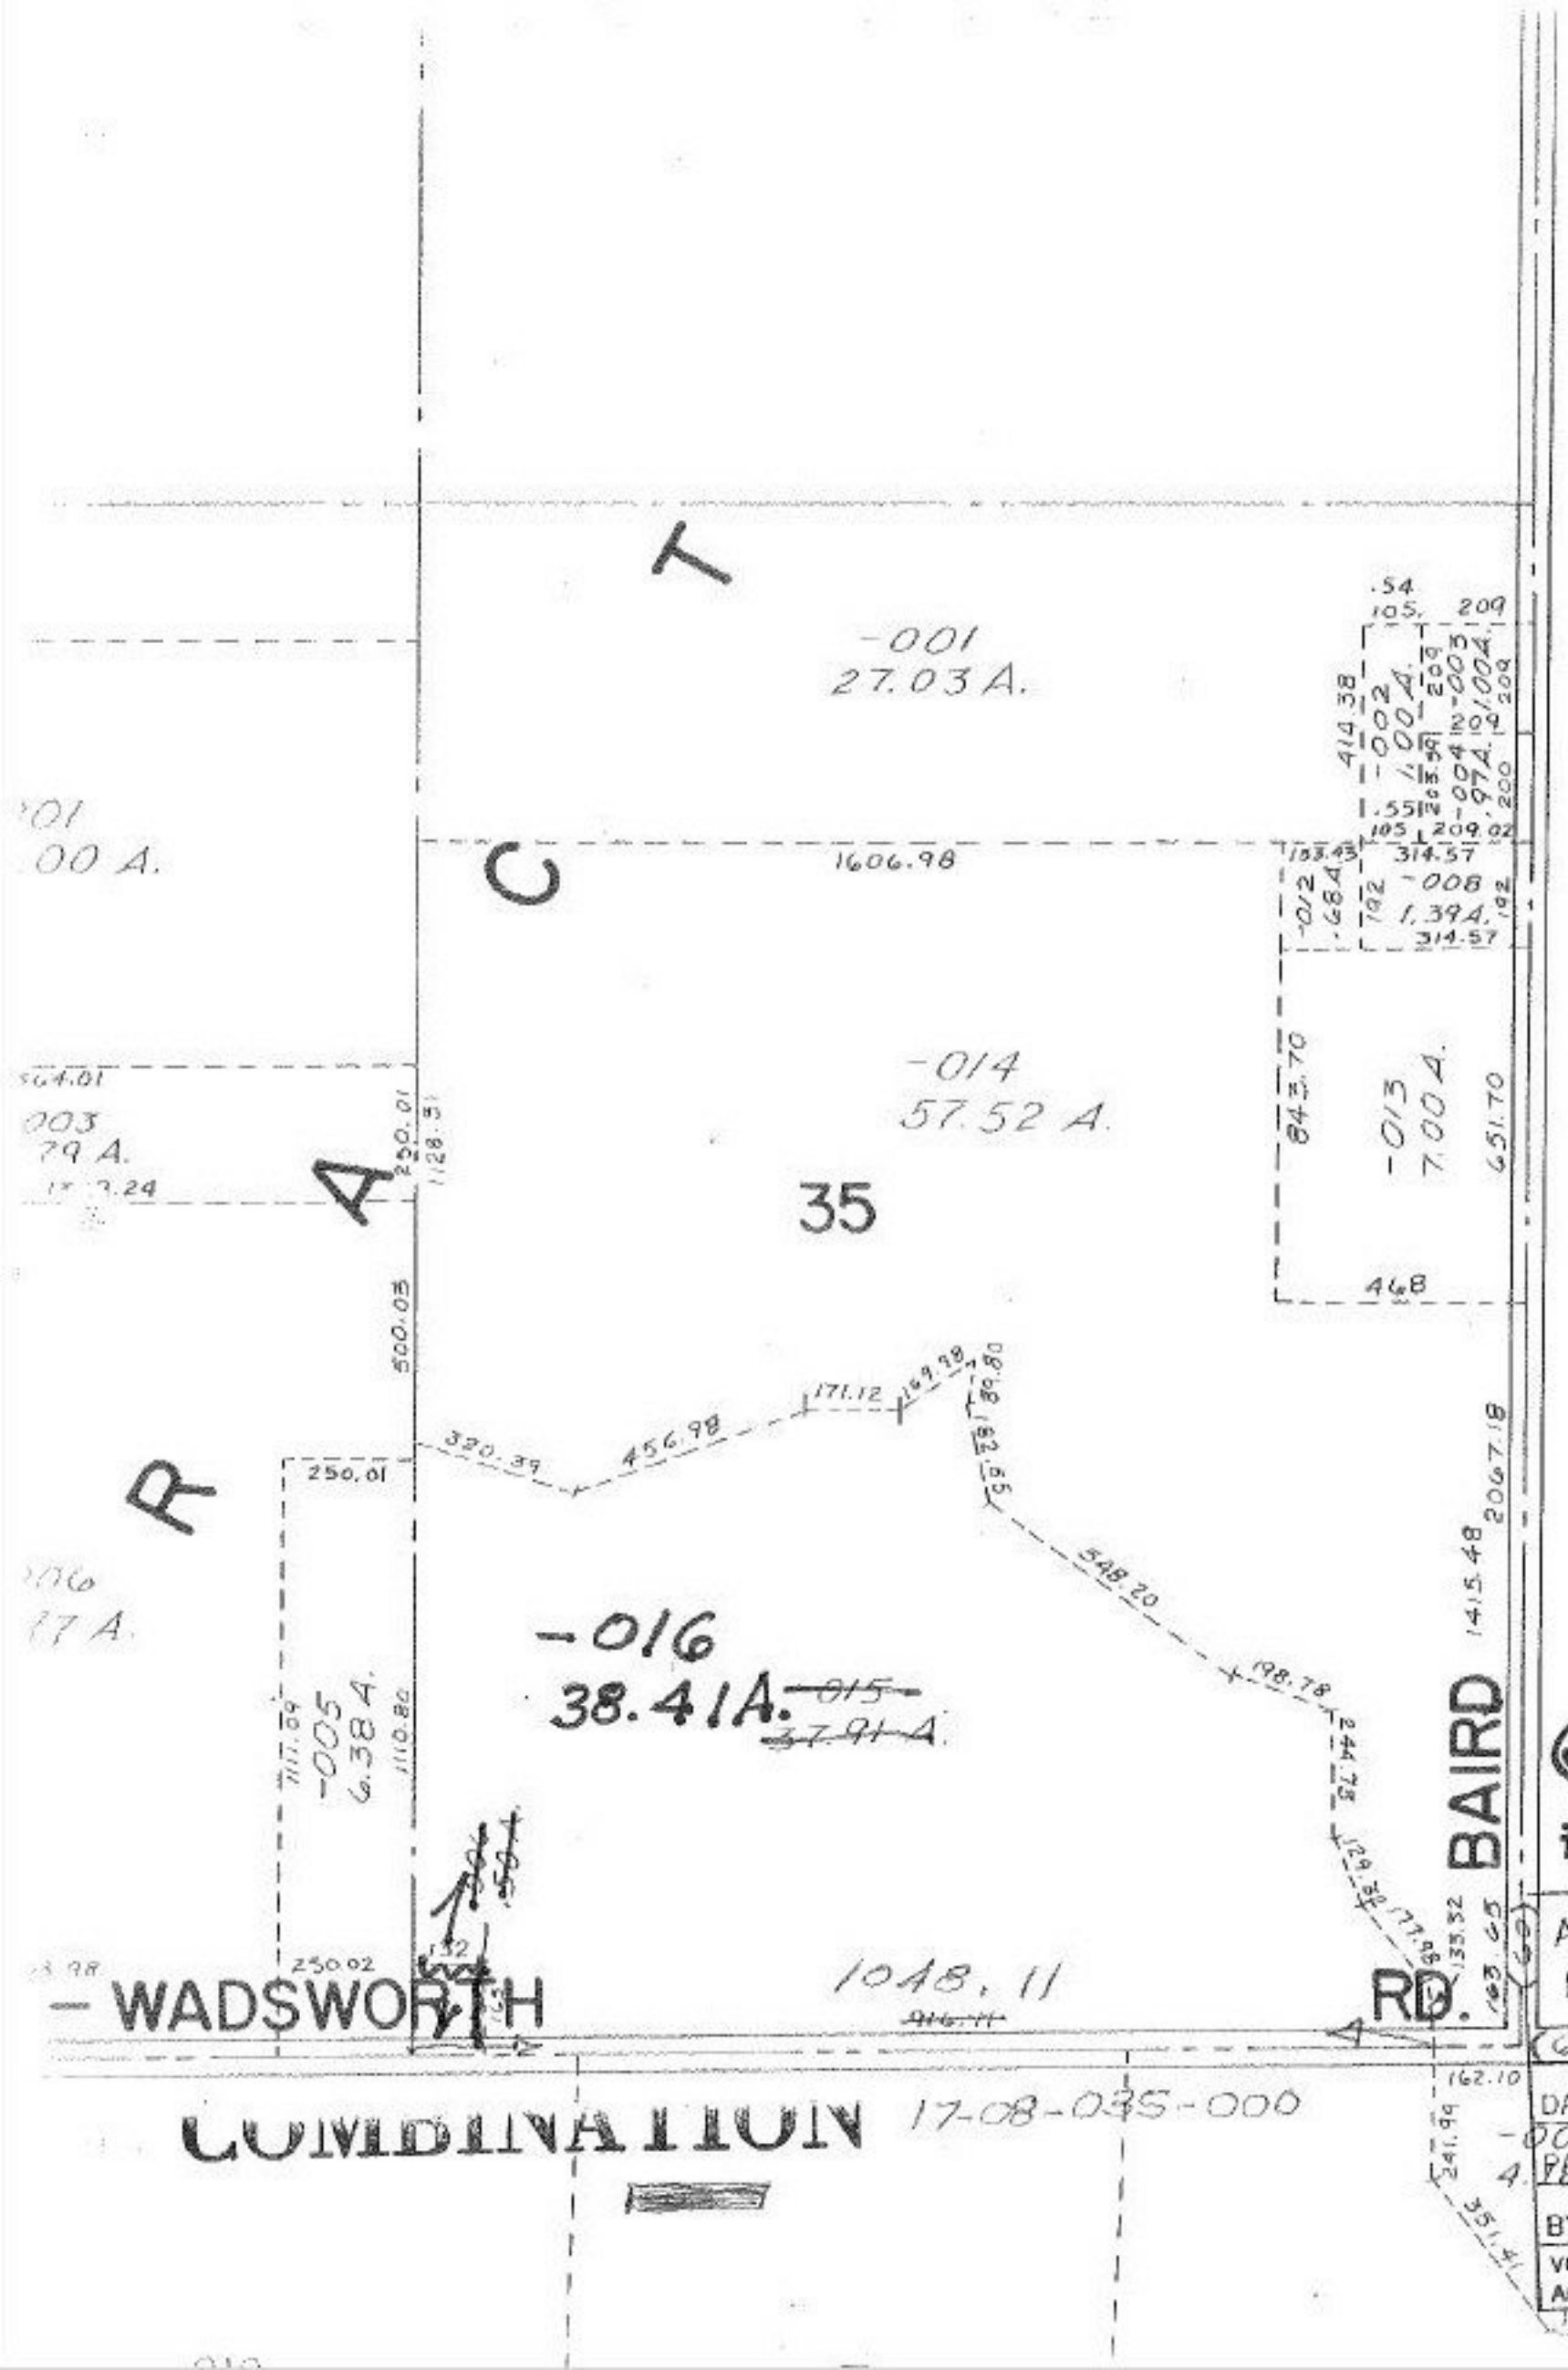
-001
27.03 A.
1606.98
-014
57.52 A.
35
-013
7.00 A.
-016
38.41 A.
-005
6.38 A.
BAIRD RD.
WADSWORTH
1048.11
COMBINATION
17-08-035-000
#17389
APPROVED
LORAIN CO.
MAP DEPT.
DATE 4-23-87
PAGE 17-A
BY C. FRANCIS
VOID AFTER 1738