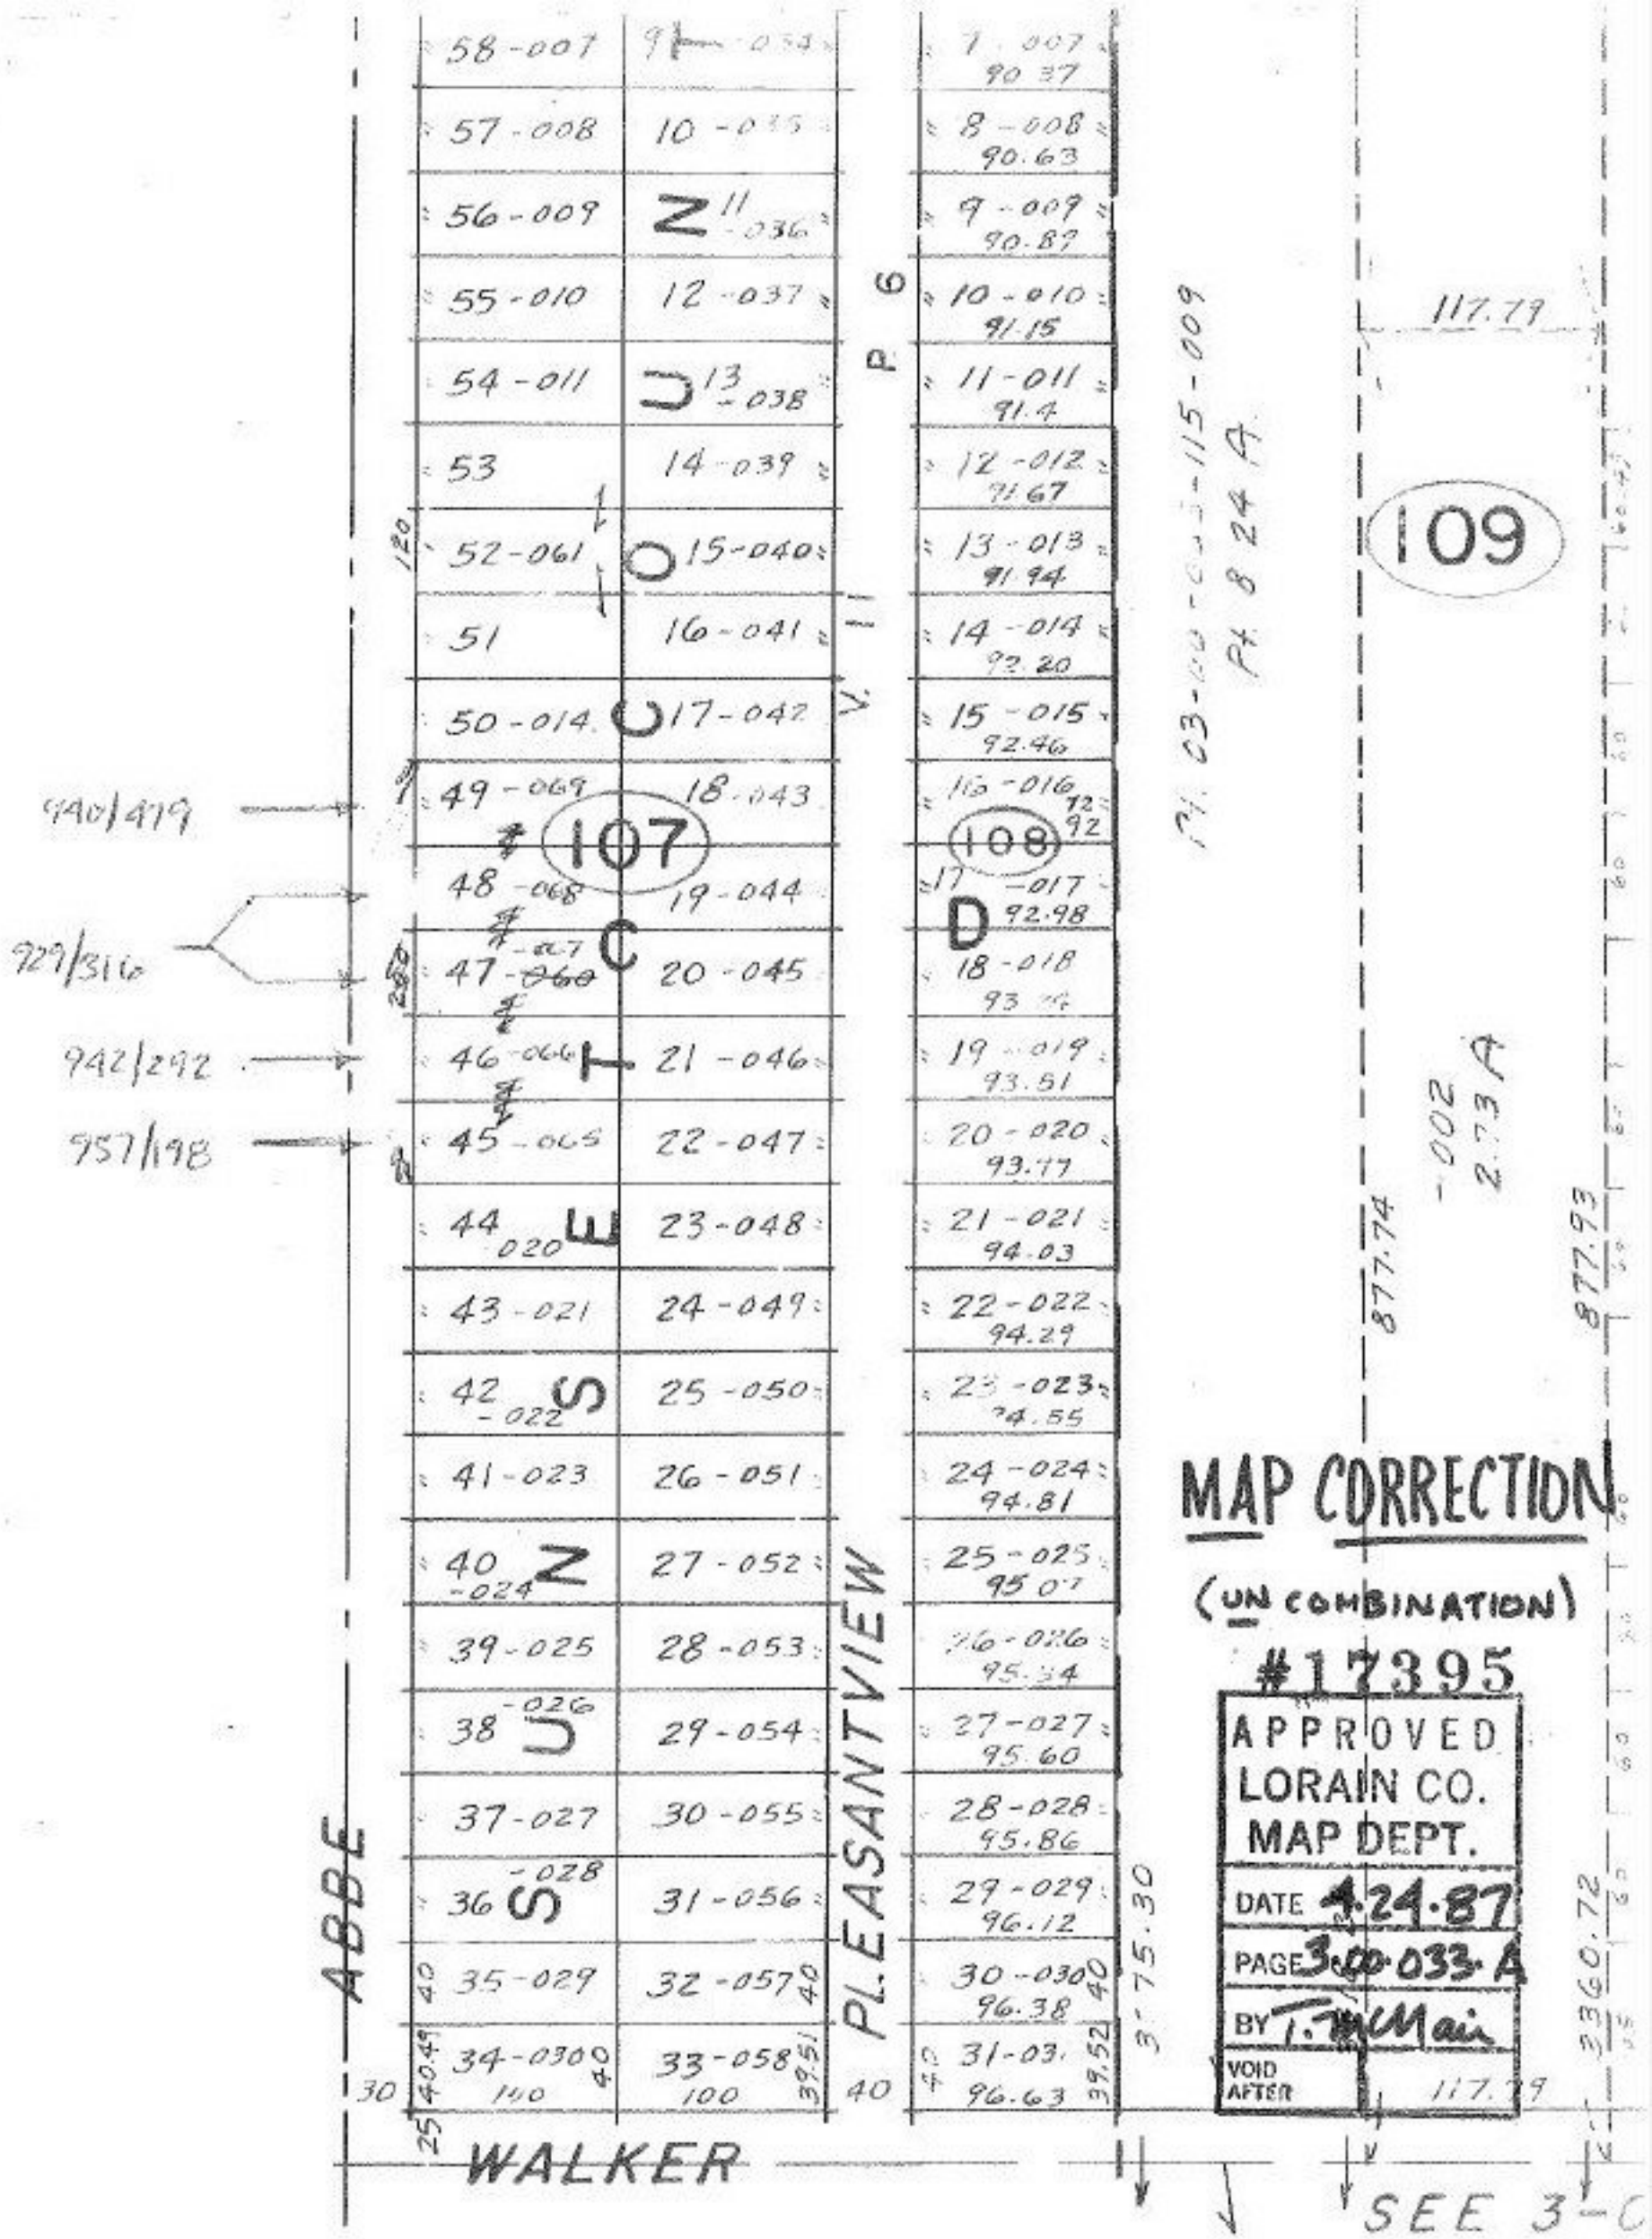

58-007
57-008
56-009
55-010
54-011
53
52-061
51
50-014
49-069
48-068
47-067
46-066
45-065
44-020
43-021
42-022
41-023
40-024
39-025
38-026
37-027
36-028
35-029
34-030
33-058
9-034
10-035
11-036
12-037
13-038
14-039
15-040
16-041
17-042
18-043
19-044
20-045
21-046
22-047
23-048
24-049
25-050
26-051
27-052
28-053
29-054
30-055
31-056
32-057
7-007
90.37
8-008
90.63
9-009
90.89
10-010
91.15
11-011
91.4
12-012
91.67
13-013
91.94
14-014
92.20
15-015
92.46
16-016
17-017
92.98
18-018
19-019
93.51
20-020
93.77
21-021
94.03
22-022
94.29
23-023
94.55
24-024
94.81
25-025
95.07
26-026
95.34
27-027
95.60
28-028
95.86
29-029
96.12
30-030
96.38
31-031
96.63
107
108
109
P 6
V 11
ABBE
PLEASANTVIEW
WALKER
940/479
929/316
942/292
957/198
117.79
877.74
877.93
3360.72
3-75.30
Pt. 8 24 A
-002
2.73 A
MAP CORRECTION
(UN COMBINATION)
#17395
APPROVED
LORAIN CO.
MAP DEPT.
DATE 4.24.87
PAGE 3.00.033.A
BY T. McMain
VOID AFTER
117.79
SEE 3-C