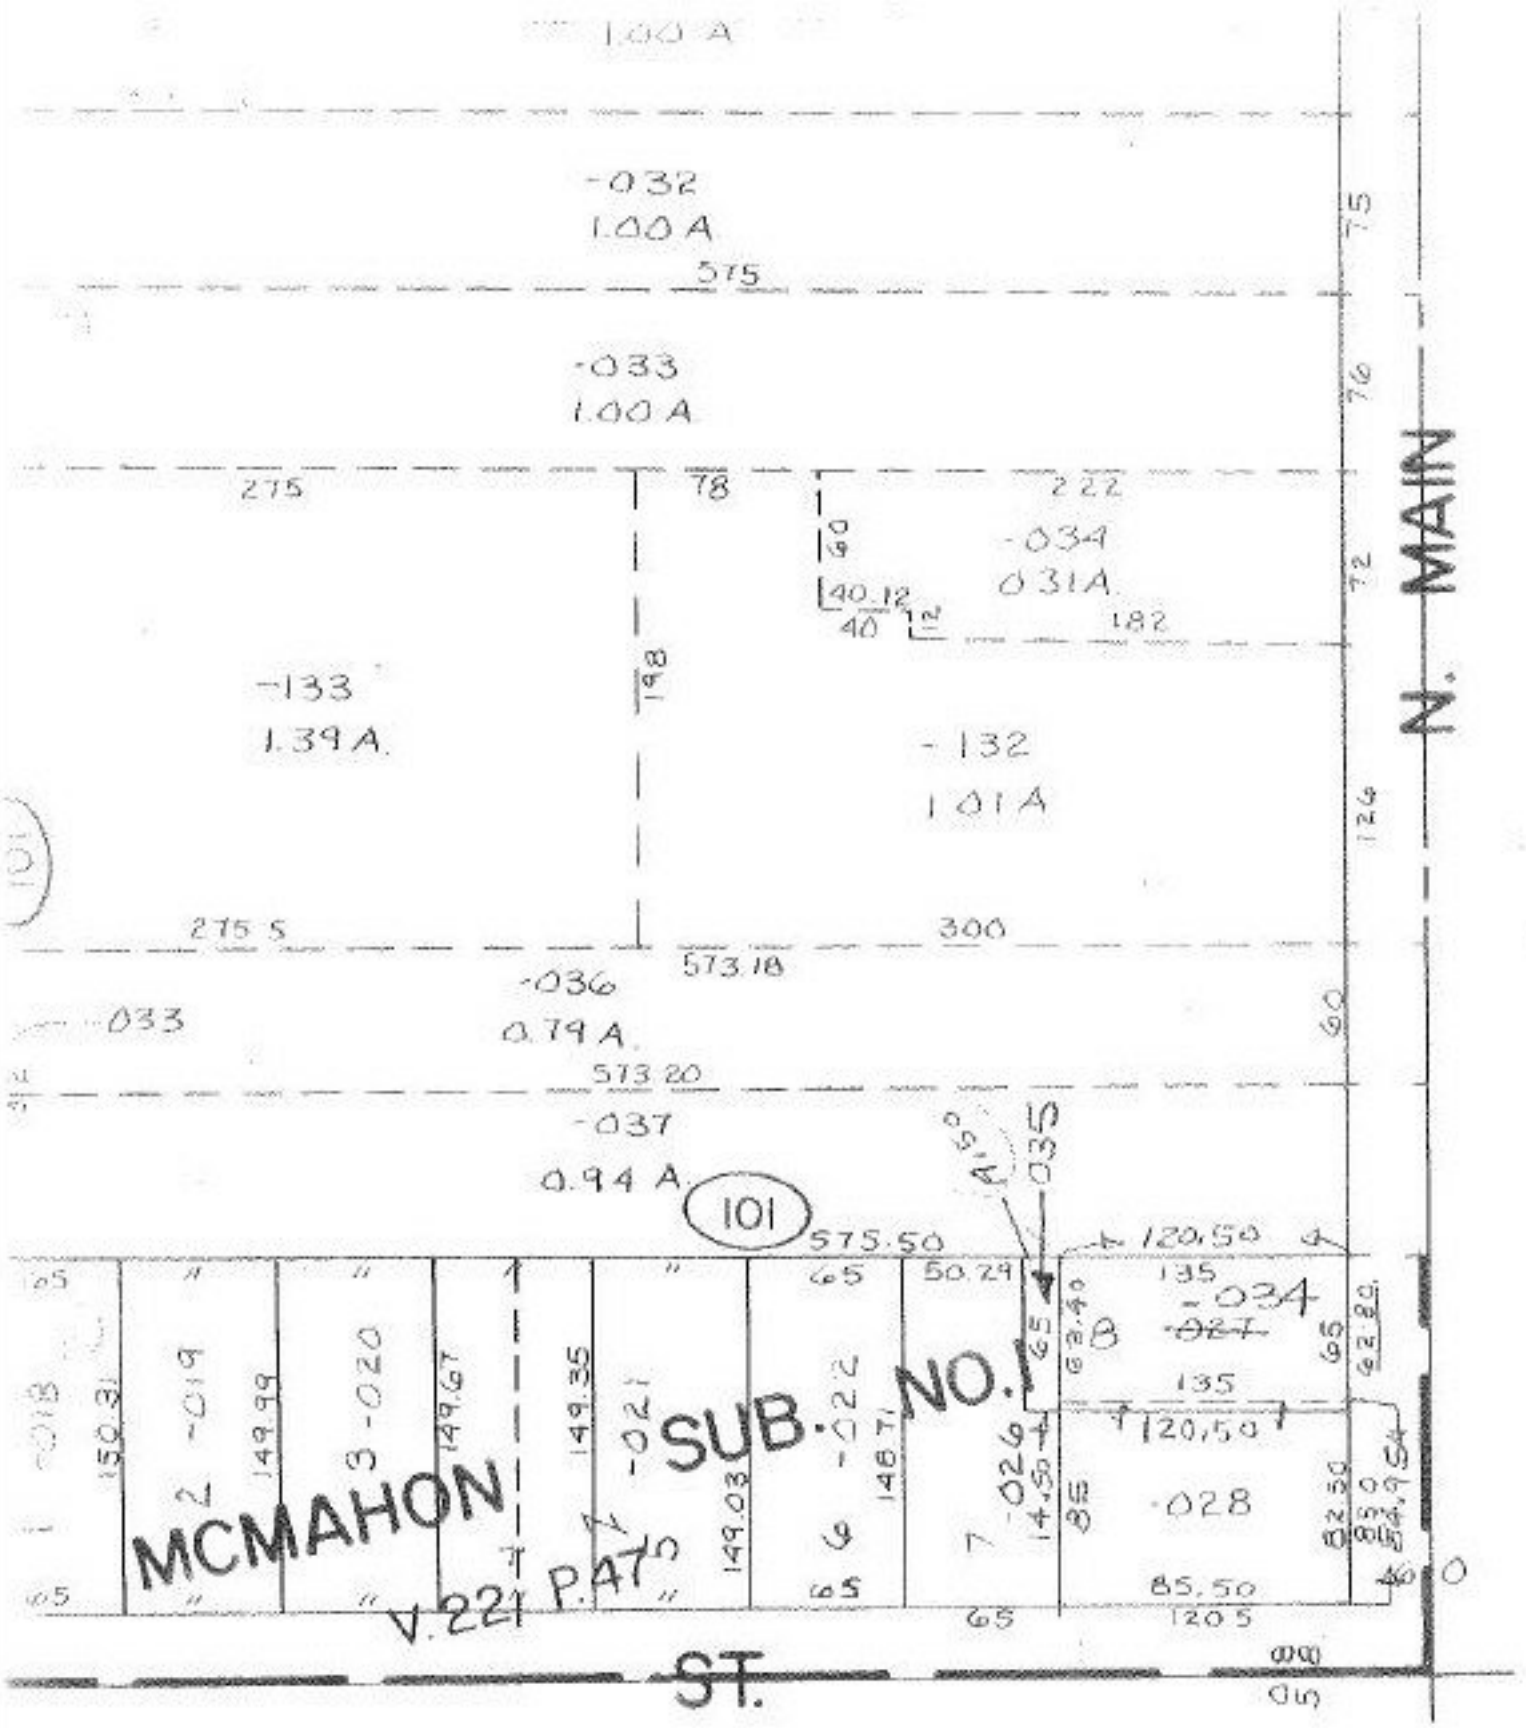

18-00-028-103-
PRIOR DEED
Survey Bk. K.S.A
C=1:1000000

Deed

#17401
S. Coughlin
01-30-87
APPROVED
LORAIN CO.
MAP DEPT.
DATE 4-30-87
PAGE 18-00-028 B
BY C. Francis
VOID AFTER 17401

REVISED 8-1-86

NE 1/4 LOTS 28

18-00-028-B