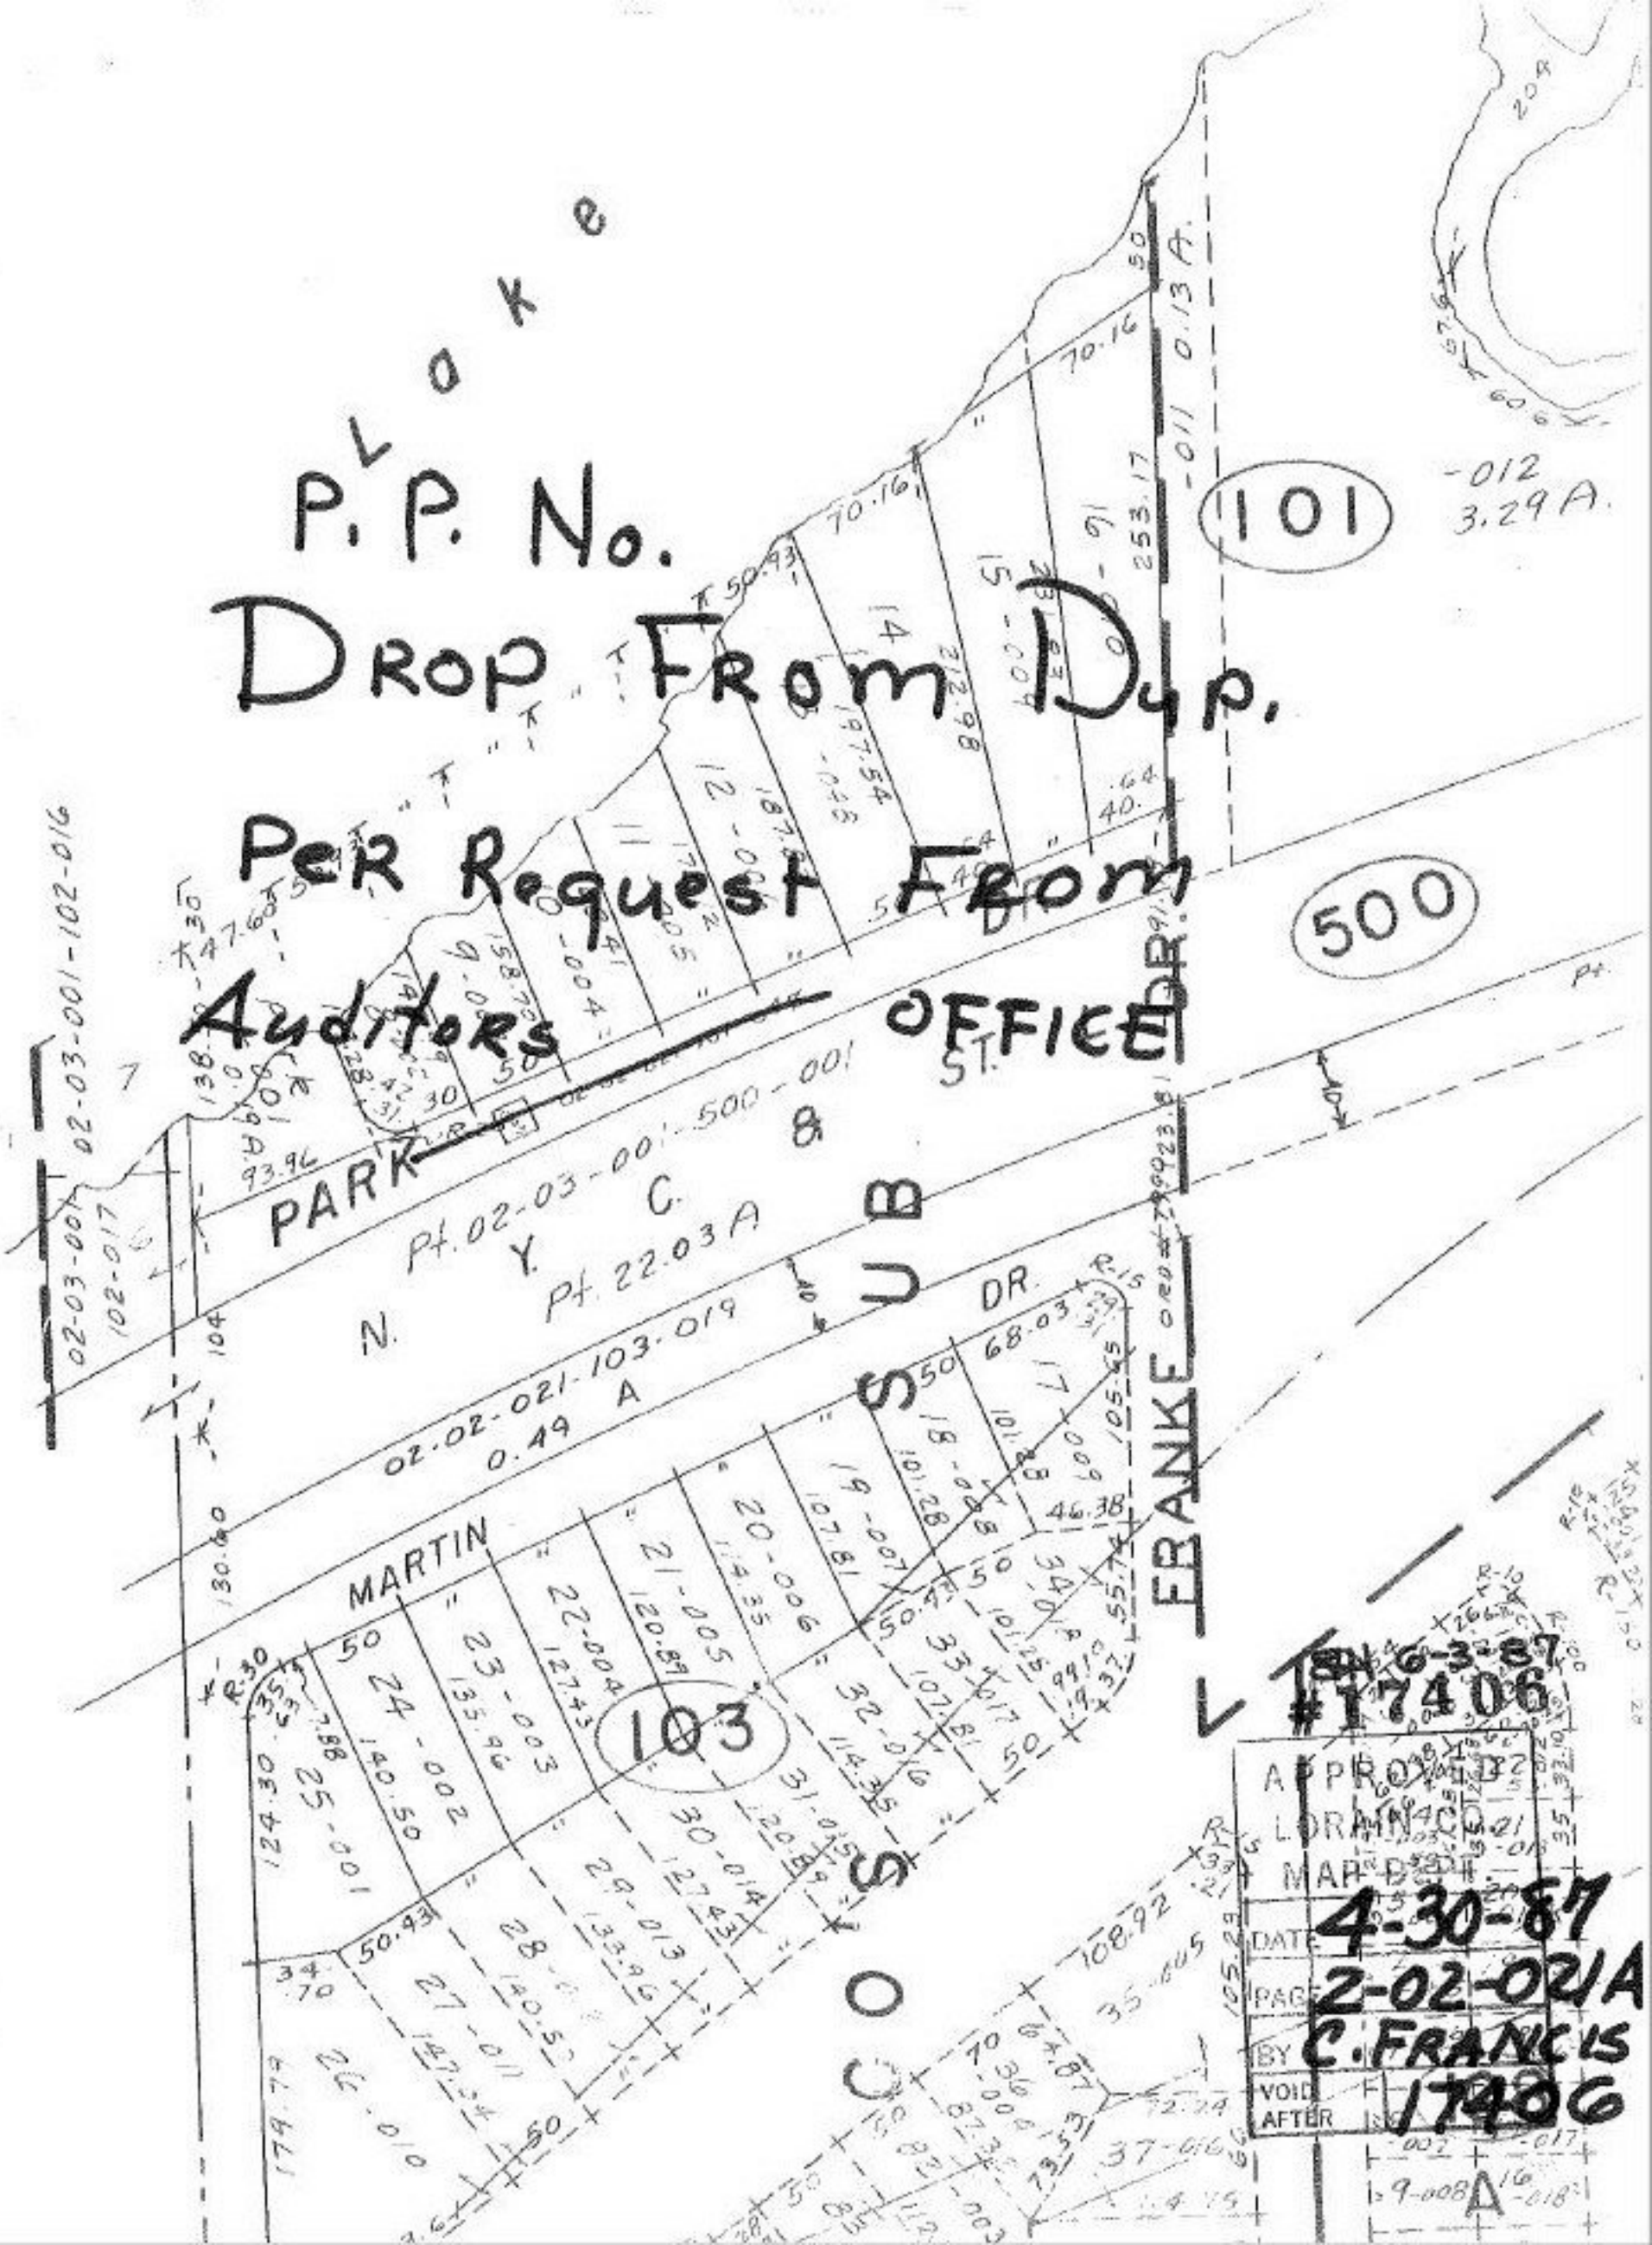

P.P. No.
Drop From Dup.
Per Request From
Auditors OFFICE
Lake
101
500
103
PARK
N. Y. C. Pt. 22.03 A
Pt. 02-03-001-500-001
02-02-021-103-019
0.49 A
MARTIN
FRANKE
SUB
COS
DR.
ST.
-012
3.29 A.
-011 0.13 A.
02-03-001-102-016
02-03-001
102-017
BK 6-3-87
#17406
APPROVED
LORAIN CO.
MAP DEPT.
DATE 4-30-87
PAGE 2-02-021A
BY C. FRANCIS
VOID AFTER 17406