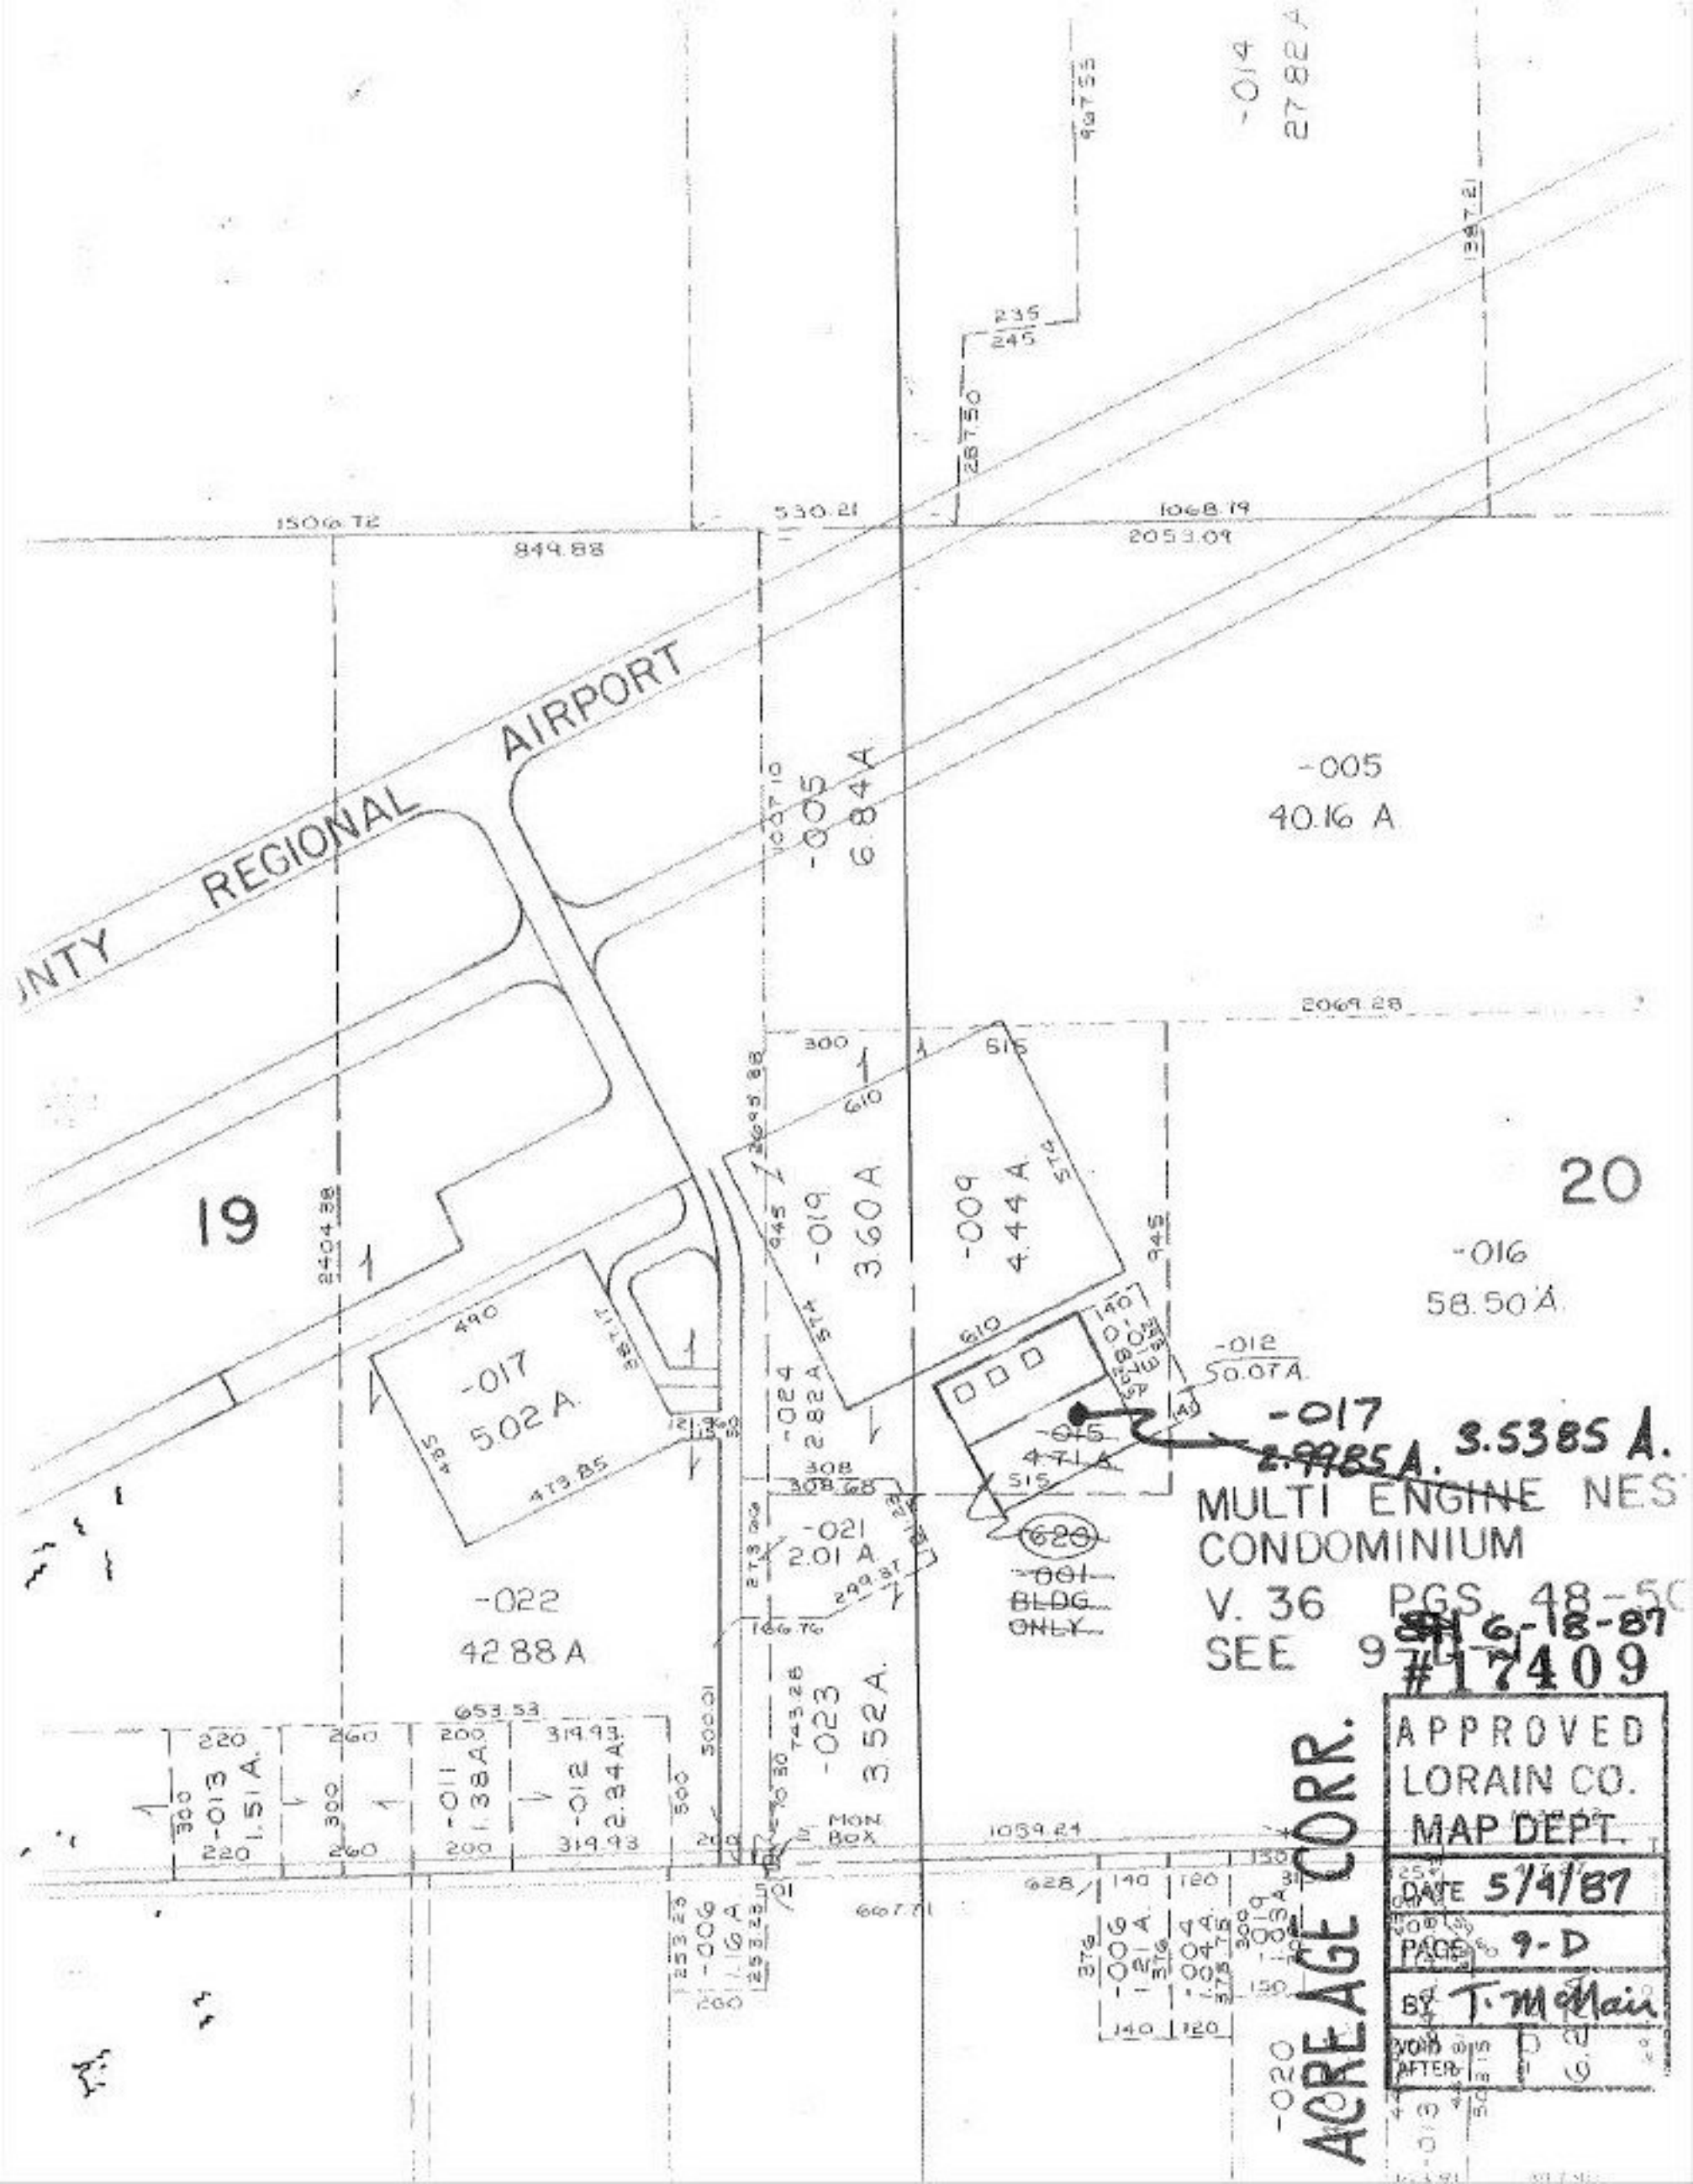

-014
27.82 A
967.55
1387.21
235
245
287.50
1506.72
530.21
1068.19
849.88
2053.09
REGIONAL AIRPORT
-005
6.84 A
-005
40.16 A
2069.28
300
515
610
19
20
-019
3.60 A
-009
4.44 A
-016
58.50 A
-017
5.02 A
-024
2.82 A
-012
50.07 A
-017
2.9985 A.
3.5385 A.
-015
4.71 A
MULTI ENGINE NES
CONDOMINIUM
V. 36 PGS. 48-50
SEE 9-D
-021
2.01 A
-022
42.88 A
-001
BLDG
ONLY
-023
3.52 A
-013
1.51 A
-011
1.38 A
-012
2.34 A
MON BOX
1059.24
-006
1.16 A
-020
ACREAGE CORR.
APPROVED
LORAIN CO.
MAP DEPT.
DATE 5/4/87
PAGE 9-D
BY T. McMain
VOID AFTER