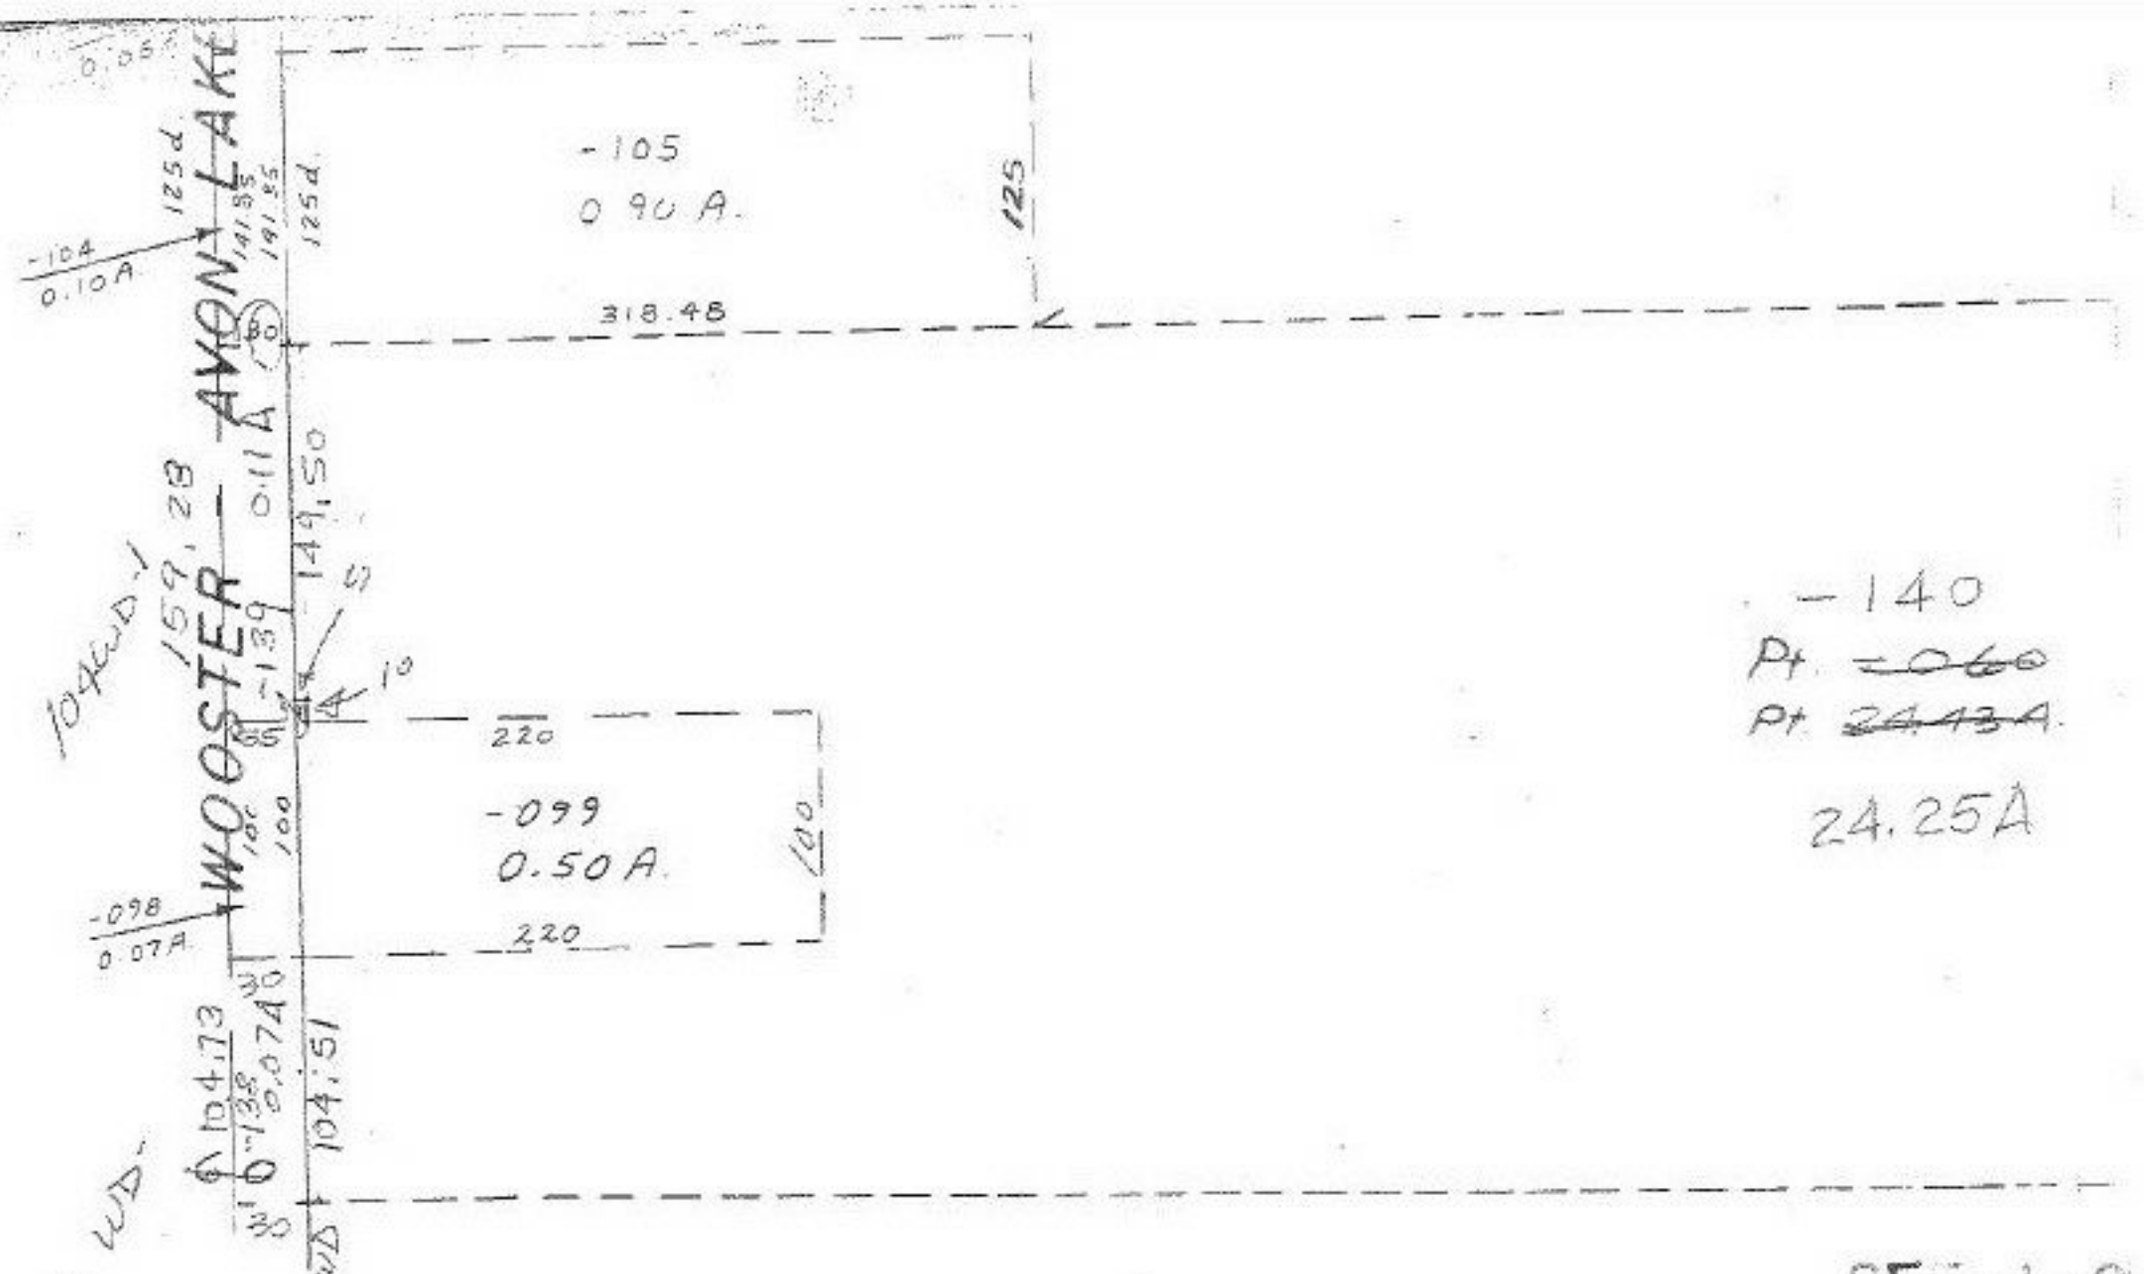

5-19-87

SH 6-10-87
#17411

APPROVED
LORAIN CO.
MAP DEPT.
DATE 5-5-87
PAGE 4-00-017 C
BY C. FRANCIS
VOID AFTER 17411

St. R. 83
Albion Dr.
T. P. G.
544.65
749.58

04-00-017-103
PRIOR DEED 677-14
782-678-9
St. 83 W/D 104 C=1: 142857.
W/D-1-104 C=1: 200000
C=1:

W 1/2 NE 1/4 SEC. 17

-017-C