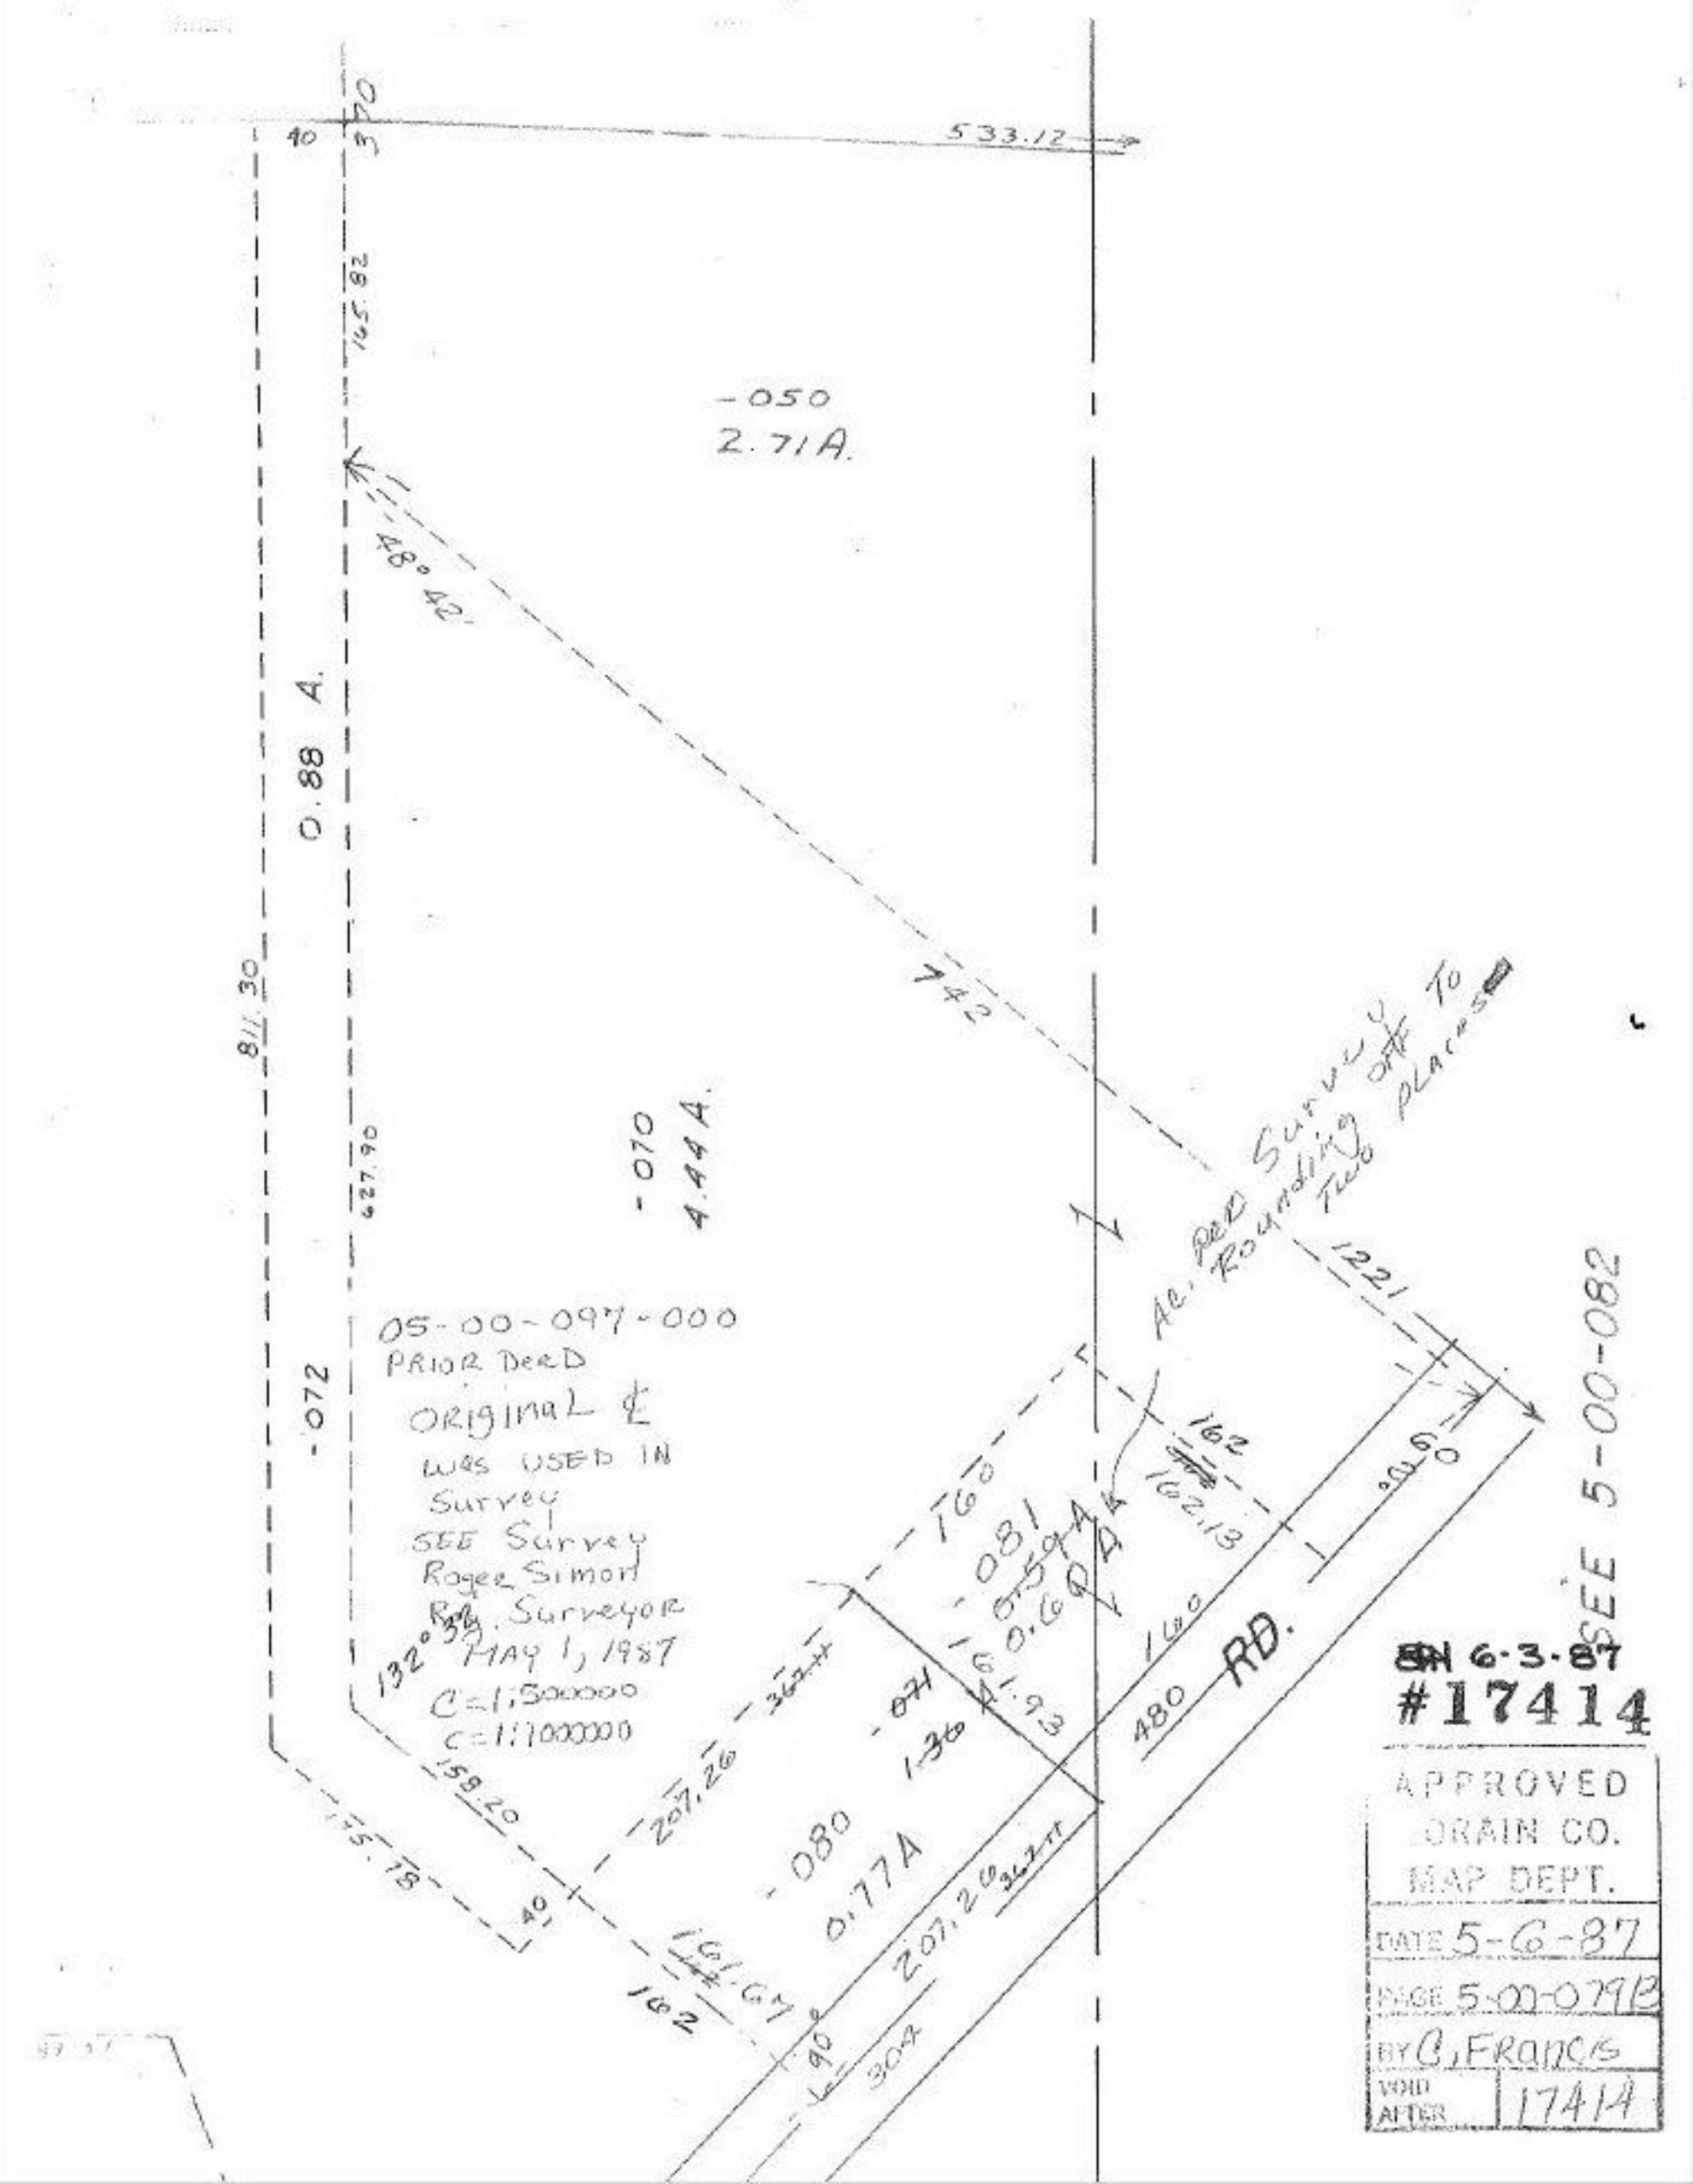

SN 6-3-87
#17414

APPROVED
DRAIN CO.
MAP DEPT.
DATE 5-6-87
PAGE 5-00-079B
BY C. Francis
VOID AFTER 17414