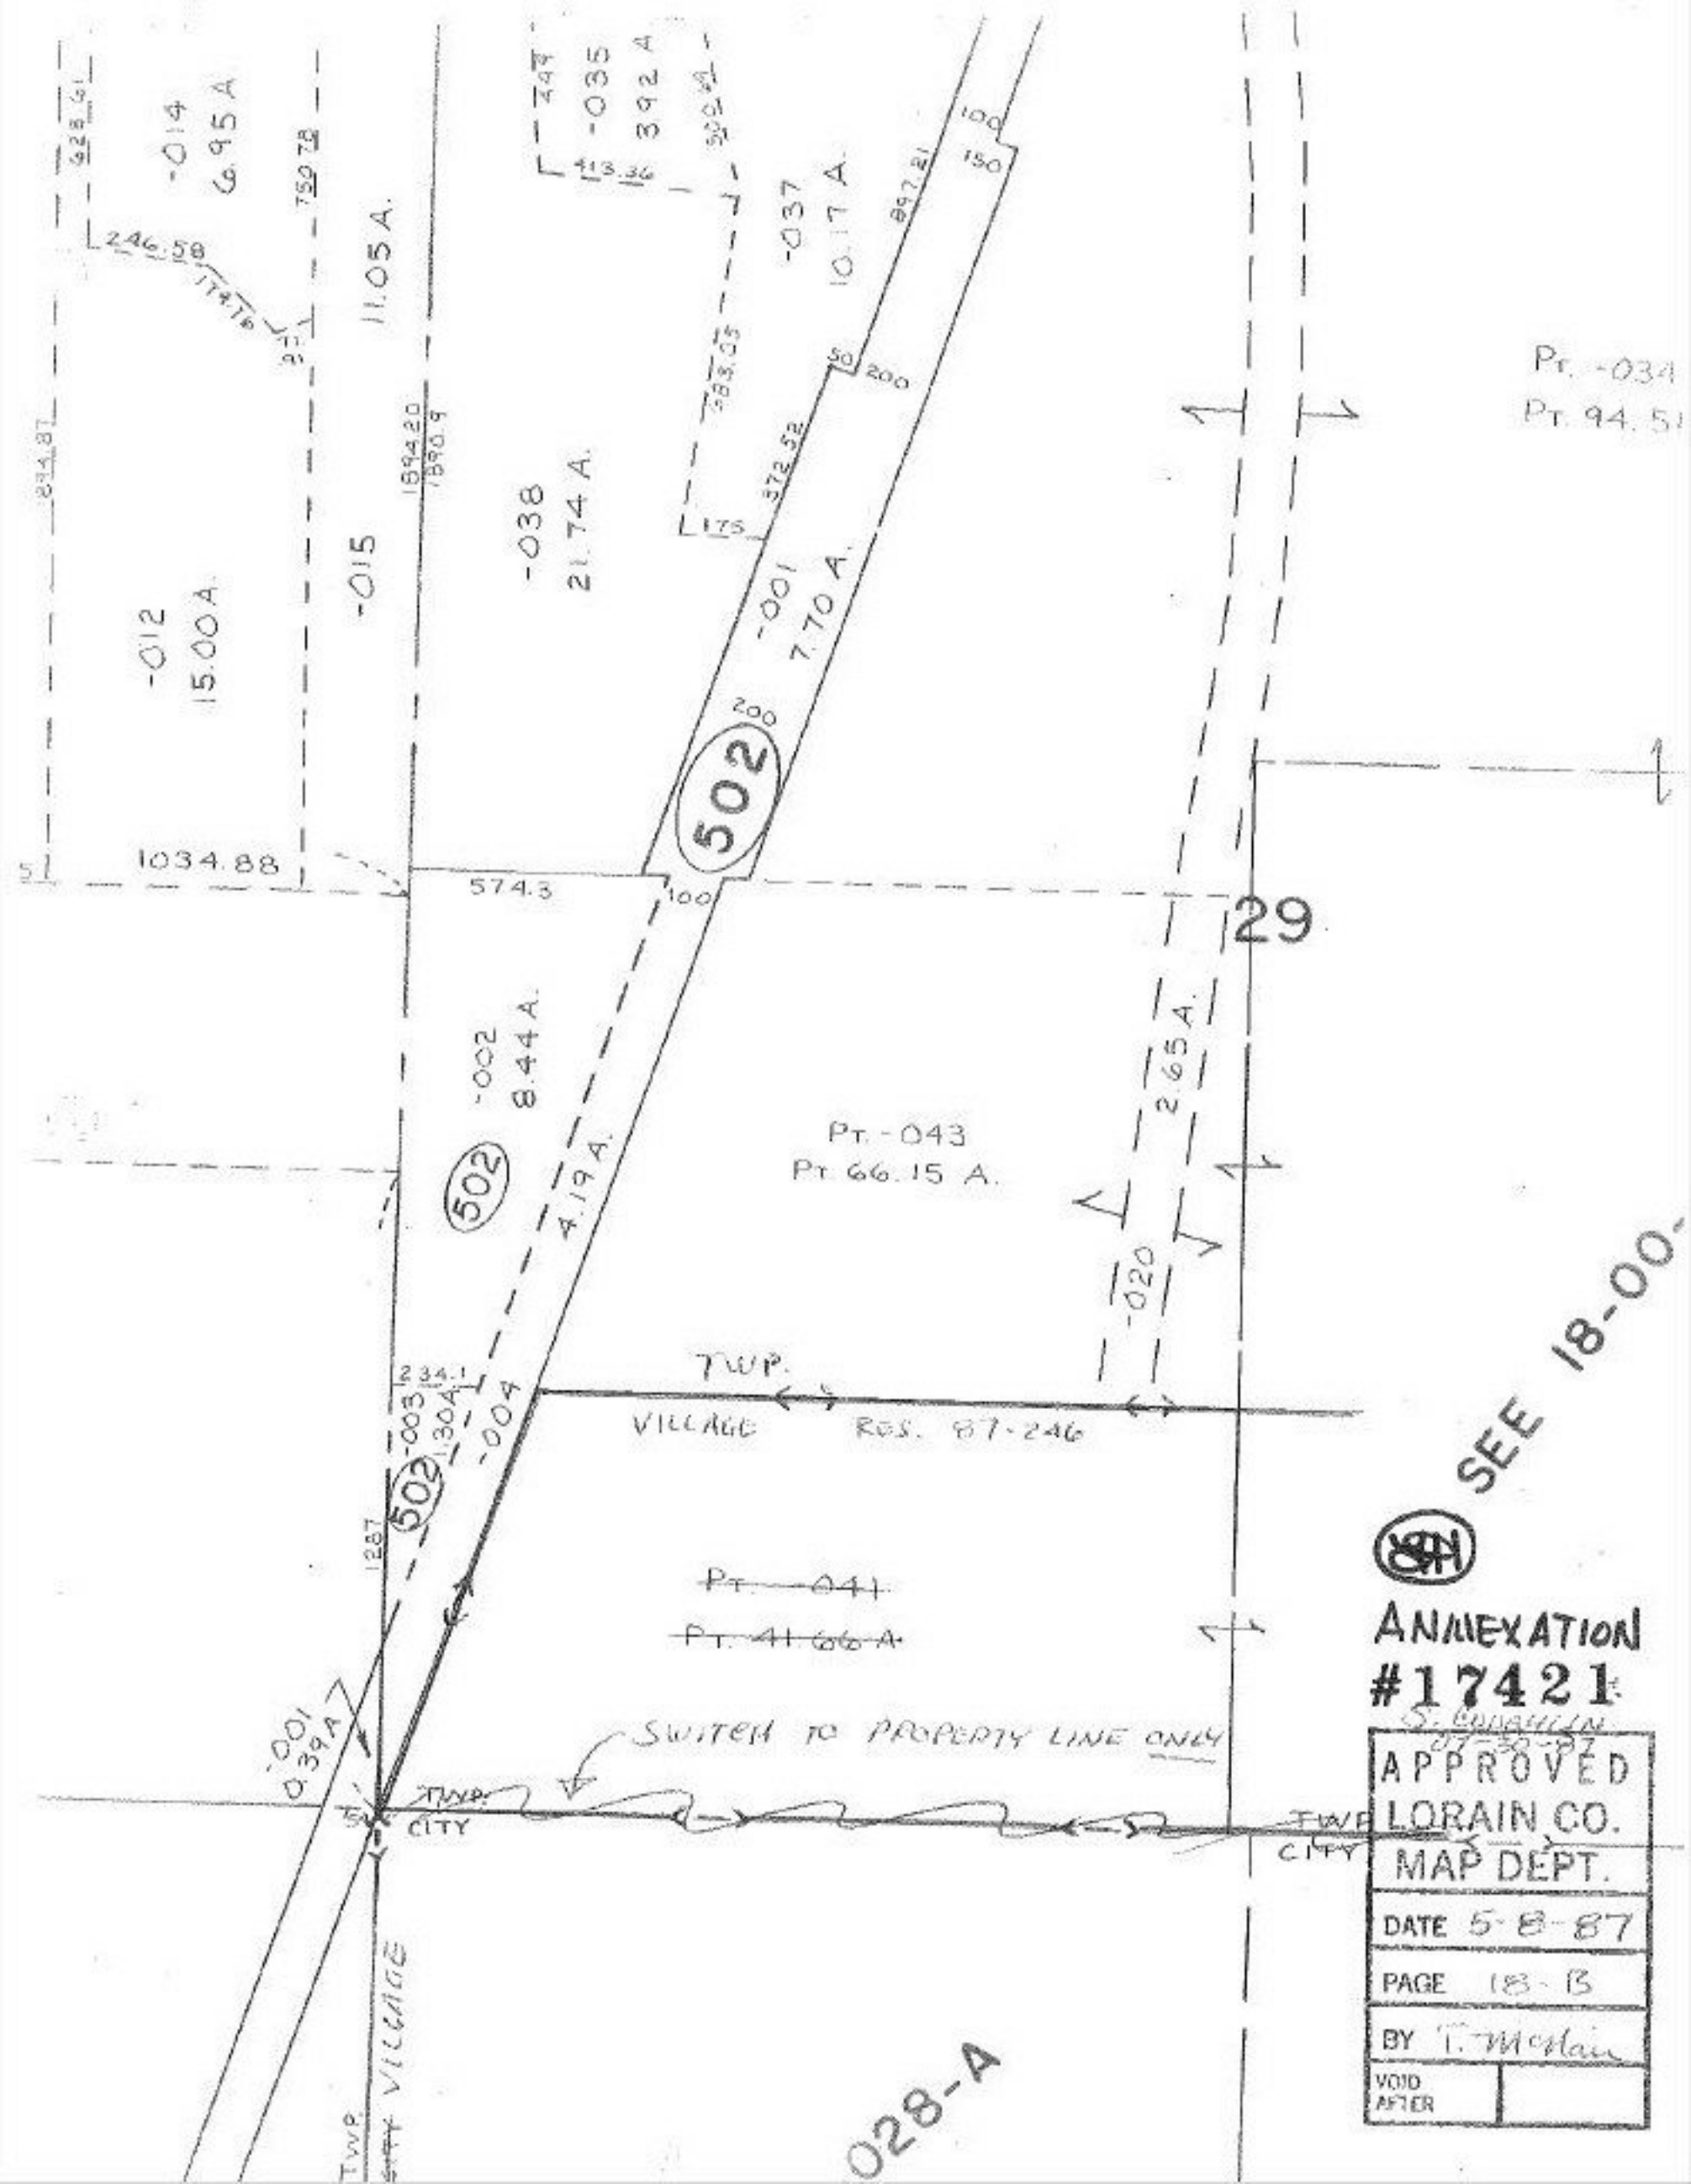

-014
6.95 A
-035
392 A
-037
10.17 A
11.05 A.
-015
-038
21.74 A.
-012
15.00 A.
-001
7.70 A.
502
1034.88
574.3
29
-002
8.44 A.
4.19 A.
Pt. -043
Pt. 66.15 A.
2.65 A.
-020
TWP.
VILLAGE
RES. 87-246
-004
-003
1.30 A.
Pt. -041
Pt. 41.66 A
SWITCH TO PROPERTY LINE ONLY
-001
0.39 A
TWP.
CITY
VILLAGE
SEE 18-00-
028-A
Pt. -034
Pt. 94.51
ANNEXATION
#17421
APPROVED
LORAIN CO.
MAP DEPT.
DATE 5-8-87
PAGE 18-B
BY T. McHain
VOID AFTER