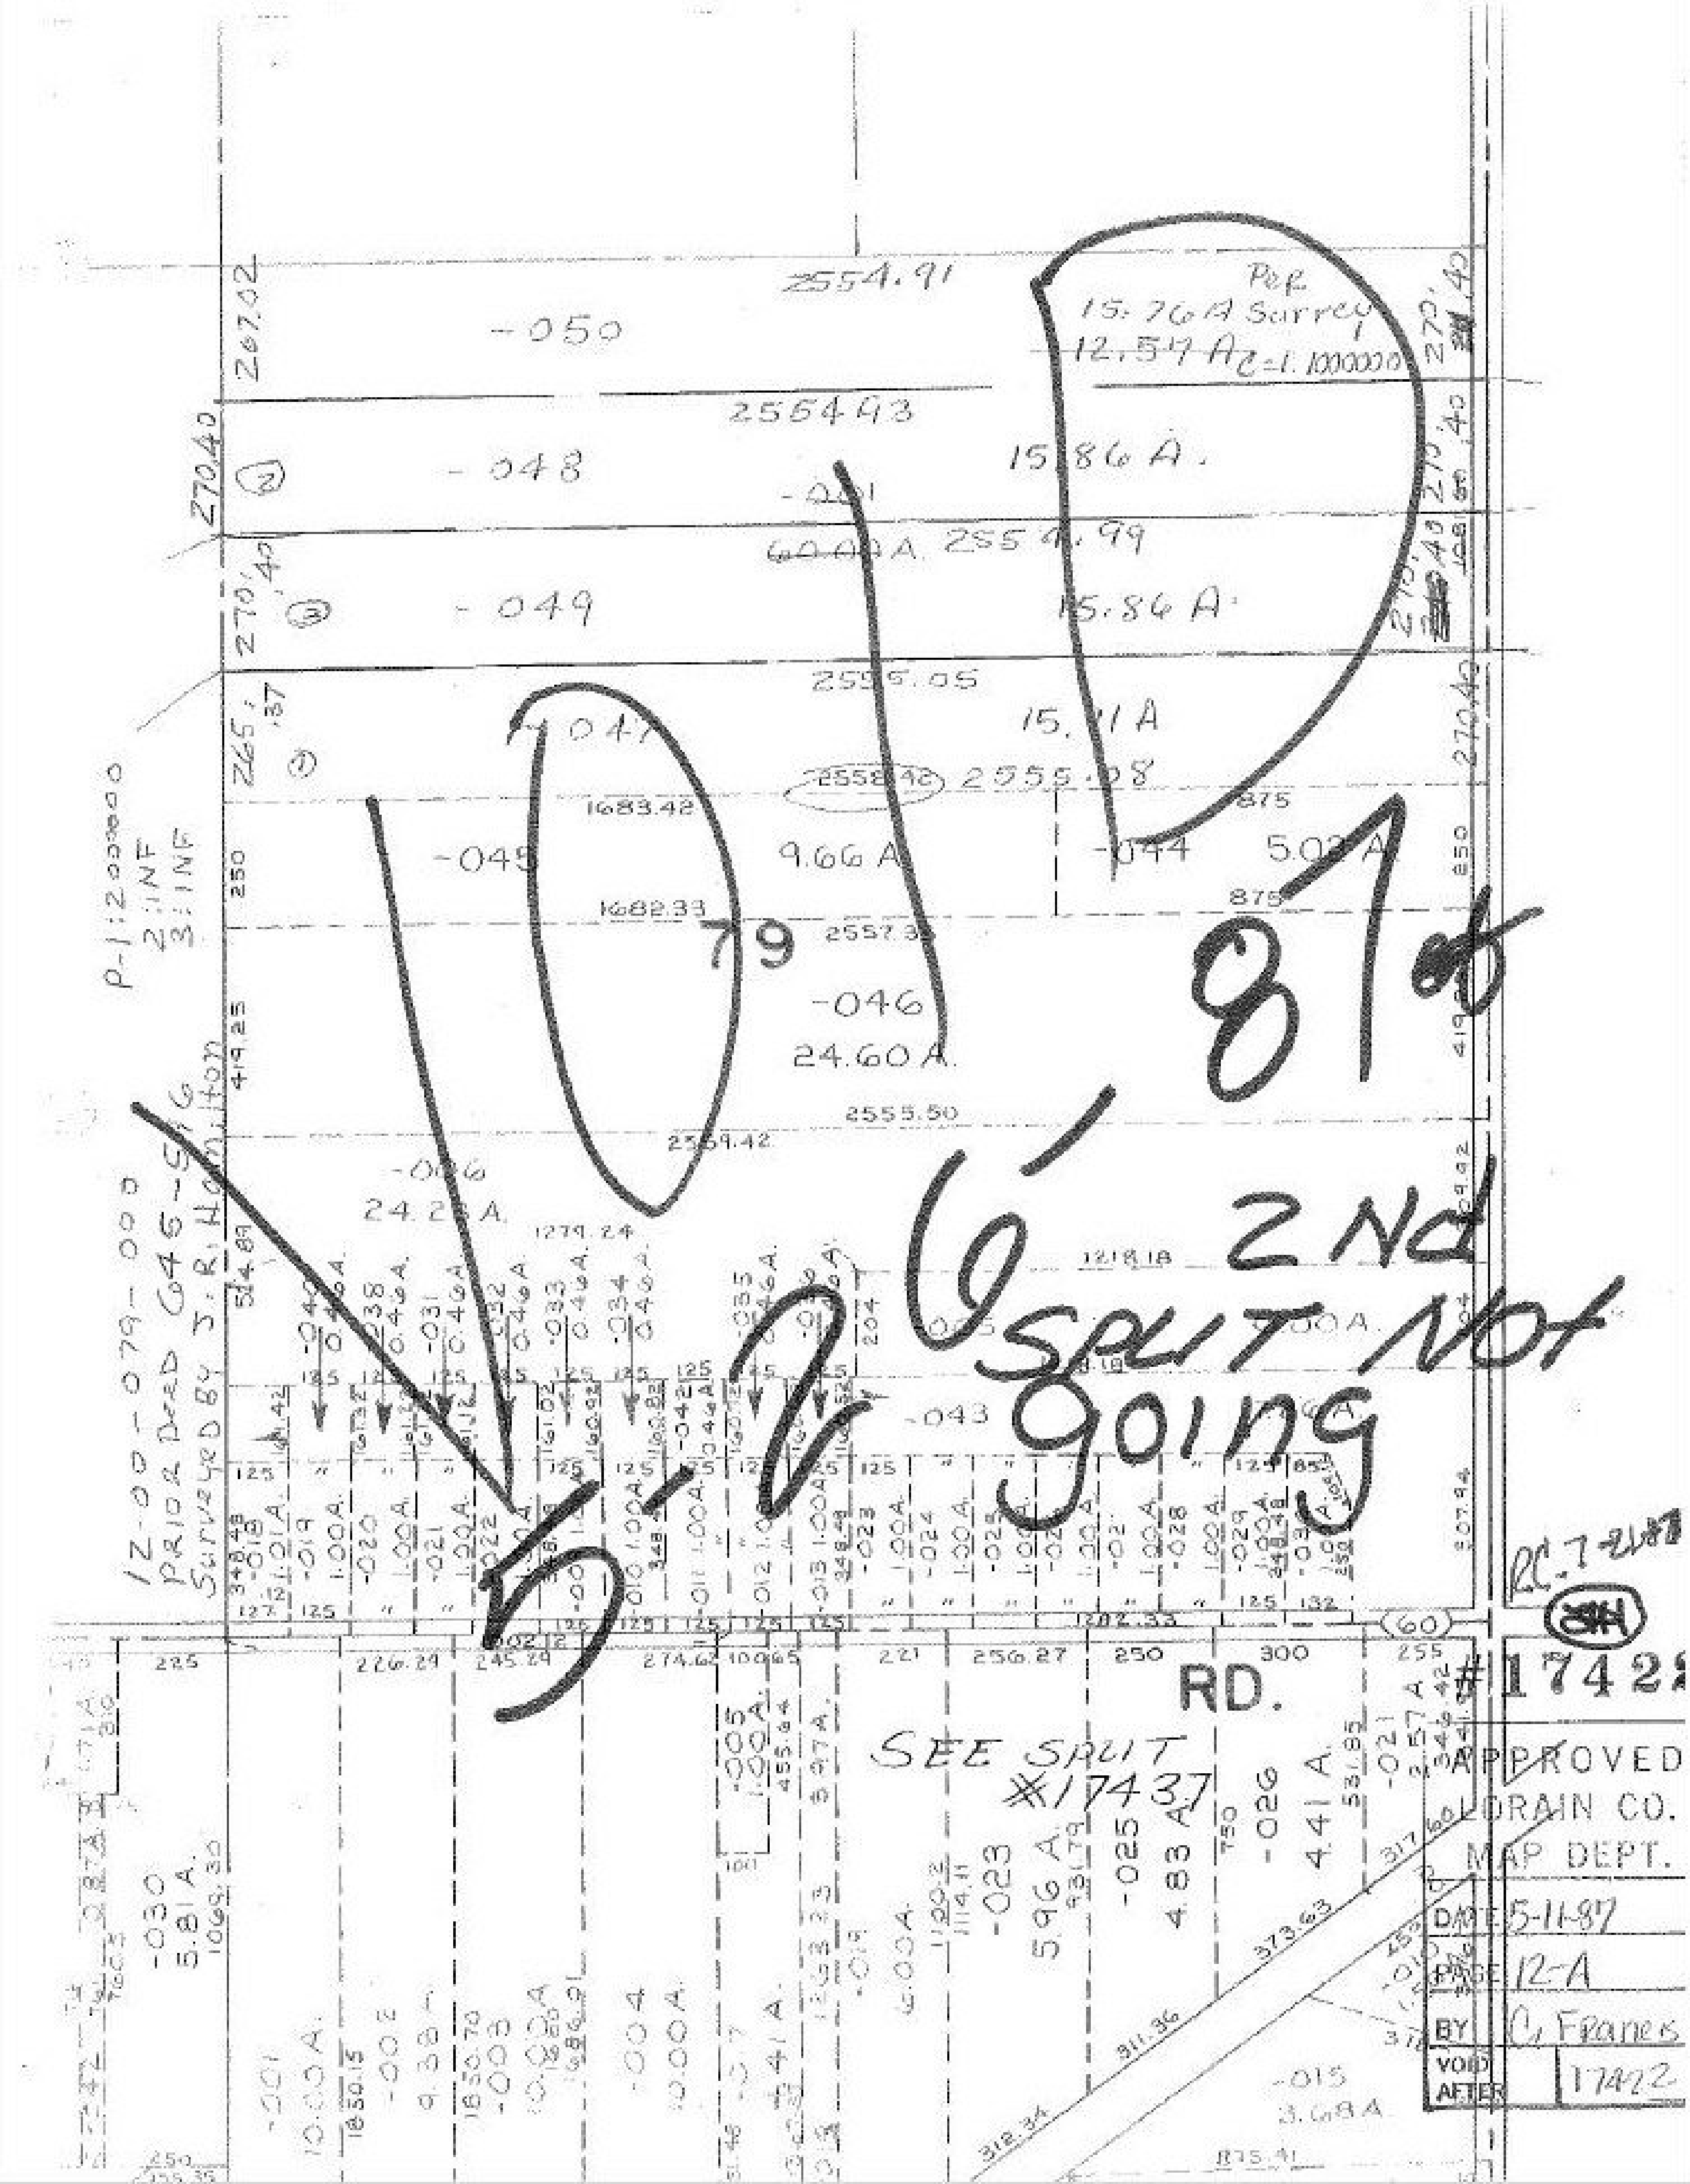

2554.91
-050
Par 15.76 A Survey
12.59 A
2554.93
-048
15.86 A.
2554.99
-049
15.86 A.
2555.05
-047
15.71 A
2558.42
2555.08
1683.42
-045
9.66 A
-044
5.02 A
875
1682.33
2557.33
-046
24.60 A.
2555.50
2559.42
-006
24.23 A.
1279.24
1218.18
-043
P-1:1.2000000
2:INF
3:INF
12-00-079-000
Prior Deed 646-516
Surveyed by J. R. Hamilton
1202.33
60
RD.
SEE SPLIT #17437
-030
5.81 A.
-023
5.96 A.
-025
4.83 A.
-026
4.41 A.
-021
-015
3.68 A.
#17422
APPROVED
LORAIN CO.
MAP DEPT.
DATE 5-11-87
PAGE 12-A
BY C. Franks
VOID AFTER 17422
RC. 7-21-87
5-2
79
6-87
2nd SPLIT Not going