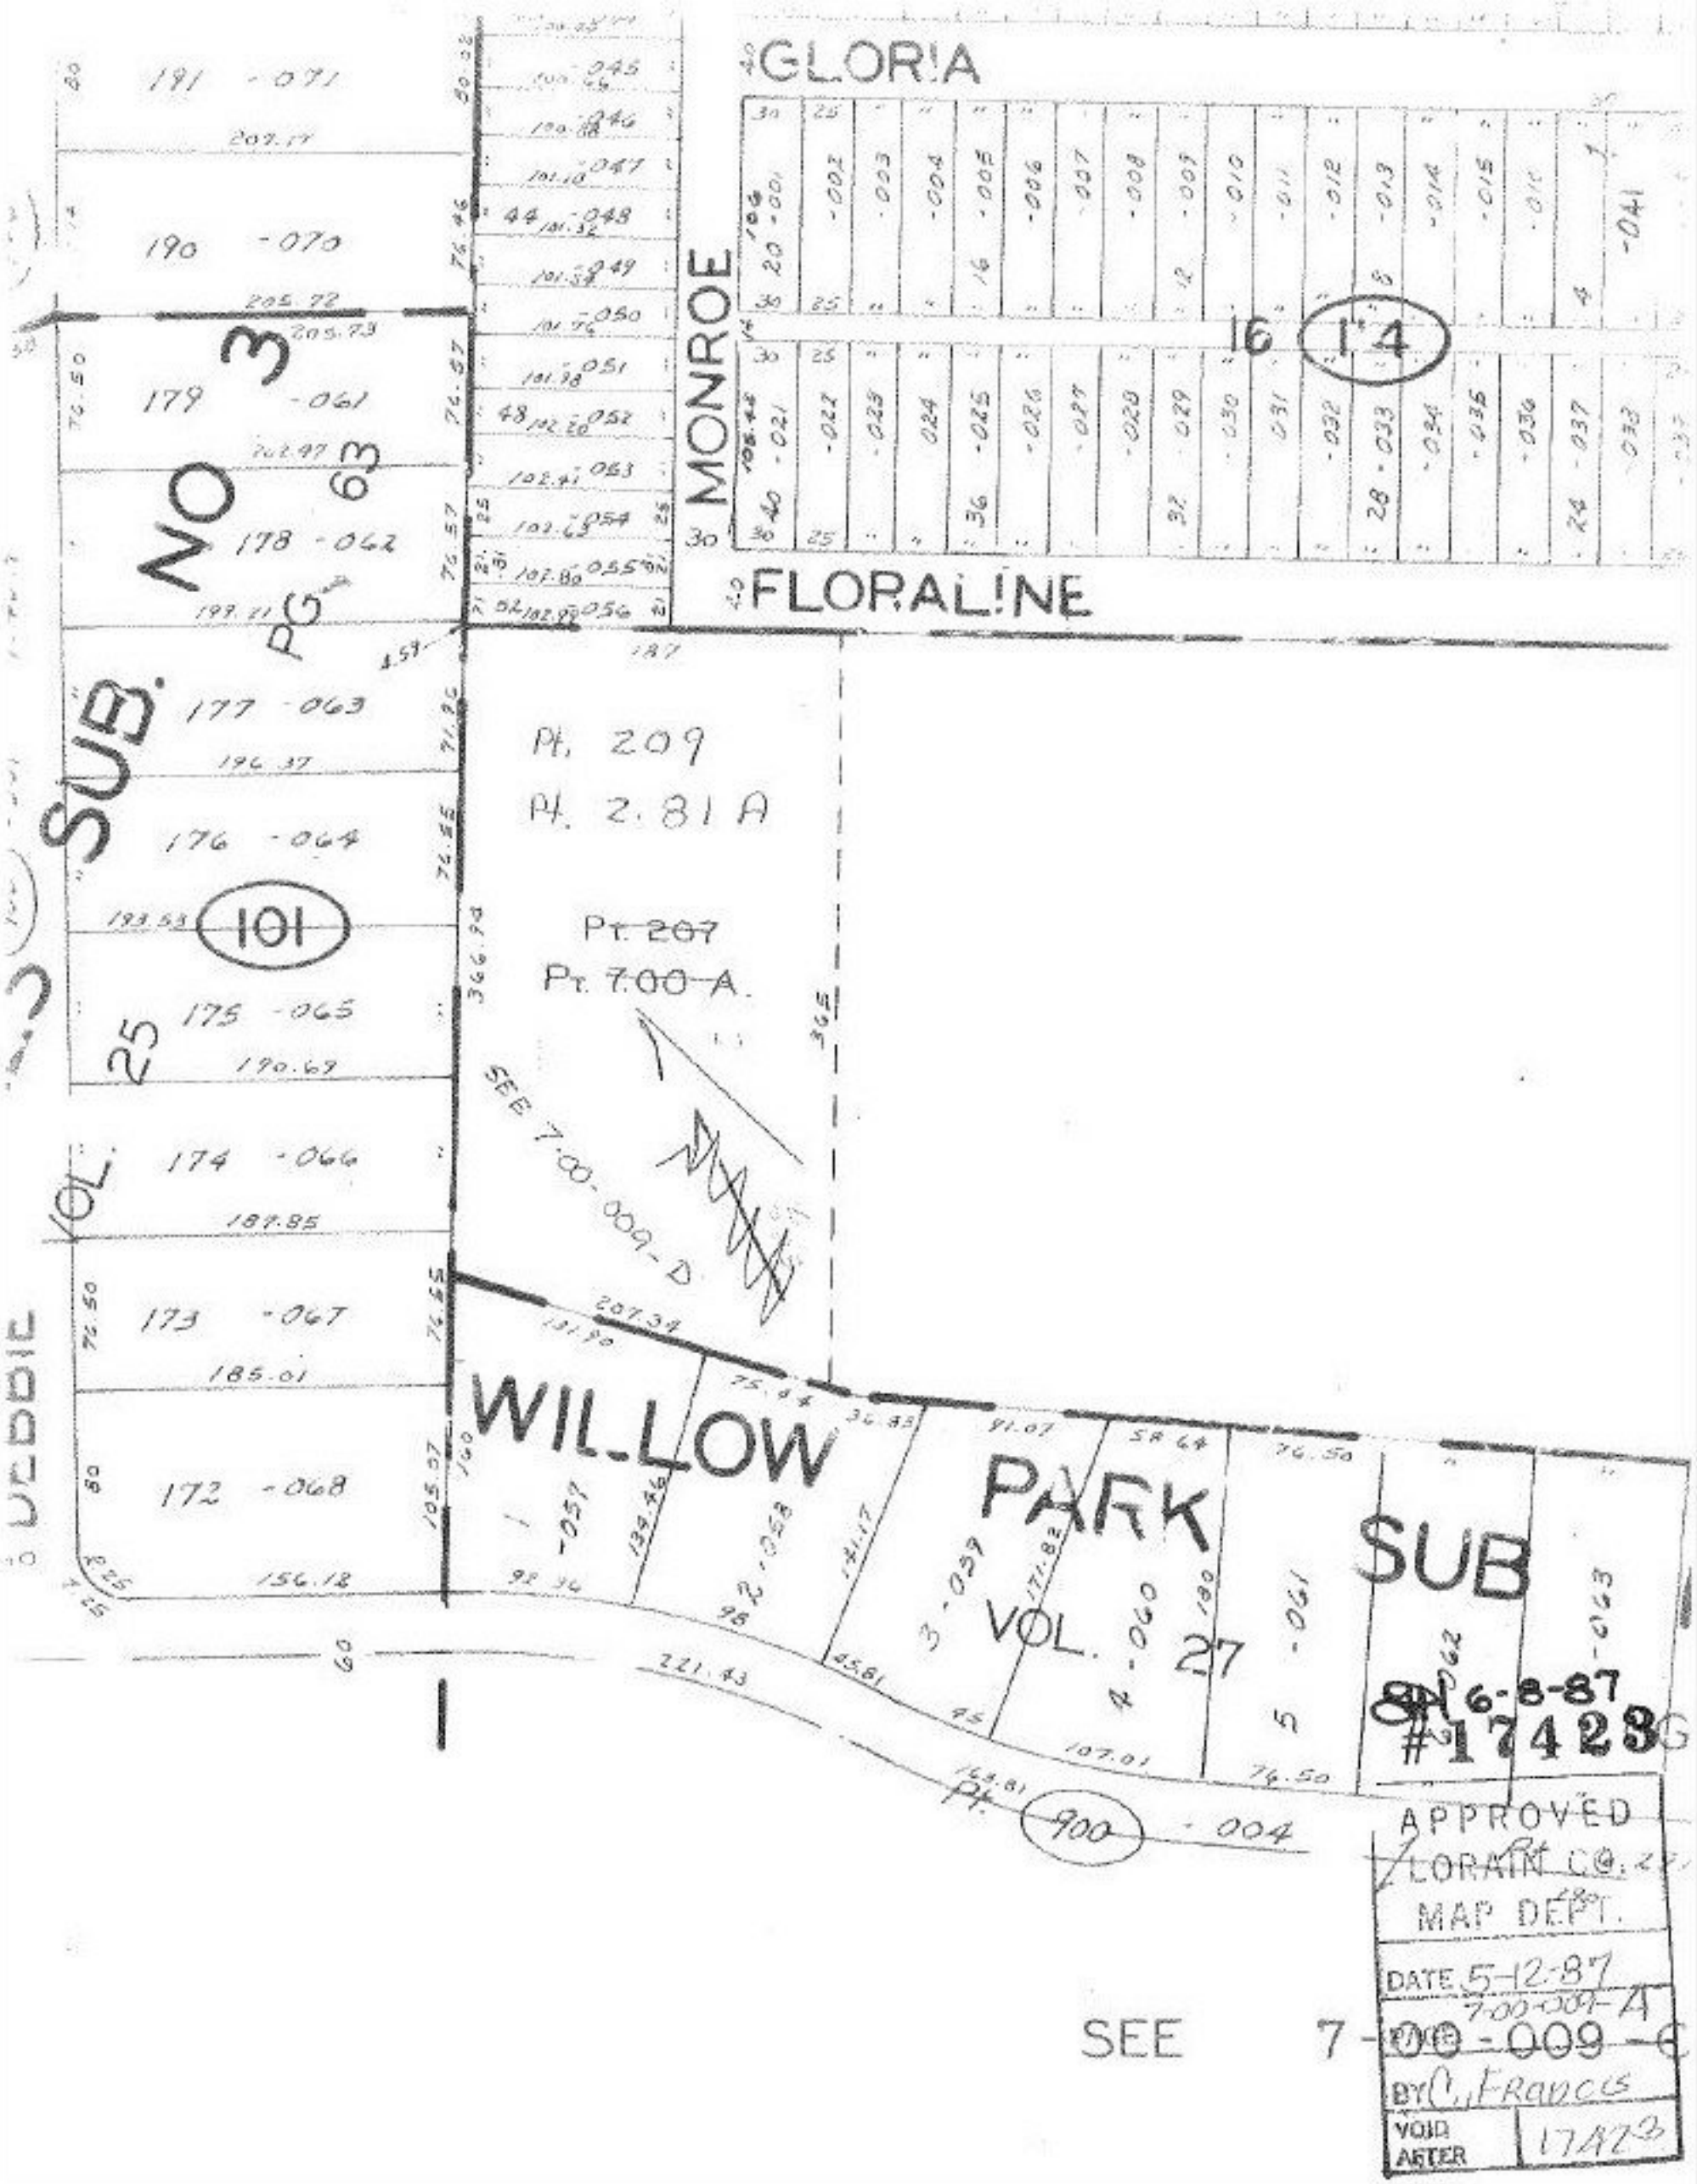
GLORIA
MONROE
FLORALINE
16
14
SUB. NO 3
PG 63
101
25
VOL.
DEBBIE
Pt. 209
Pt. 2.81 A
Pt. 207
Pt. 7.00 A.
SEE 7-00-009-D
WILLOW PARK SUB
VOL. 27
Pt. 900 - 004
SEE 7-00-009-C
6-8-87
#17423
APPROVED
LORAIN CO.
MAP DEPT.
DATE 5-12-87
7-00-009-A
BY C. Francis
VOID AFTER 17423