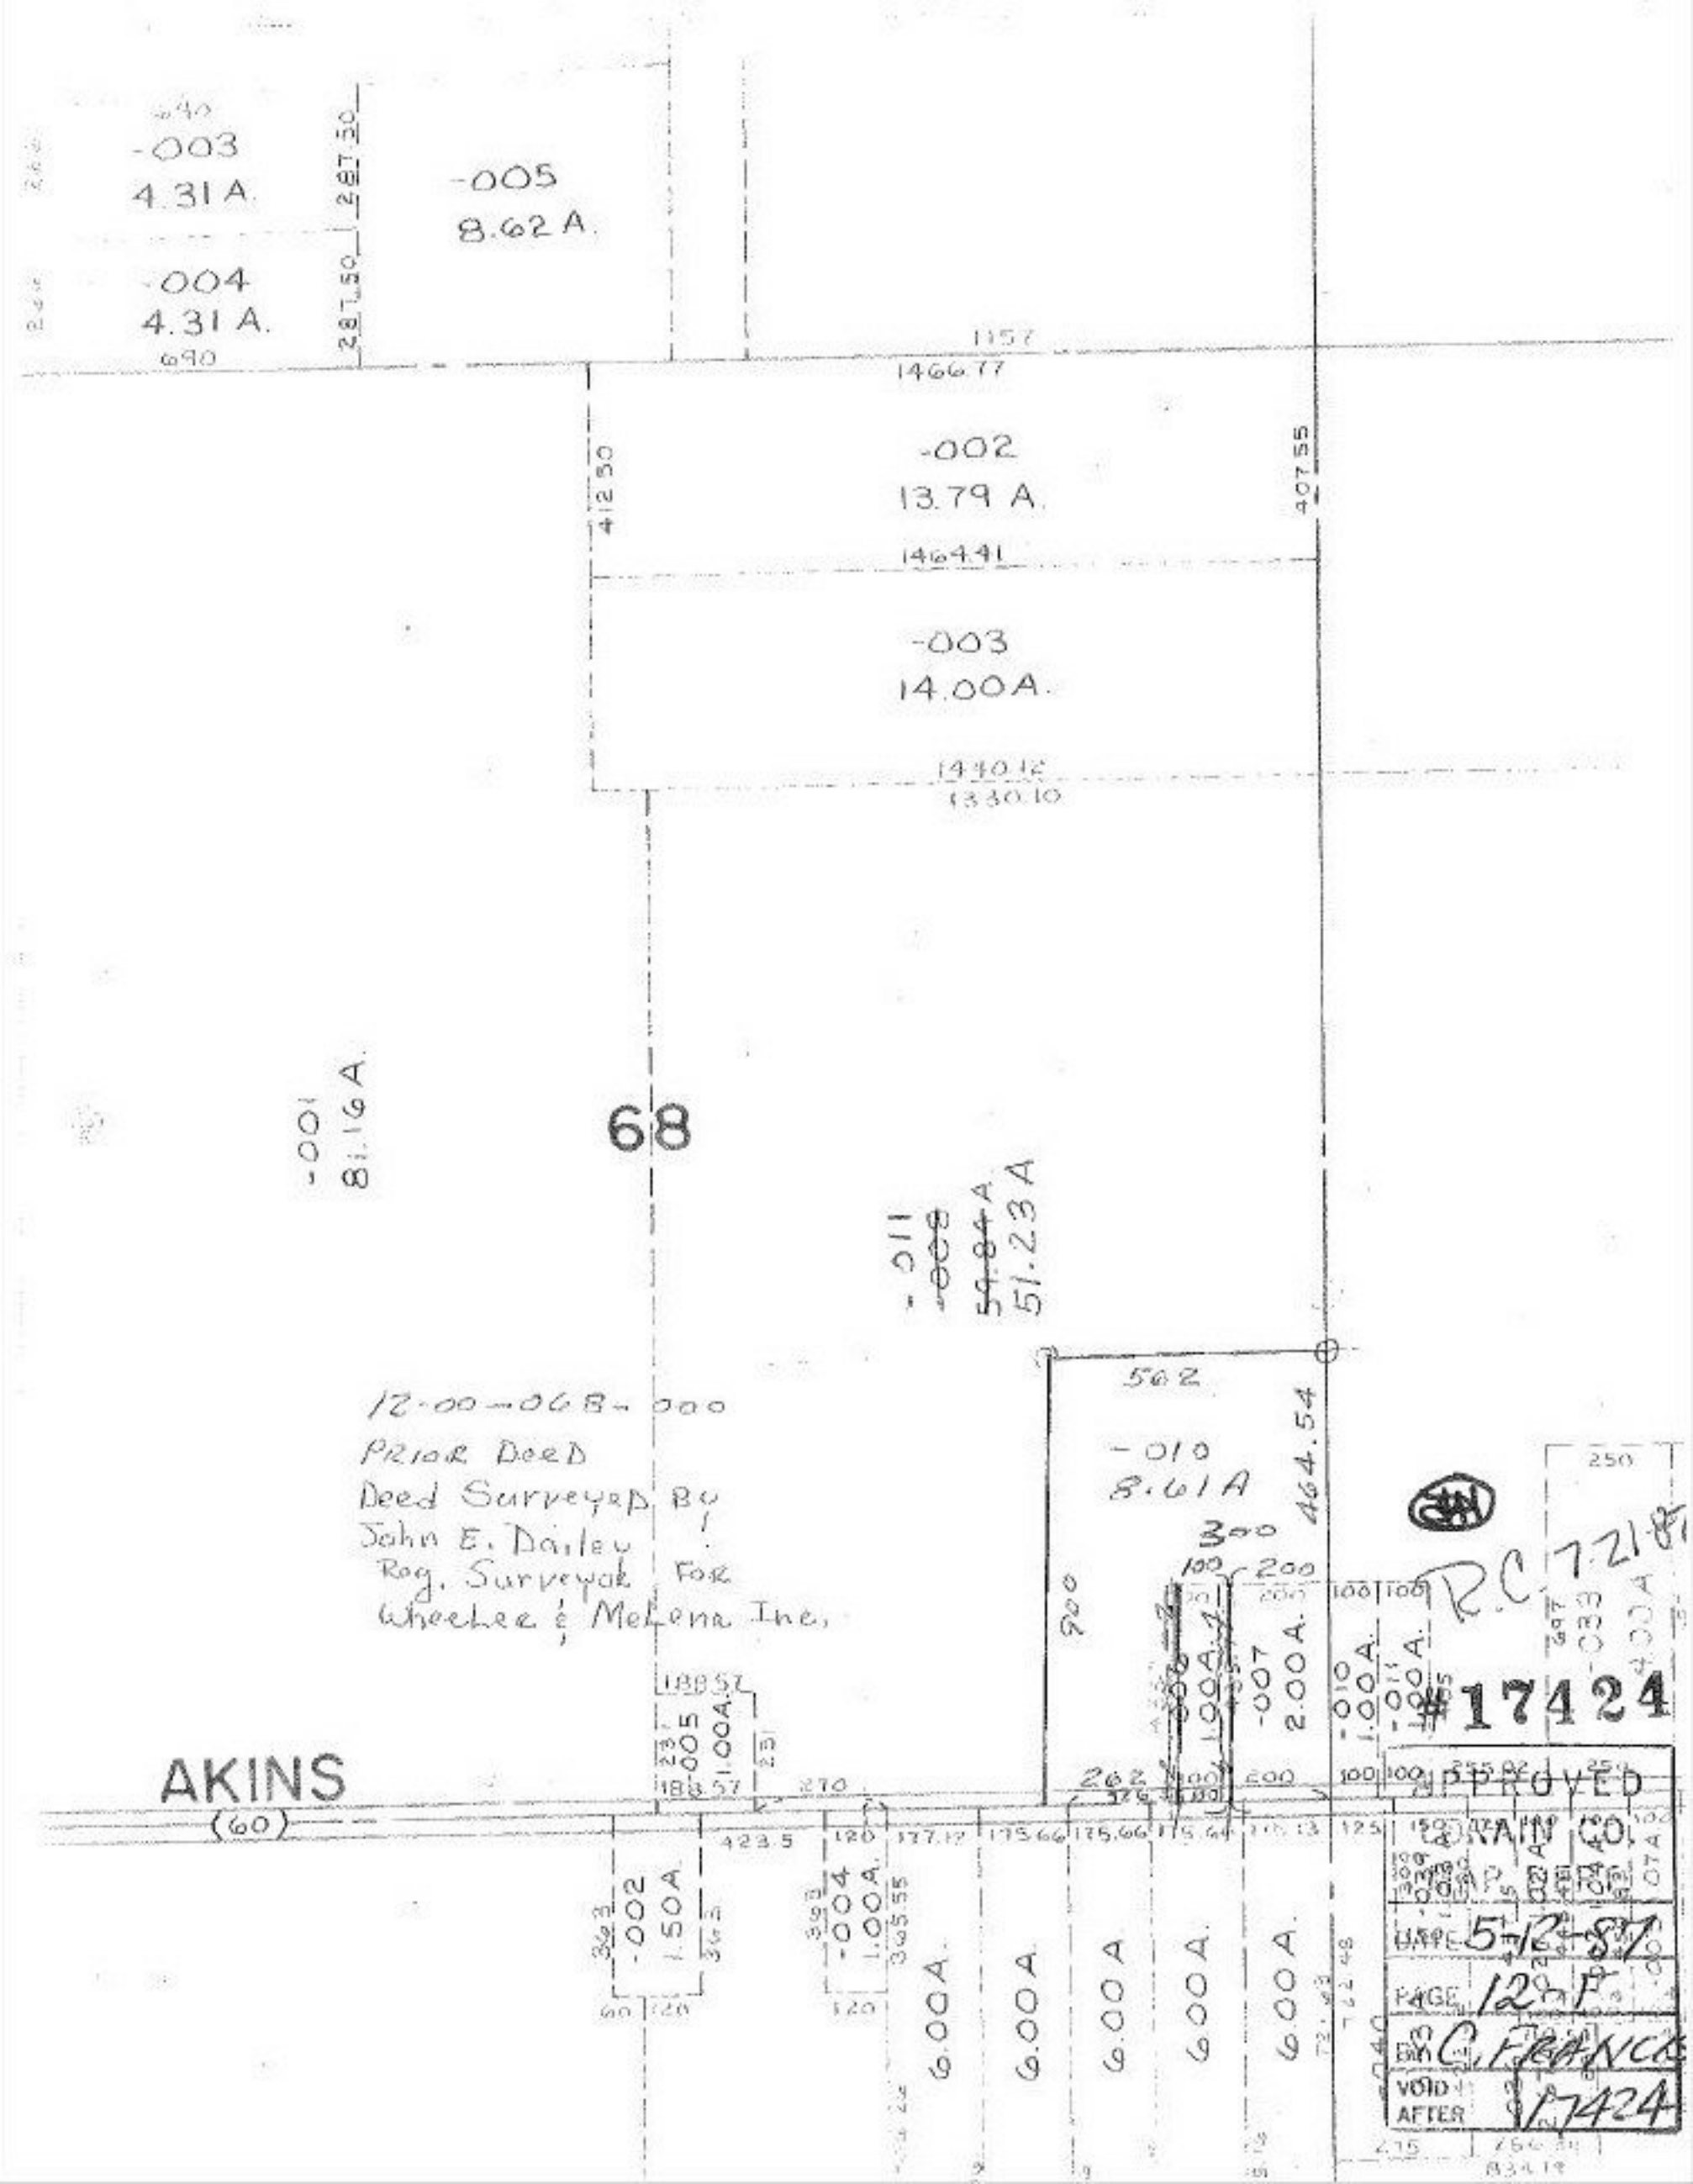

-003
4.31 A.
-004
4.31 A.
-005
8.62 A.
-002
13.79 A.
-003
14.00 A.
68
-001
81.16 A.
-011
51.23 A
-010
8.61 A
12-00-068-000
PRIOR DEED
Deed Surveyed By
John E. Dailey
Reg. Surveyor For
Wheeler & McLena Inc.
AKINS
(60)
-002
1.50 A.
-004
1.00 A.
6.00 A.
6.00 A.
6.00 A.
6.00 A.
6.00 A.
-007
2.00 A.
-010
1.00 A.
-011
1.00 A.
R.C. 7-21-87
#17424
APPROVED
DATE 5-12-87
PAGE 12-F
BY C. FRANCK
VOID AFTER 17424