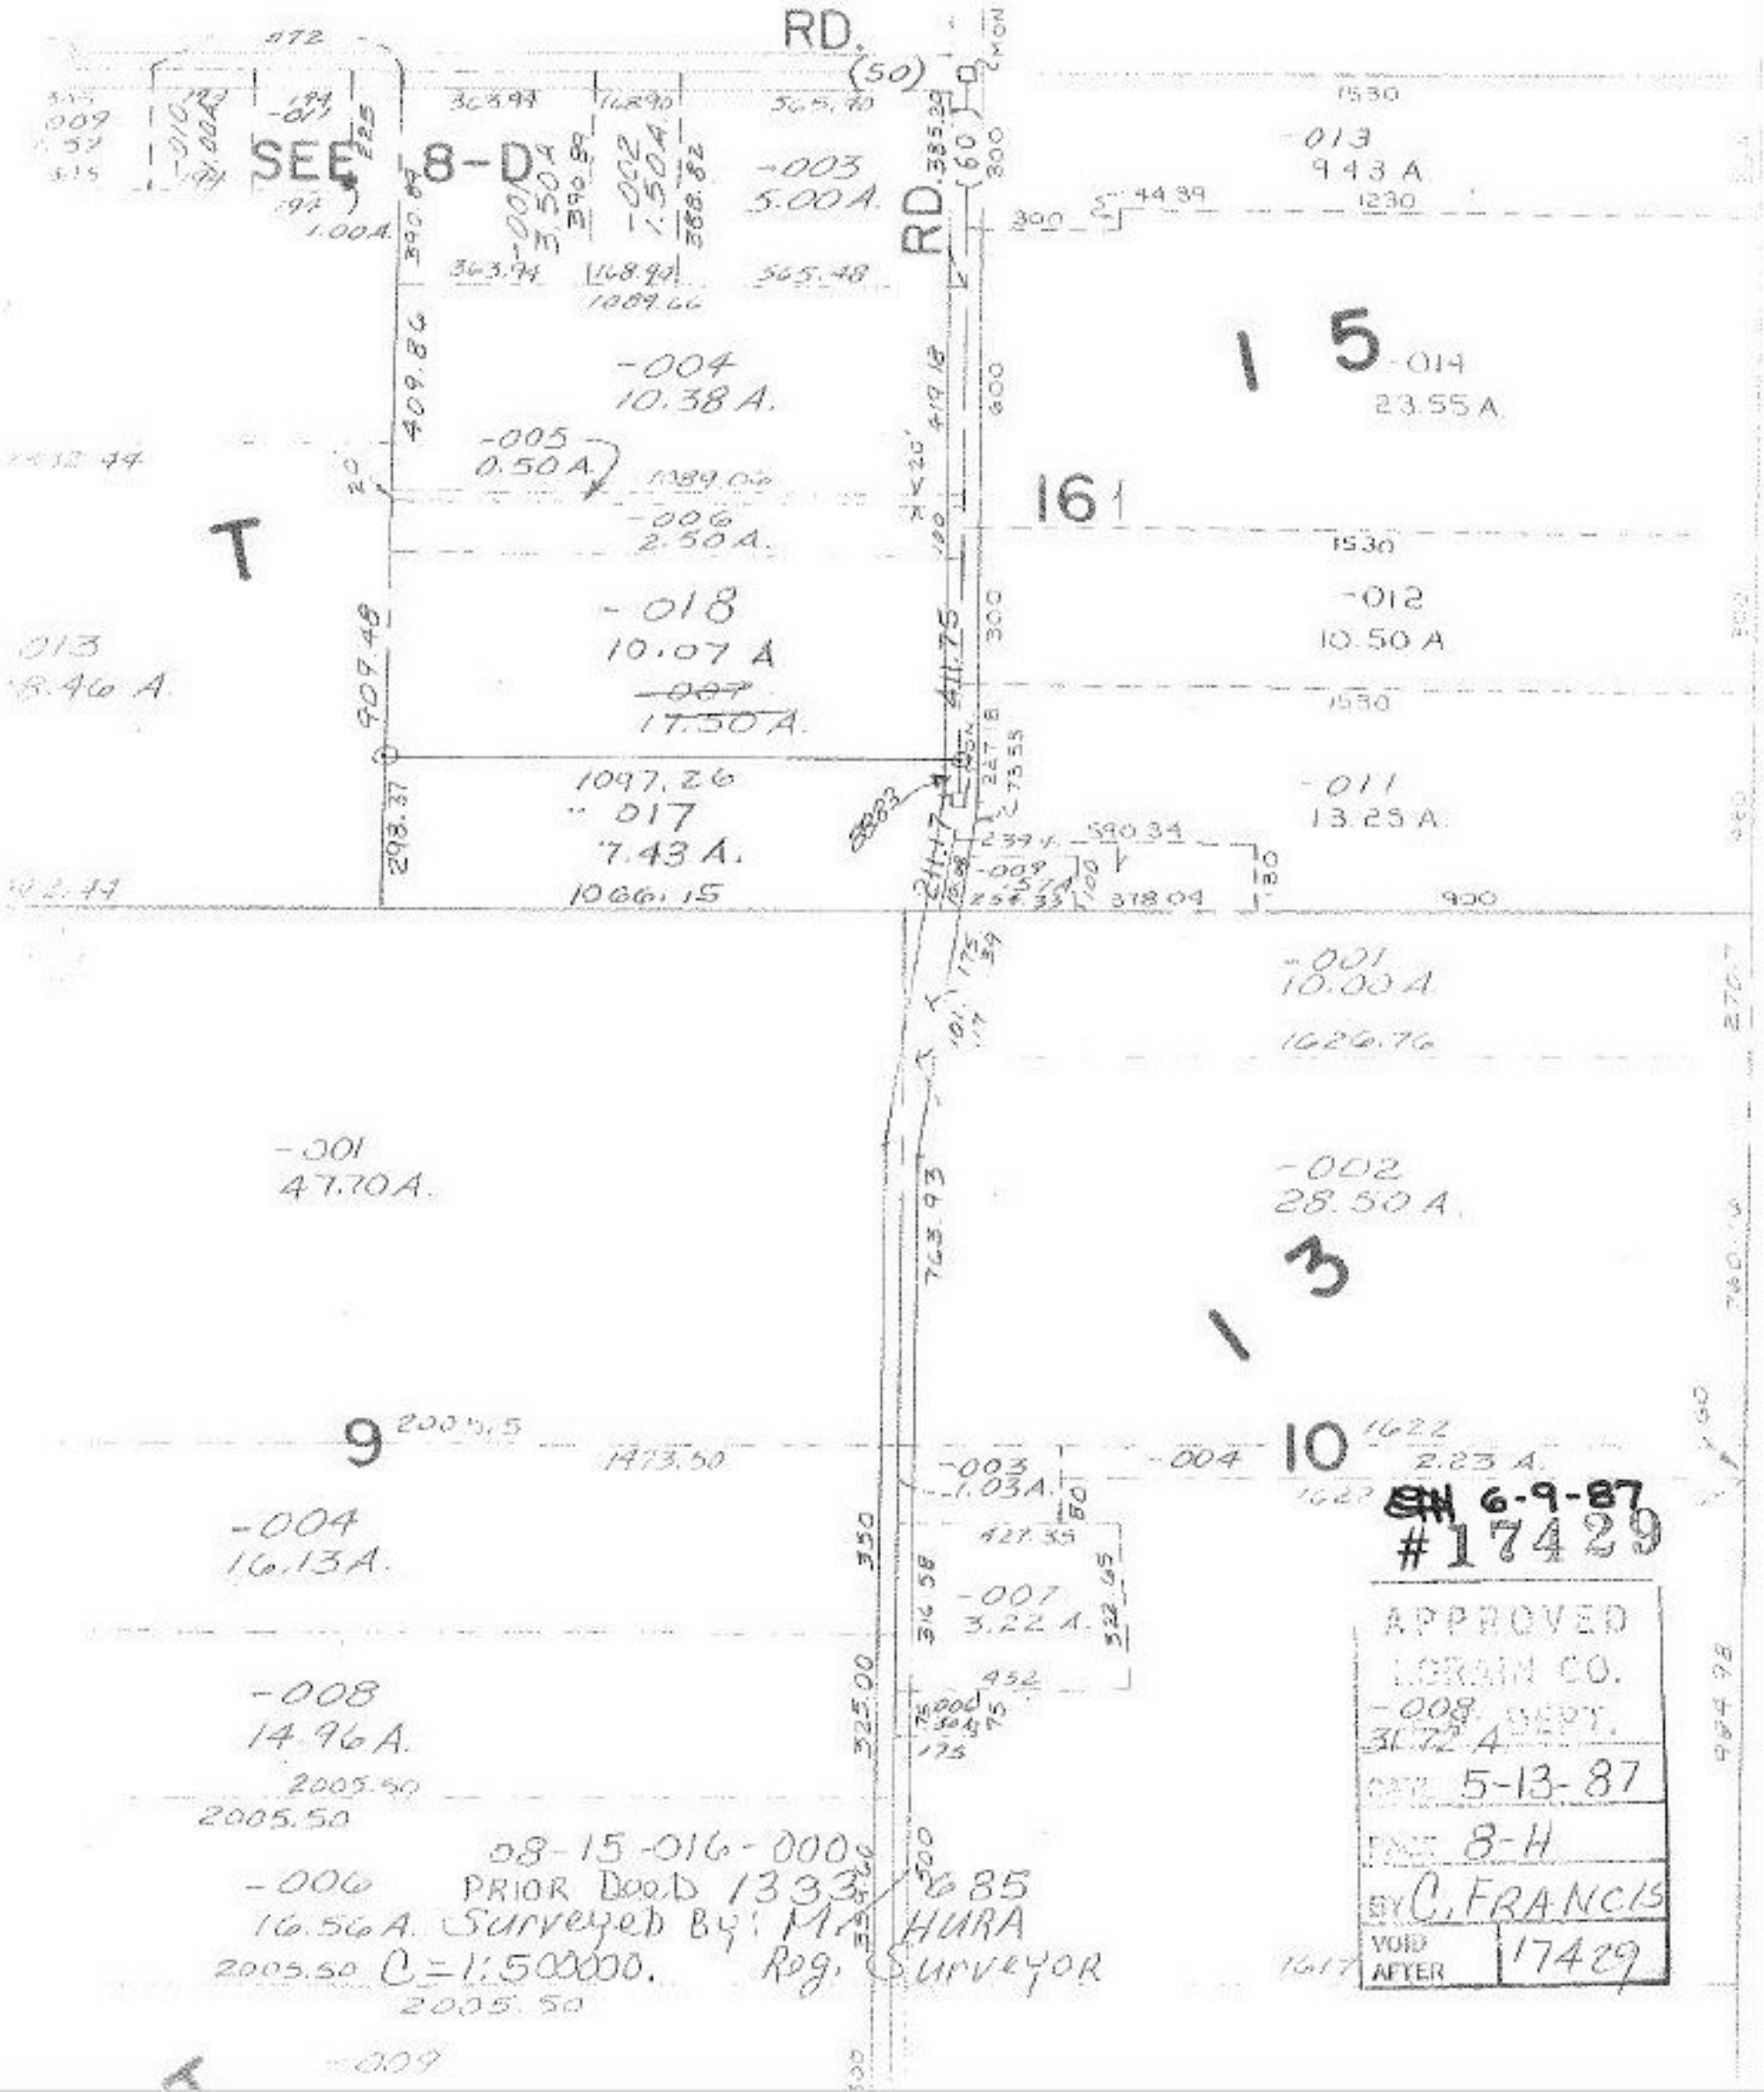
RD.
(50)
SEE 8-D
RD.
-003
5.00 A.
-004
10.38 A.
-005
0.50 A.
-006
2.50 A.
-018
10.07 A
17.50 A.
-017
7.43 A.
1066.15
-013
9.43 A
-014
23.55 A
-012
10.50 A
-011
13.25 A.
-001
10.00 A
1626.76
-002
28.50 A.
-001
47.70 A.
-004
16.13 A.
-008
14.96 A.
-006
16.56 A.
-003
1.03 A.
-007
3.22 A.
-004
2.23 A.
1622
1473.50
2005.50
2005.50
2005.50
2005.50
2005.50
-009
T
15
16
13
9
10
08-15-016-000
PRIOR DOOD 1333/685
Surveyed By: M. HURA
C=1:500000. Reg. Surveyor
6-9-87
#17429
APPROVED
LORAIN CO.
-008 DEPT.
31.72 A
DATE 5-13-87
PAGE 8-H
BY C. FRANCIS
VOID AFTER 17429