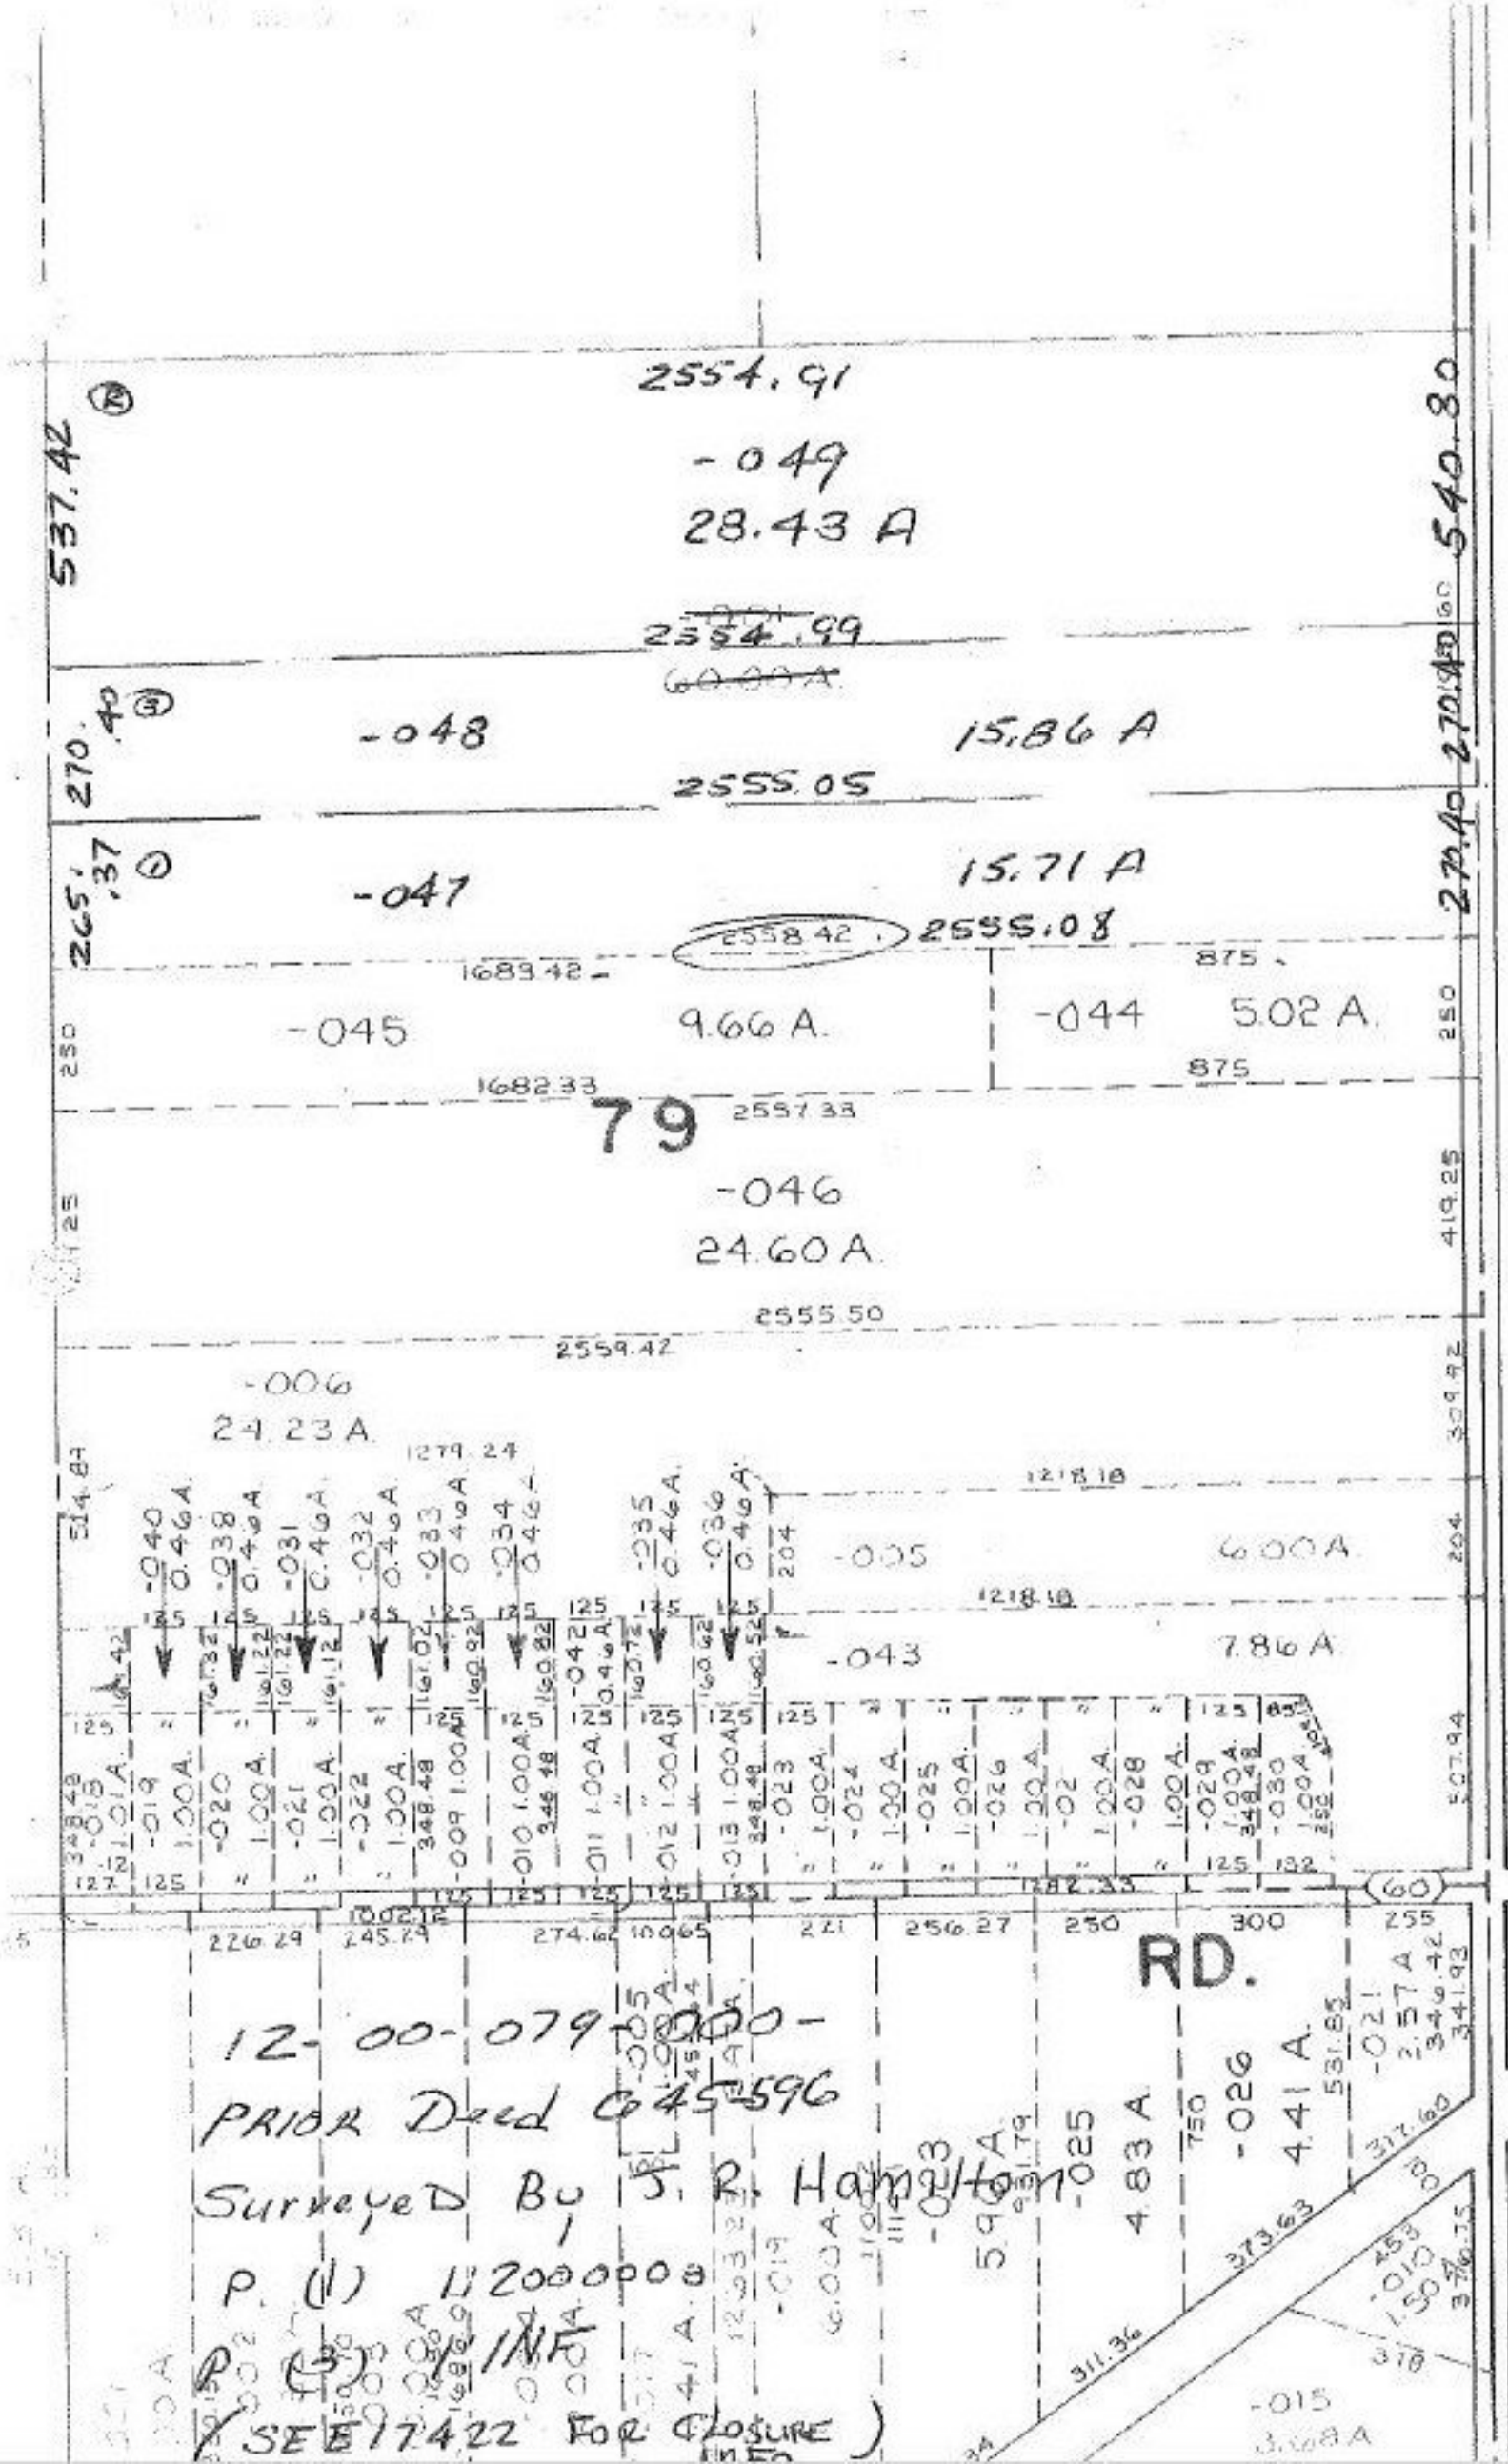

SM

RC 7-21-87

#17437

APPROVED
DRAIN CO.
MAP DEPT.

DATE 5-26-87

PAGE 12-A

BY C. Francis

VOID AFTER 17437