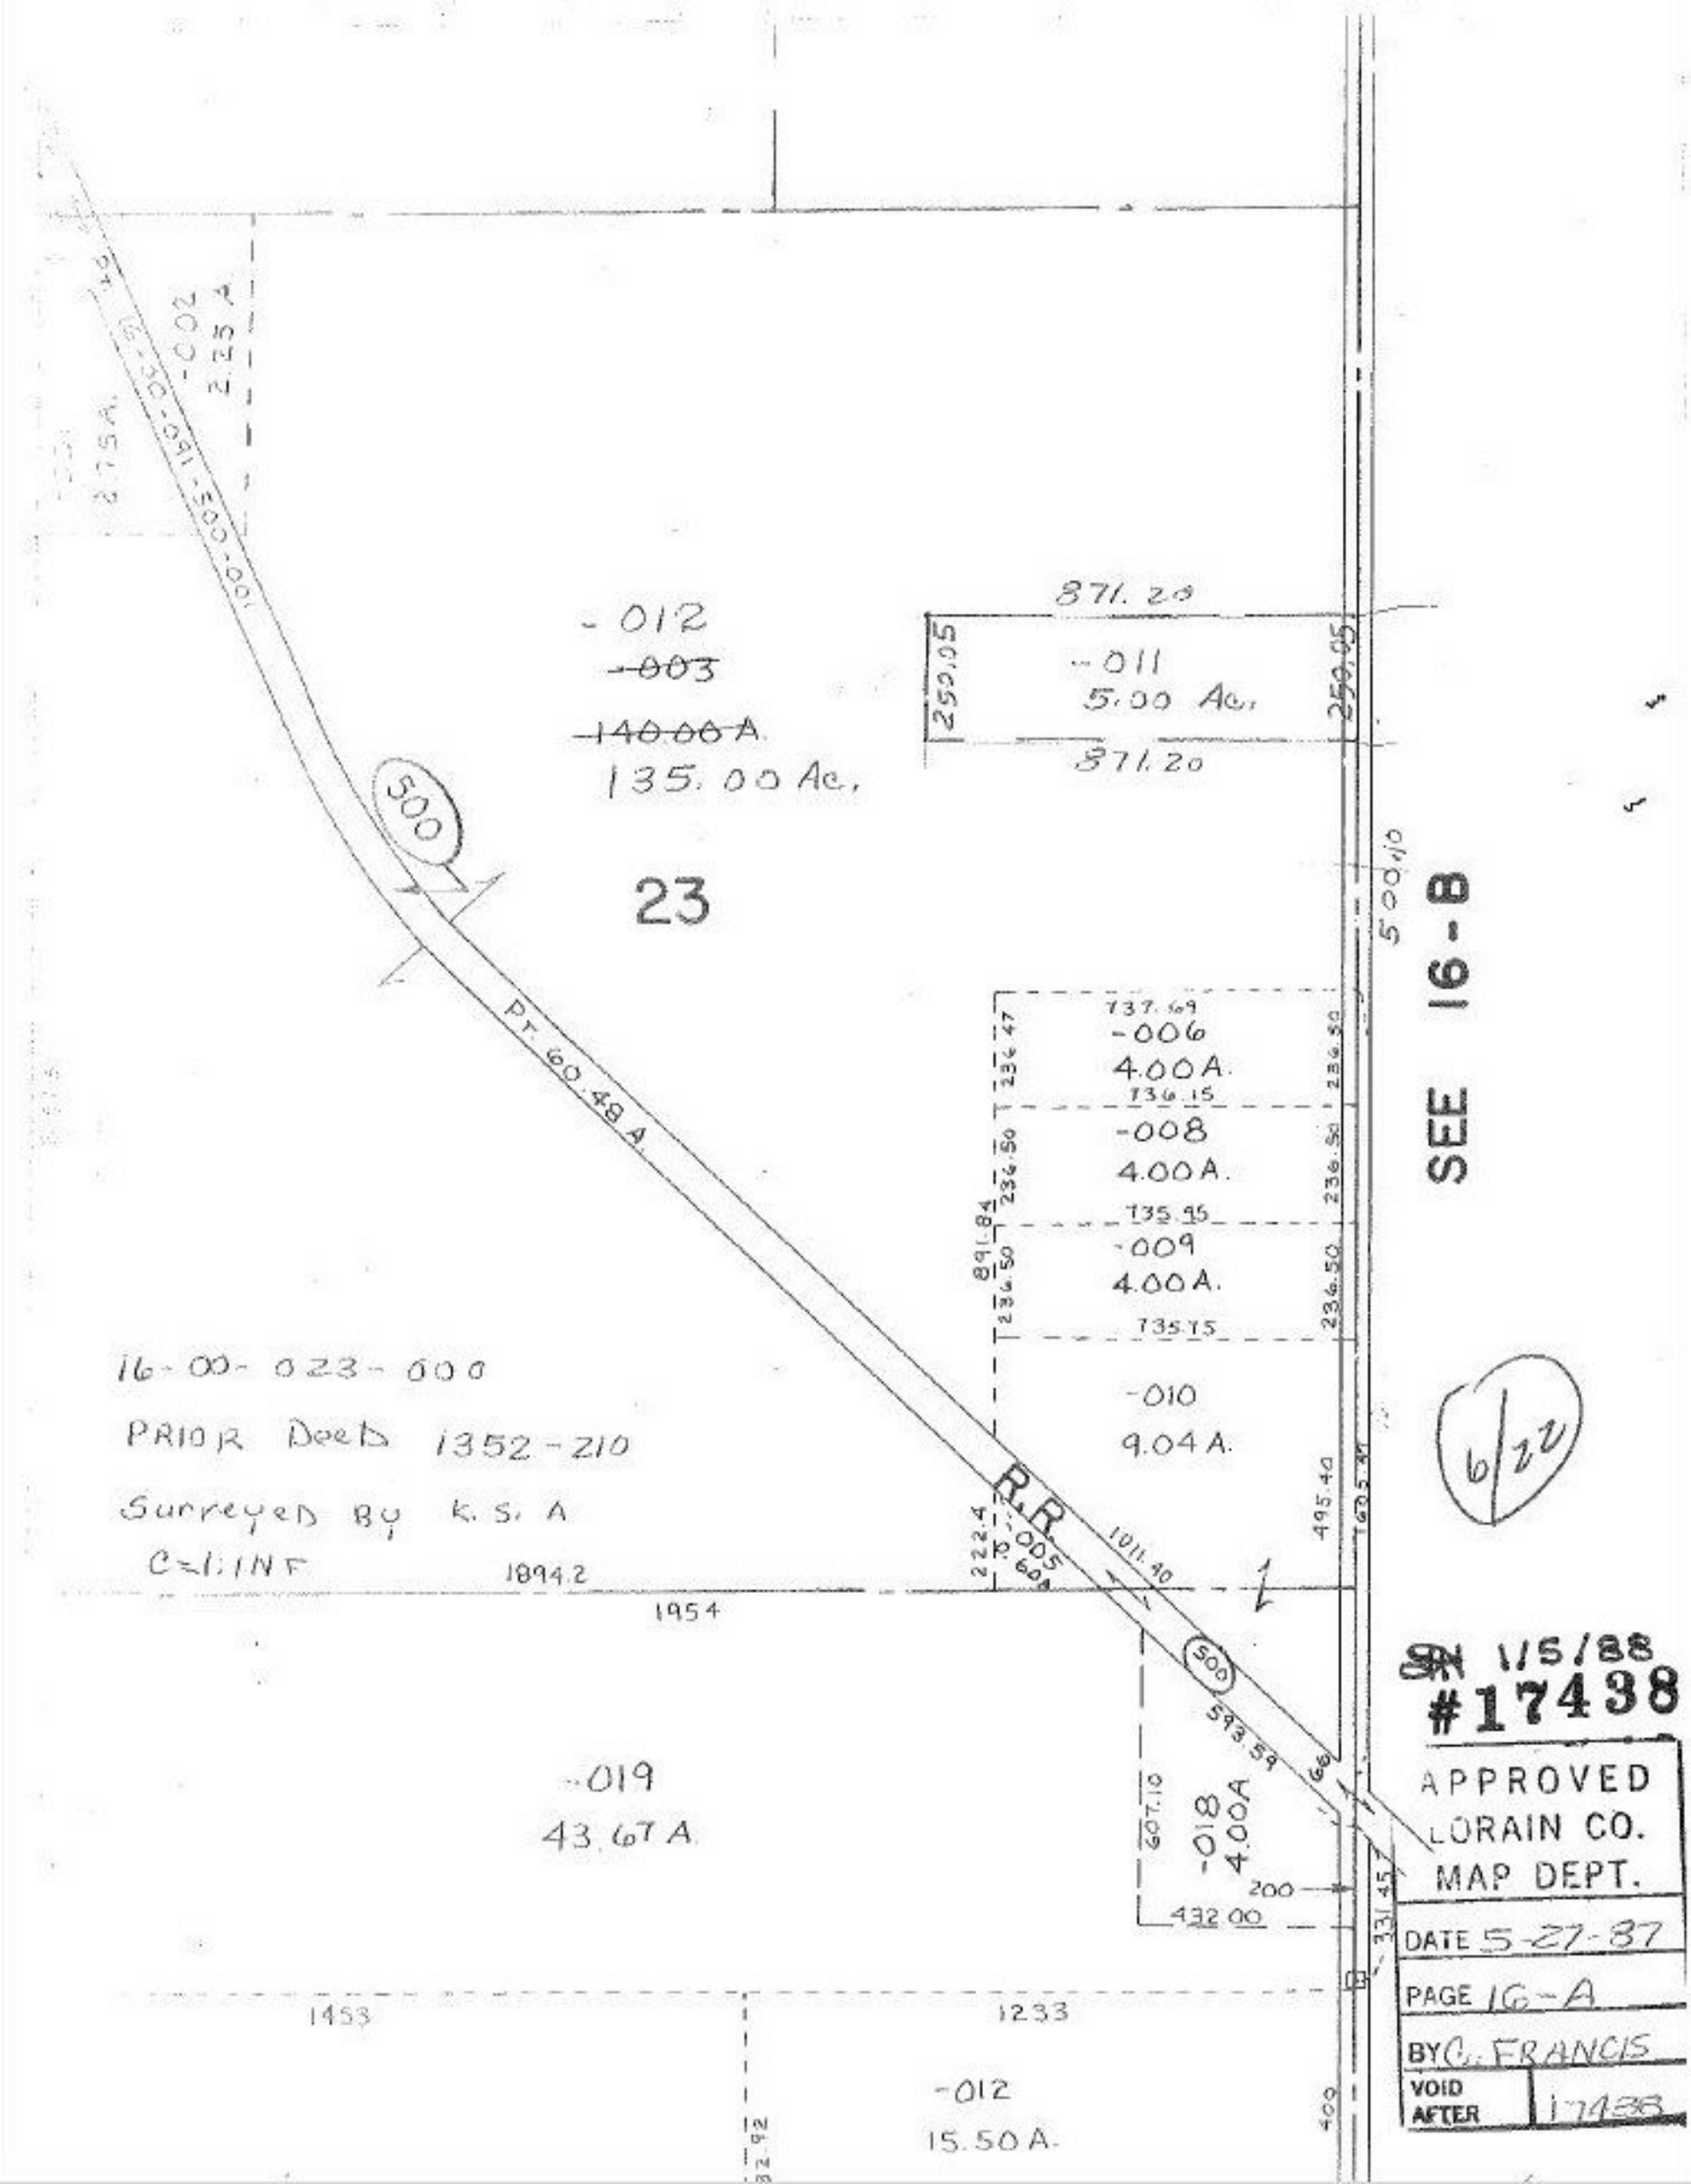

-002
2.25 A
-012
~~-003~~
~~140.00 A~~
135.00 Ac.
871.20
250.05
-011
5.00 Ac.
871.20
250.05
500
23
Pt. 60.48 A
737.69
-006
4.00 A.
736.15
-008
4.00 A.
735.95
-009
4.00 A.
735.75
-010
9.04 A.
16-00-023-000
PRIOR Deed 1352-210
Surveyed By K.S.A
C=1:INF
1894.2
1954
R.R.
1011.40
495.40
500
593.59
-019
43.67 A
607.10
-018
4.00 A
200
432.00
331.45
1453
1233
-012
15.50 A.
SEE 16-B
6/22
SN 1/5/88
#17438
APPROVED
LORAIN CO.
MAP DEPT.
DATE 5-27-87
PAGE 16-A
BY C. FRANCIS
VOID AFTER 17438