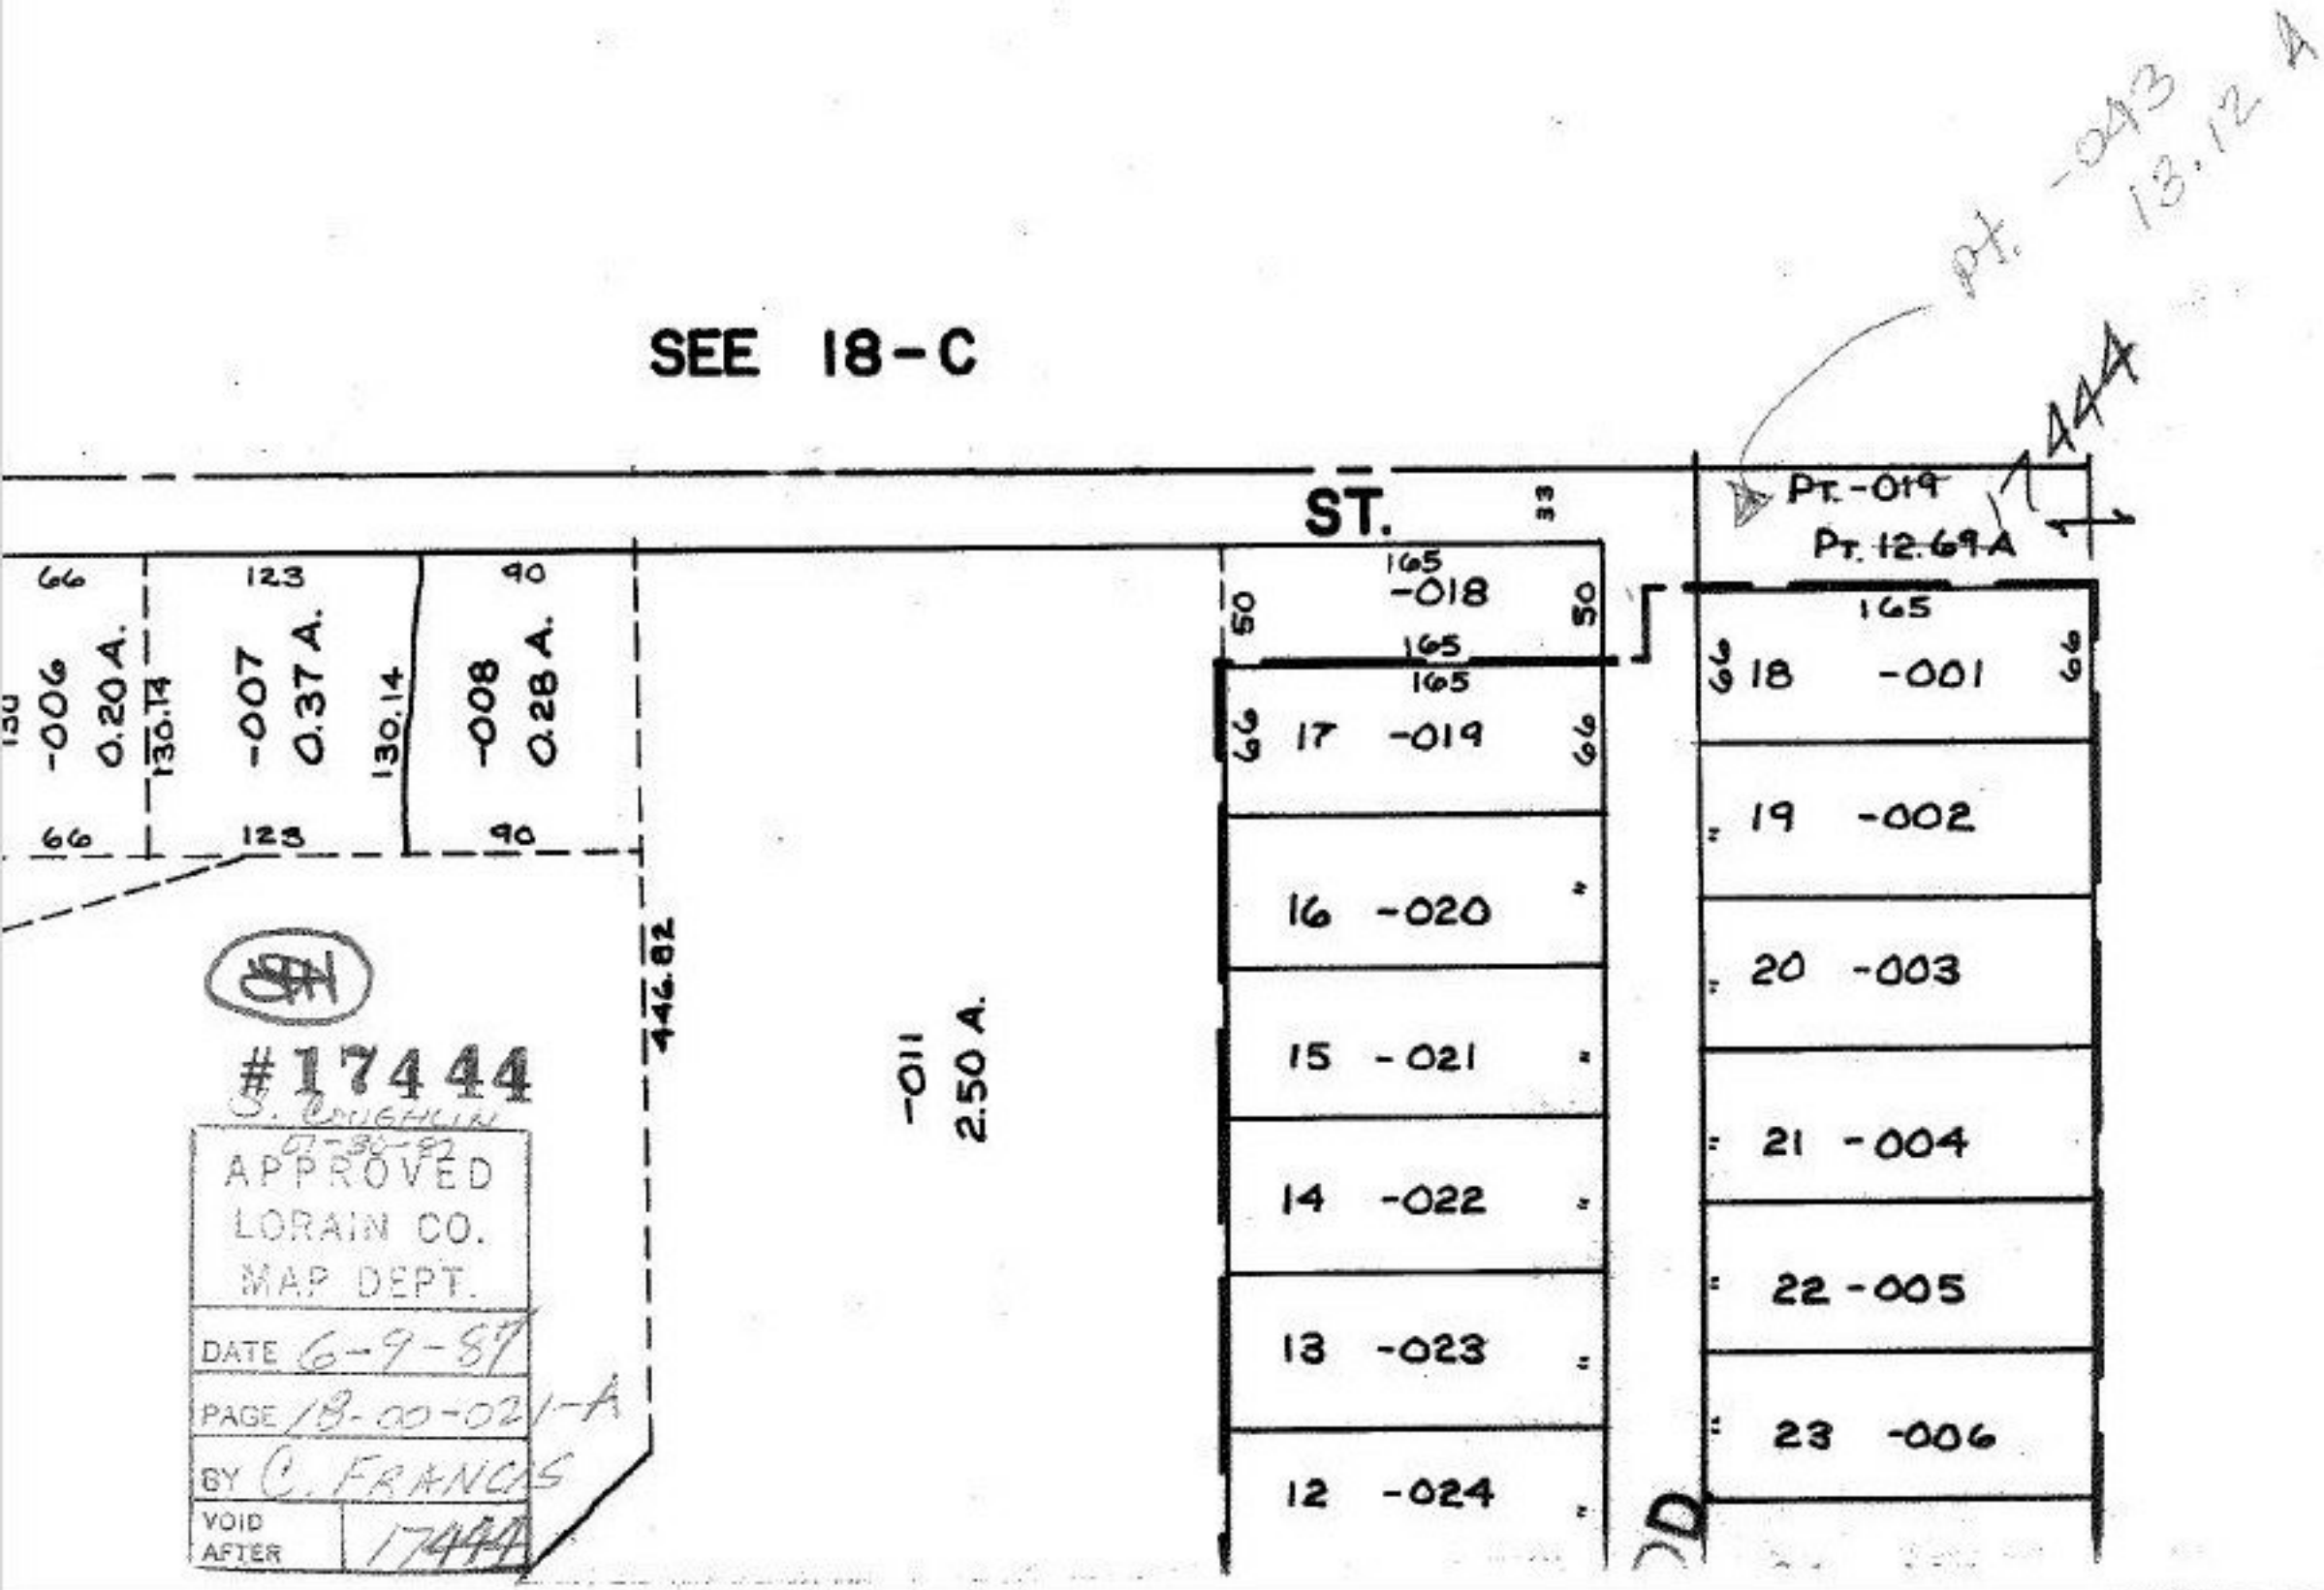

SEE 18-C
ST.
Pt. -019
Pt. 12.69 A
17444
pt. -043
13.12 A
66
123
90
130
-006
0.20 A.
130.14
-007
0.37 A.
130.14
-008
0.28 A.
66
123
90
446.82
-011
2.50 A.
165
-018
50
50
165
165
17 -019
66
66
16 -020
15 -021
14 -022
13 -023
12 -024
165
18 -001
66
66
19 -002
20 -003
21 -004
22 -005
23 -006
#17444
S. Coughlin
07-30-82
APPROVED
LORAIN CO.
MAP DEPT.
DATE 6-9-87
PAGE 18-00-021-A
BY C. FRANCIS
VOID AFTER 17444