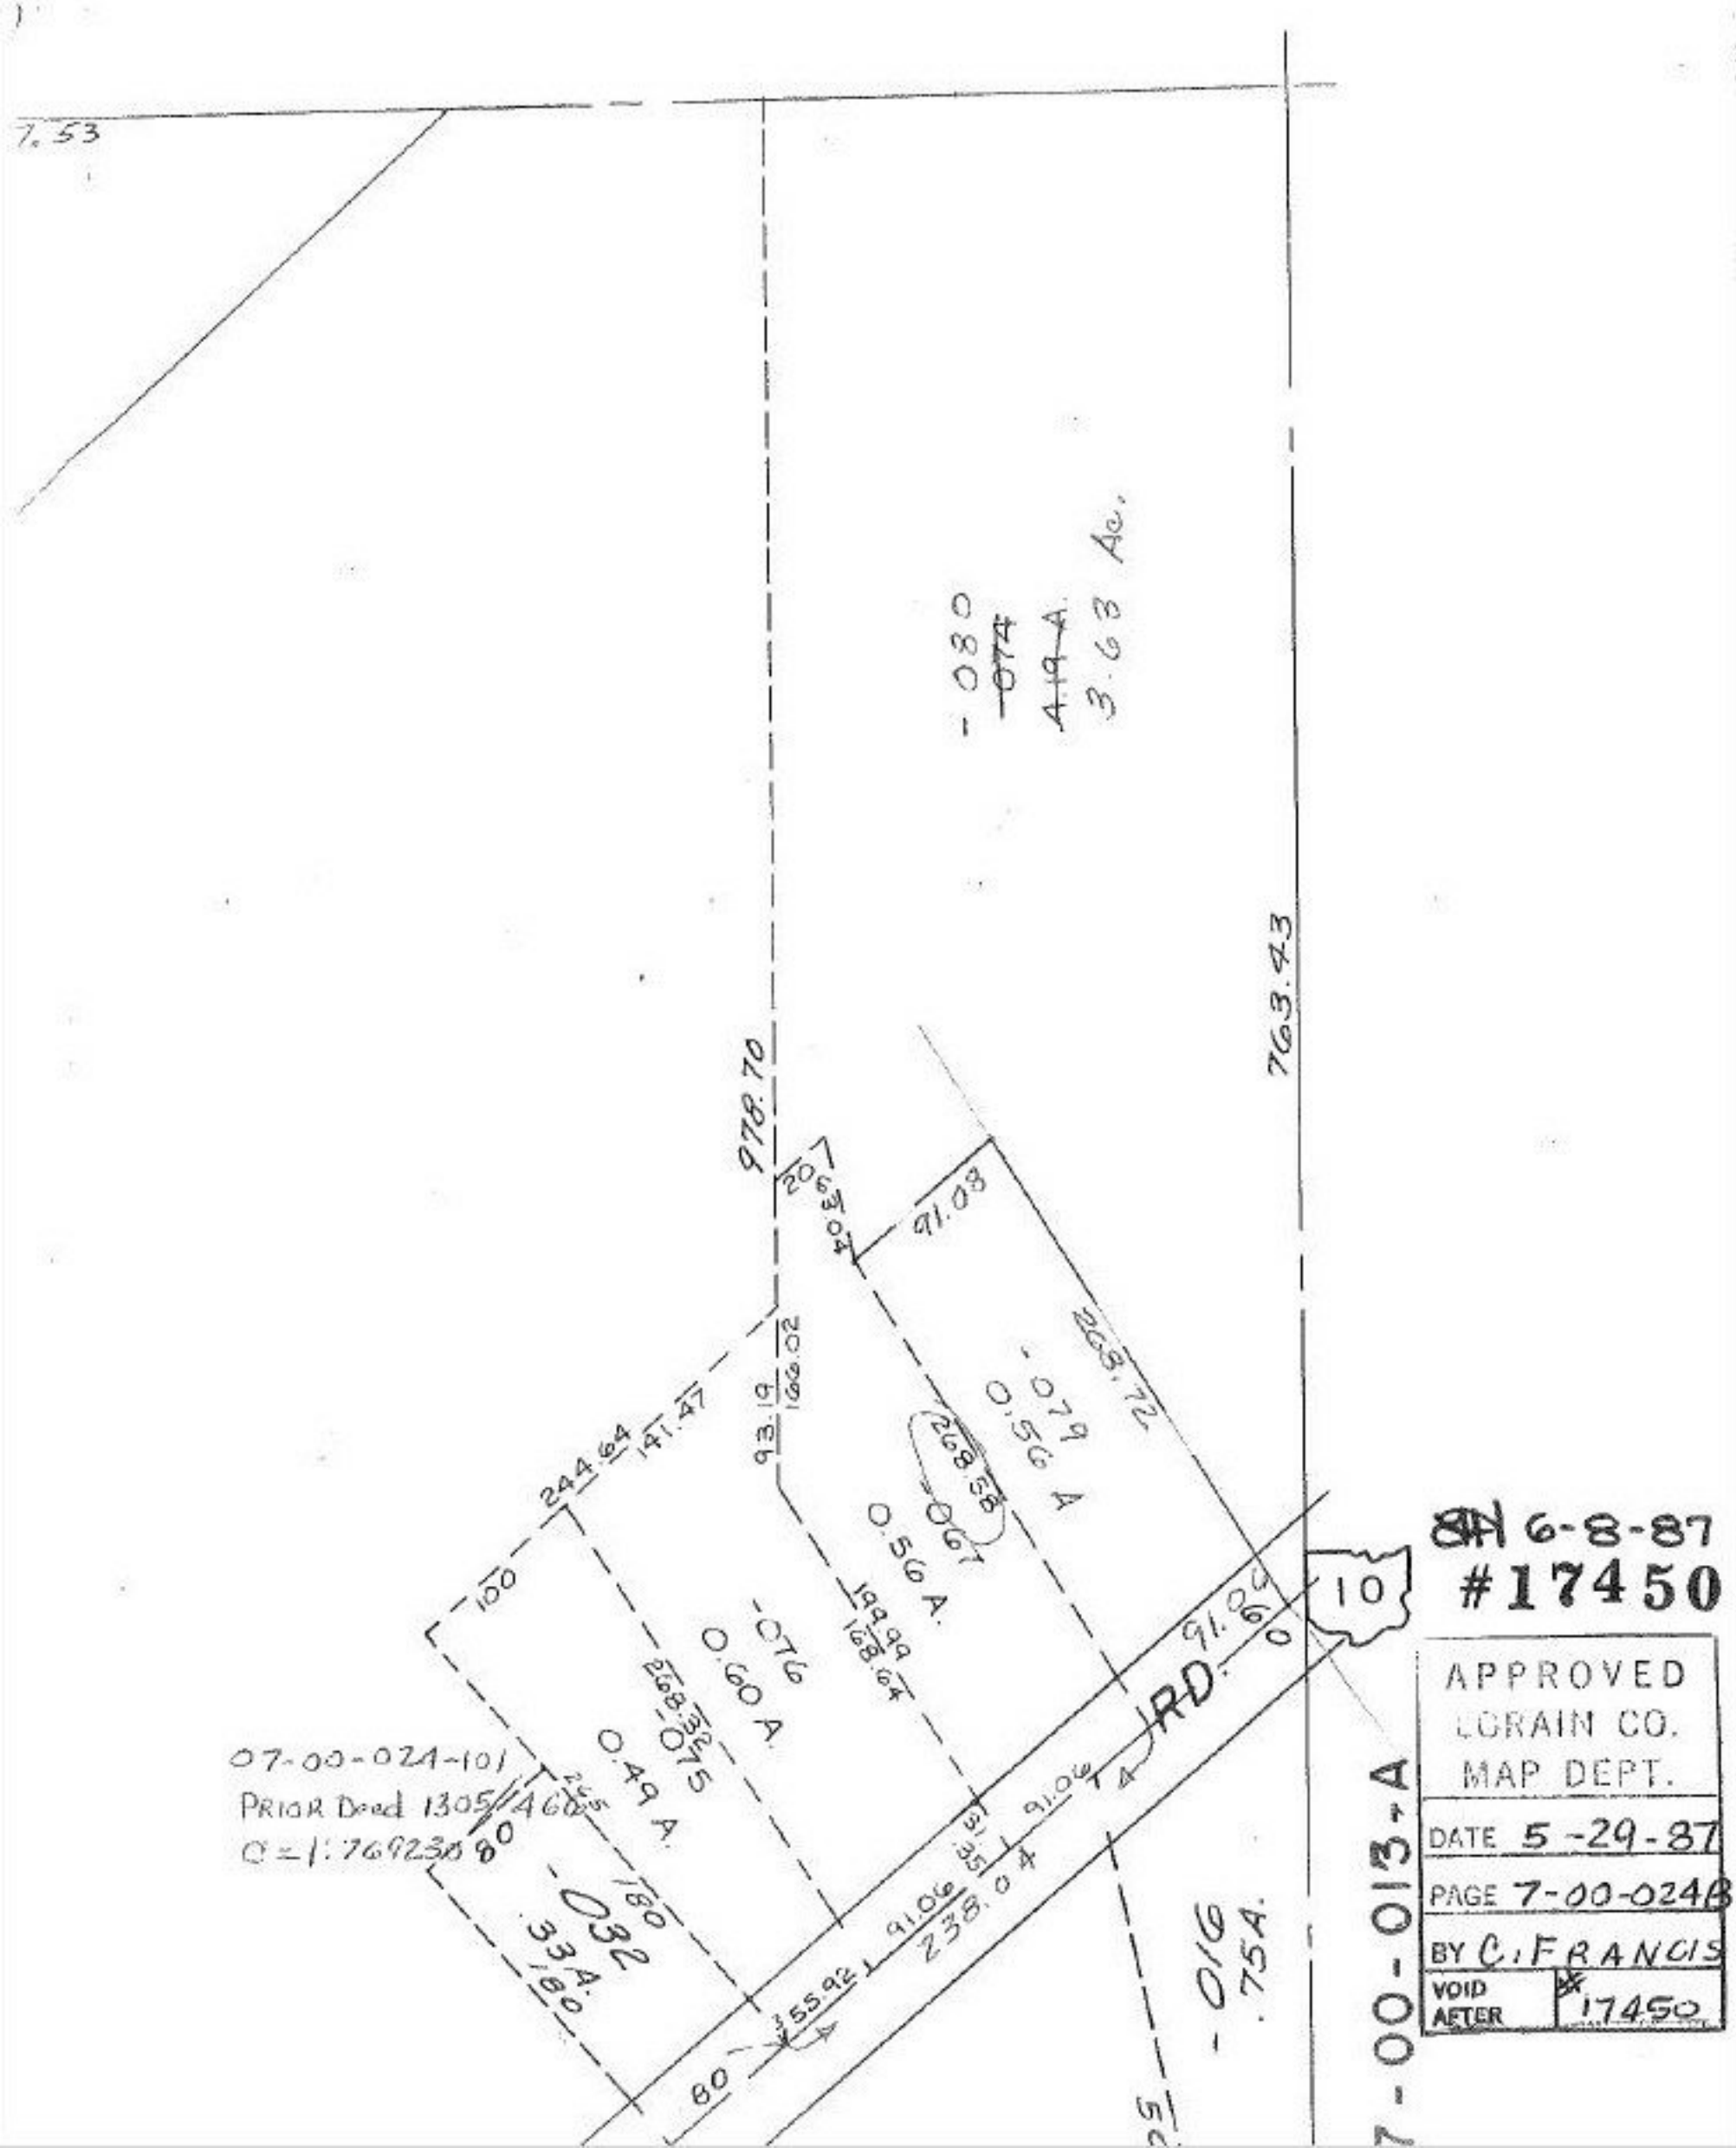
7.53
763.43
978.70
207.04
91.08
268.72
-079
0.56 A
268.58
-061
0.56 A.
199.99
168.64
-076
0.60 A
268.32
-075
0.49 A.
-080
-074
4.19 A.
3.68 Ac.
244.64
141.47
93.19
169.02
100
80
180
-032
33 A.
180
91.06
238.04
55.92
80
RD.
10
-016
.754.
07-00-013-A
07-00-021-101
PRIOR Deed 1305/468
C=1:769230
BH 6-8-87
#17450
APPROVED
LORAIN CO.
MAP DEPT.
DATE 5-29-87
PAGE 7-00-024B
BY C. FRANCIS
VOID AFTER
17450