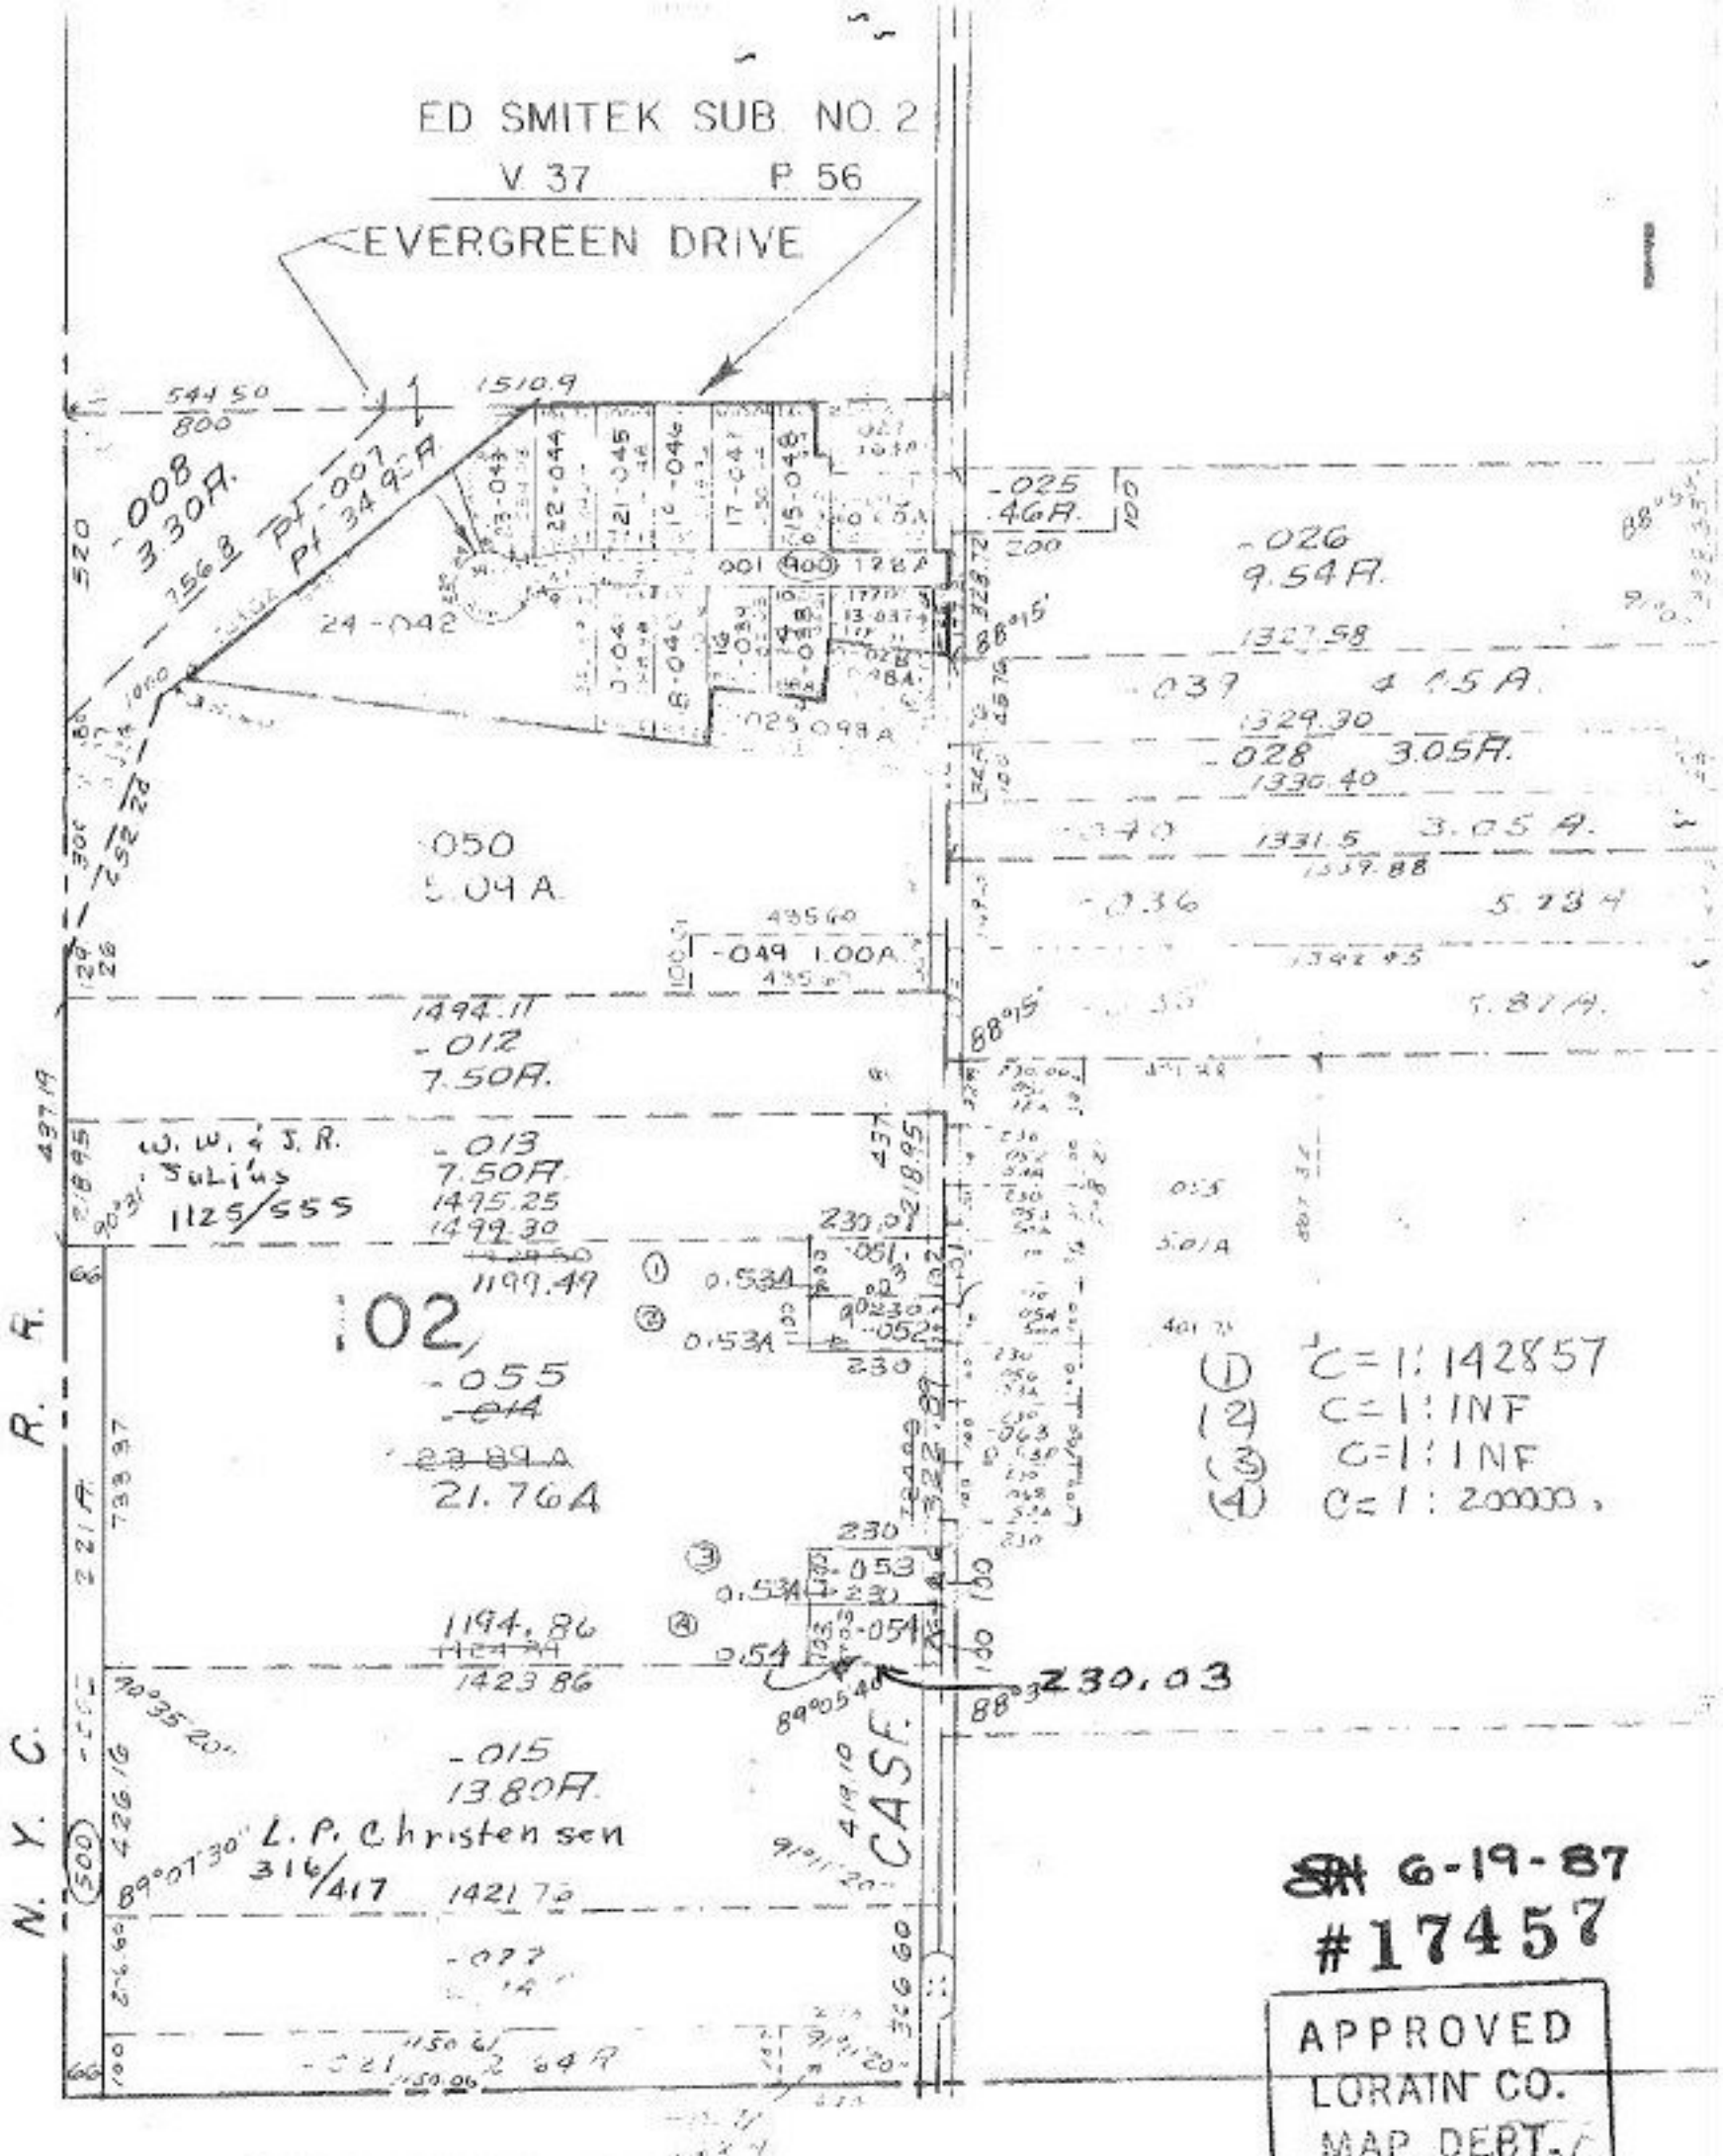

SH 6-19-87
#17457

APPROVED
LORAIN CO.
MAP DEPT.
DATE 6-3-87
PAGE 4-I
BY C. FRANCIS
VOID AFTER 17457

04-00-001-102
PRIOR DEED 1414/537
DEED SURVEYED BY Martini & Assoc.

AVON CITY

SCALE: 1" = 400'