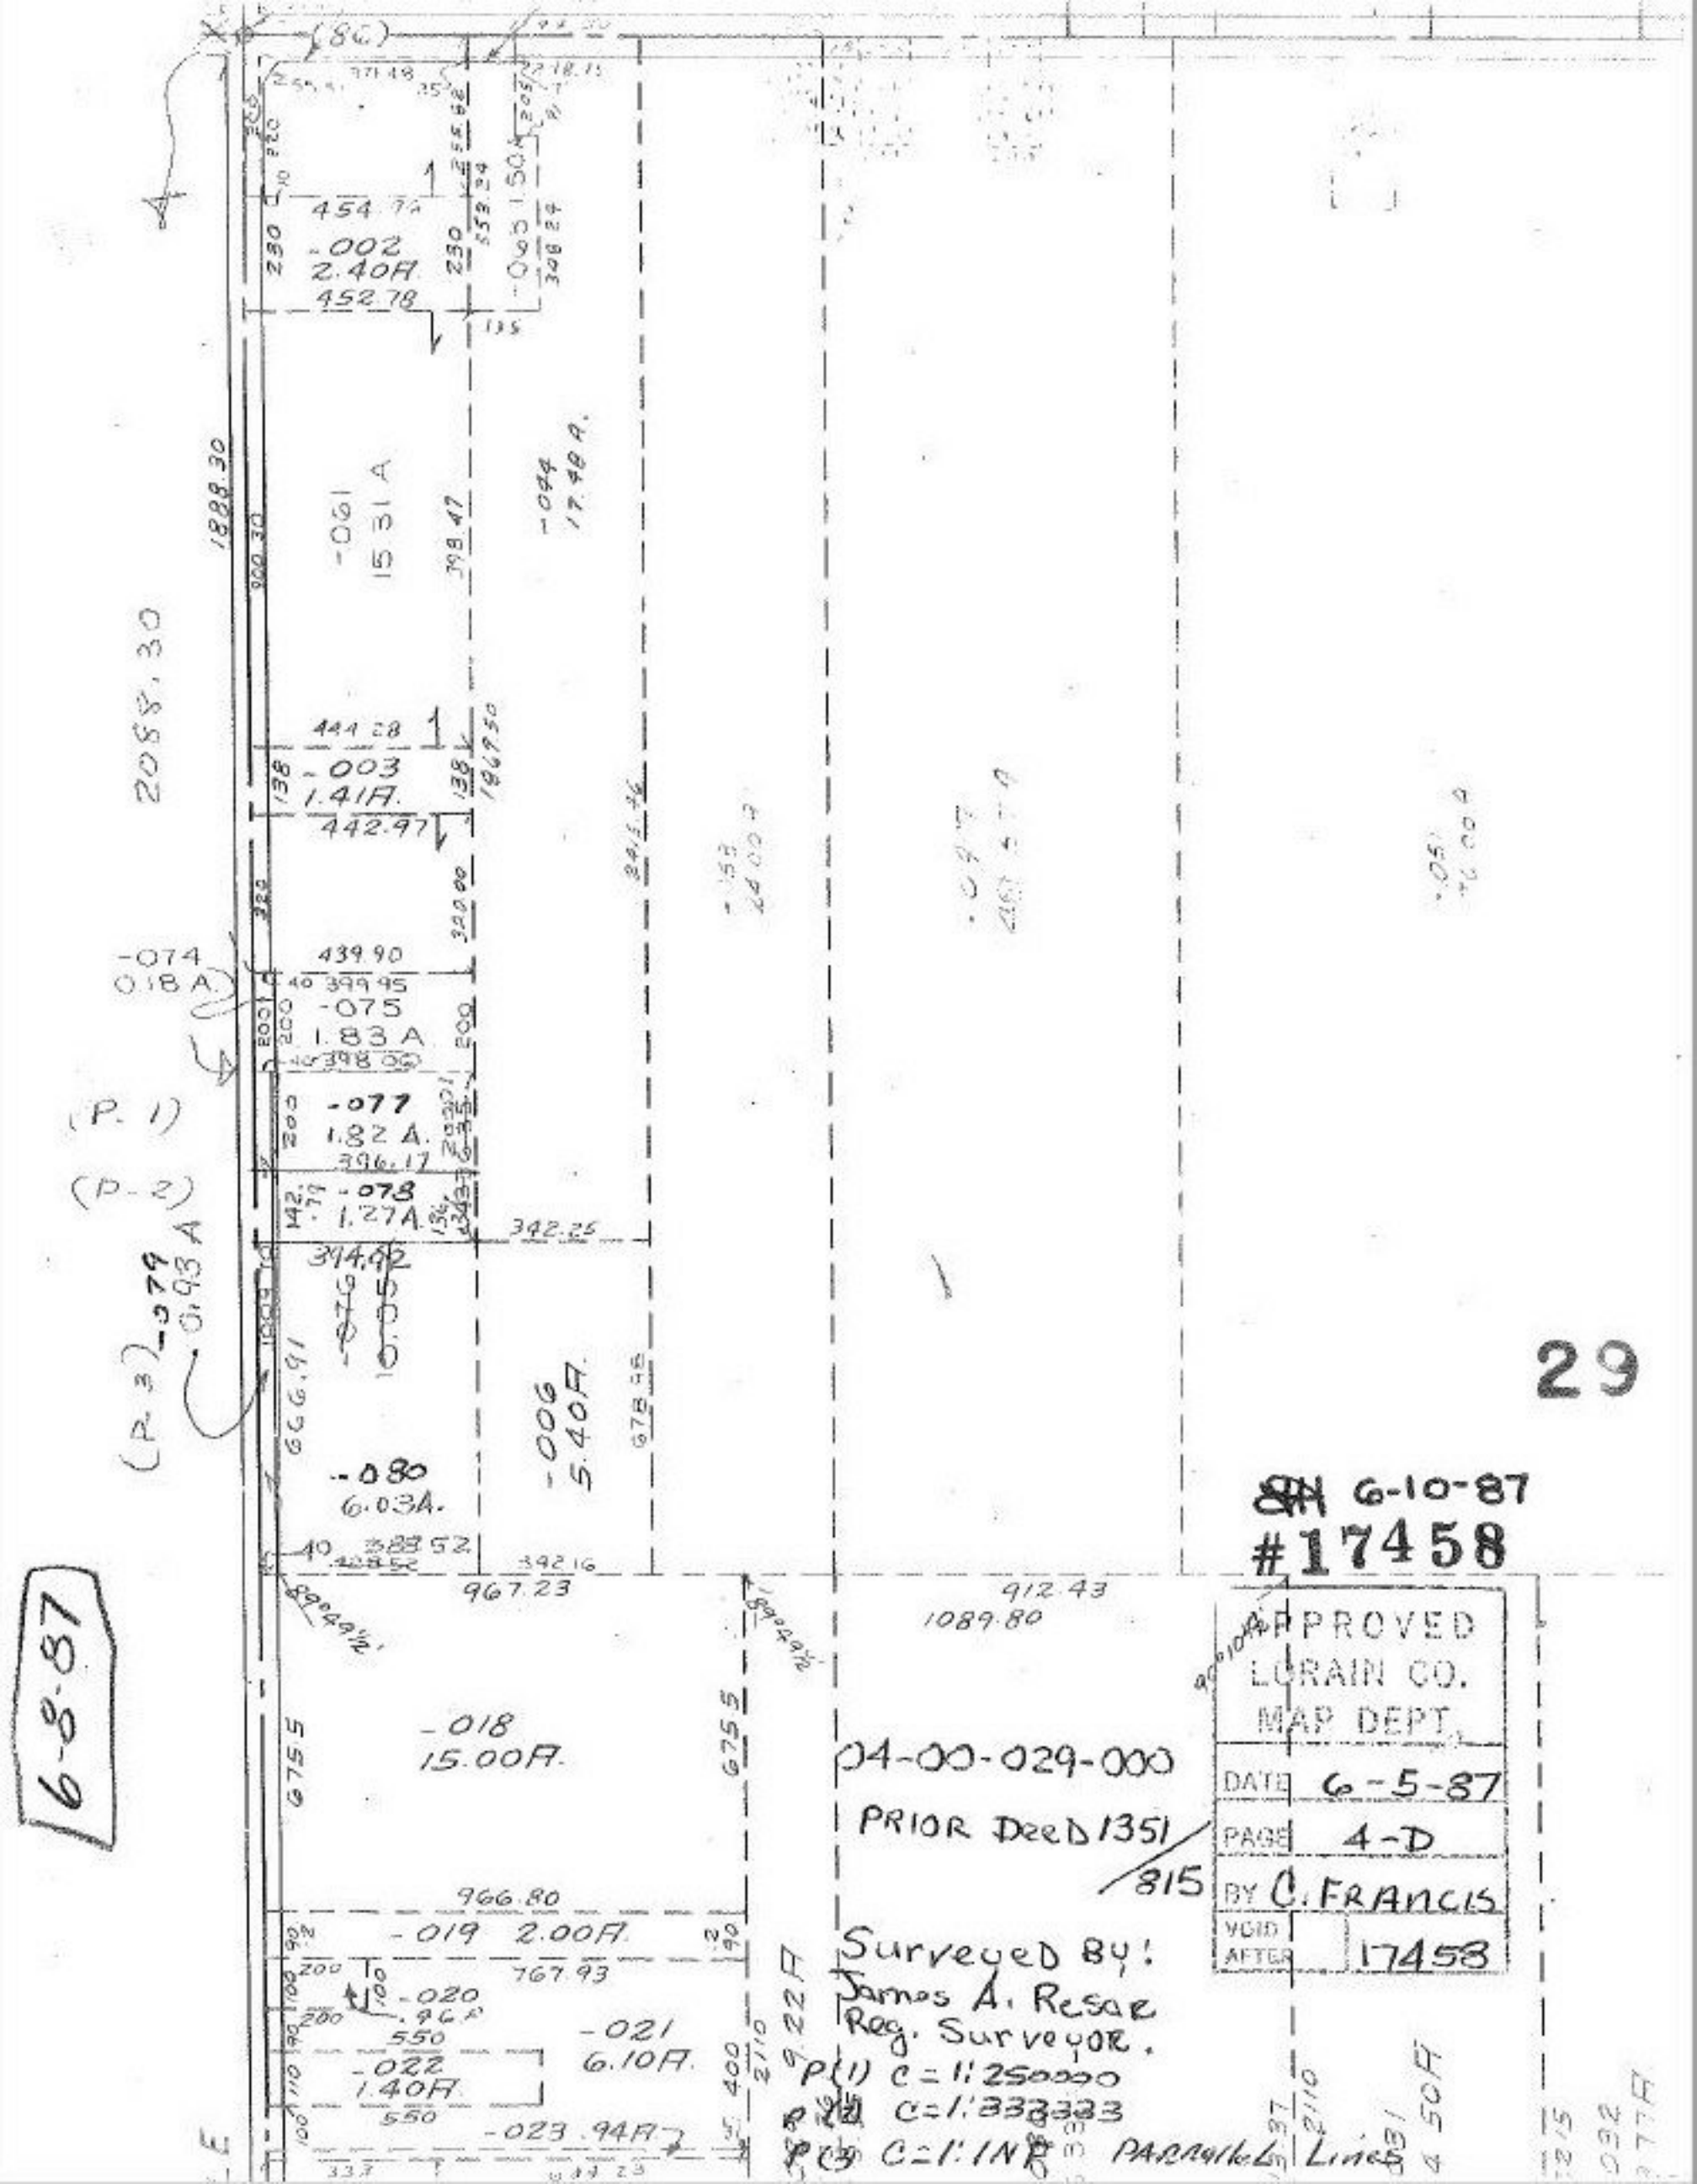

(86)
454.74
-002
2.40A.
452.78
-061
15.31 A
-044
17.48 A.
1888.30
2088.30
444.28
-003
1.41A.
442.97
-074
0.18 A.
439.90
-075
1.83 A
-077
1.82 A.
396.17
-078
1.27A.
342.25
(P-1)
(P-2)
(P-3)
-079
0.93 A
-080
6.03A.
-006
5.40A.
967.23
912.43
1089.80
-018
15.00A.
966.80
-019 2.00A.
767.93
-020
-021
6.10A.
-022
1.40A.
-023 .94A.
6-8-87
29
6-10-87
#17458
APPROVED
LORAIN CO.
MAP DEPT.
DATE 6-5-87
PAGE 4-D
BY C. FRANCIS
VOID AFTER 17458
04-00-029-000
PRIOR DEED 1351/815
Surveyed By:
James A. Resar
Reg. Surveyor.
P(1) C=1:250000
P(2) C=1:333333
P(3) C=1:INF PARALLEL LINES