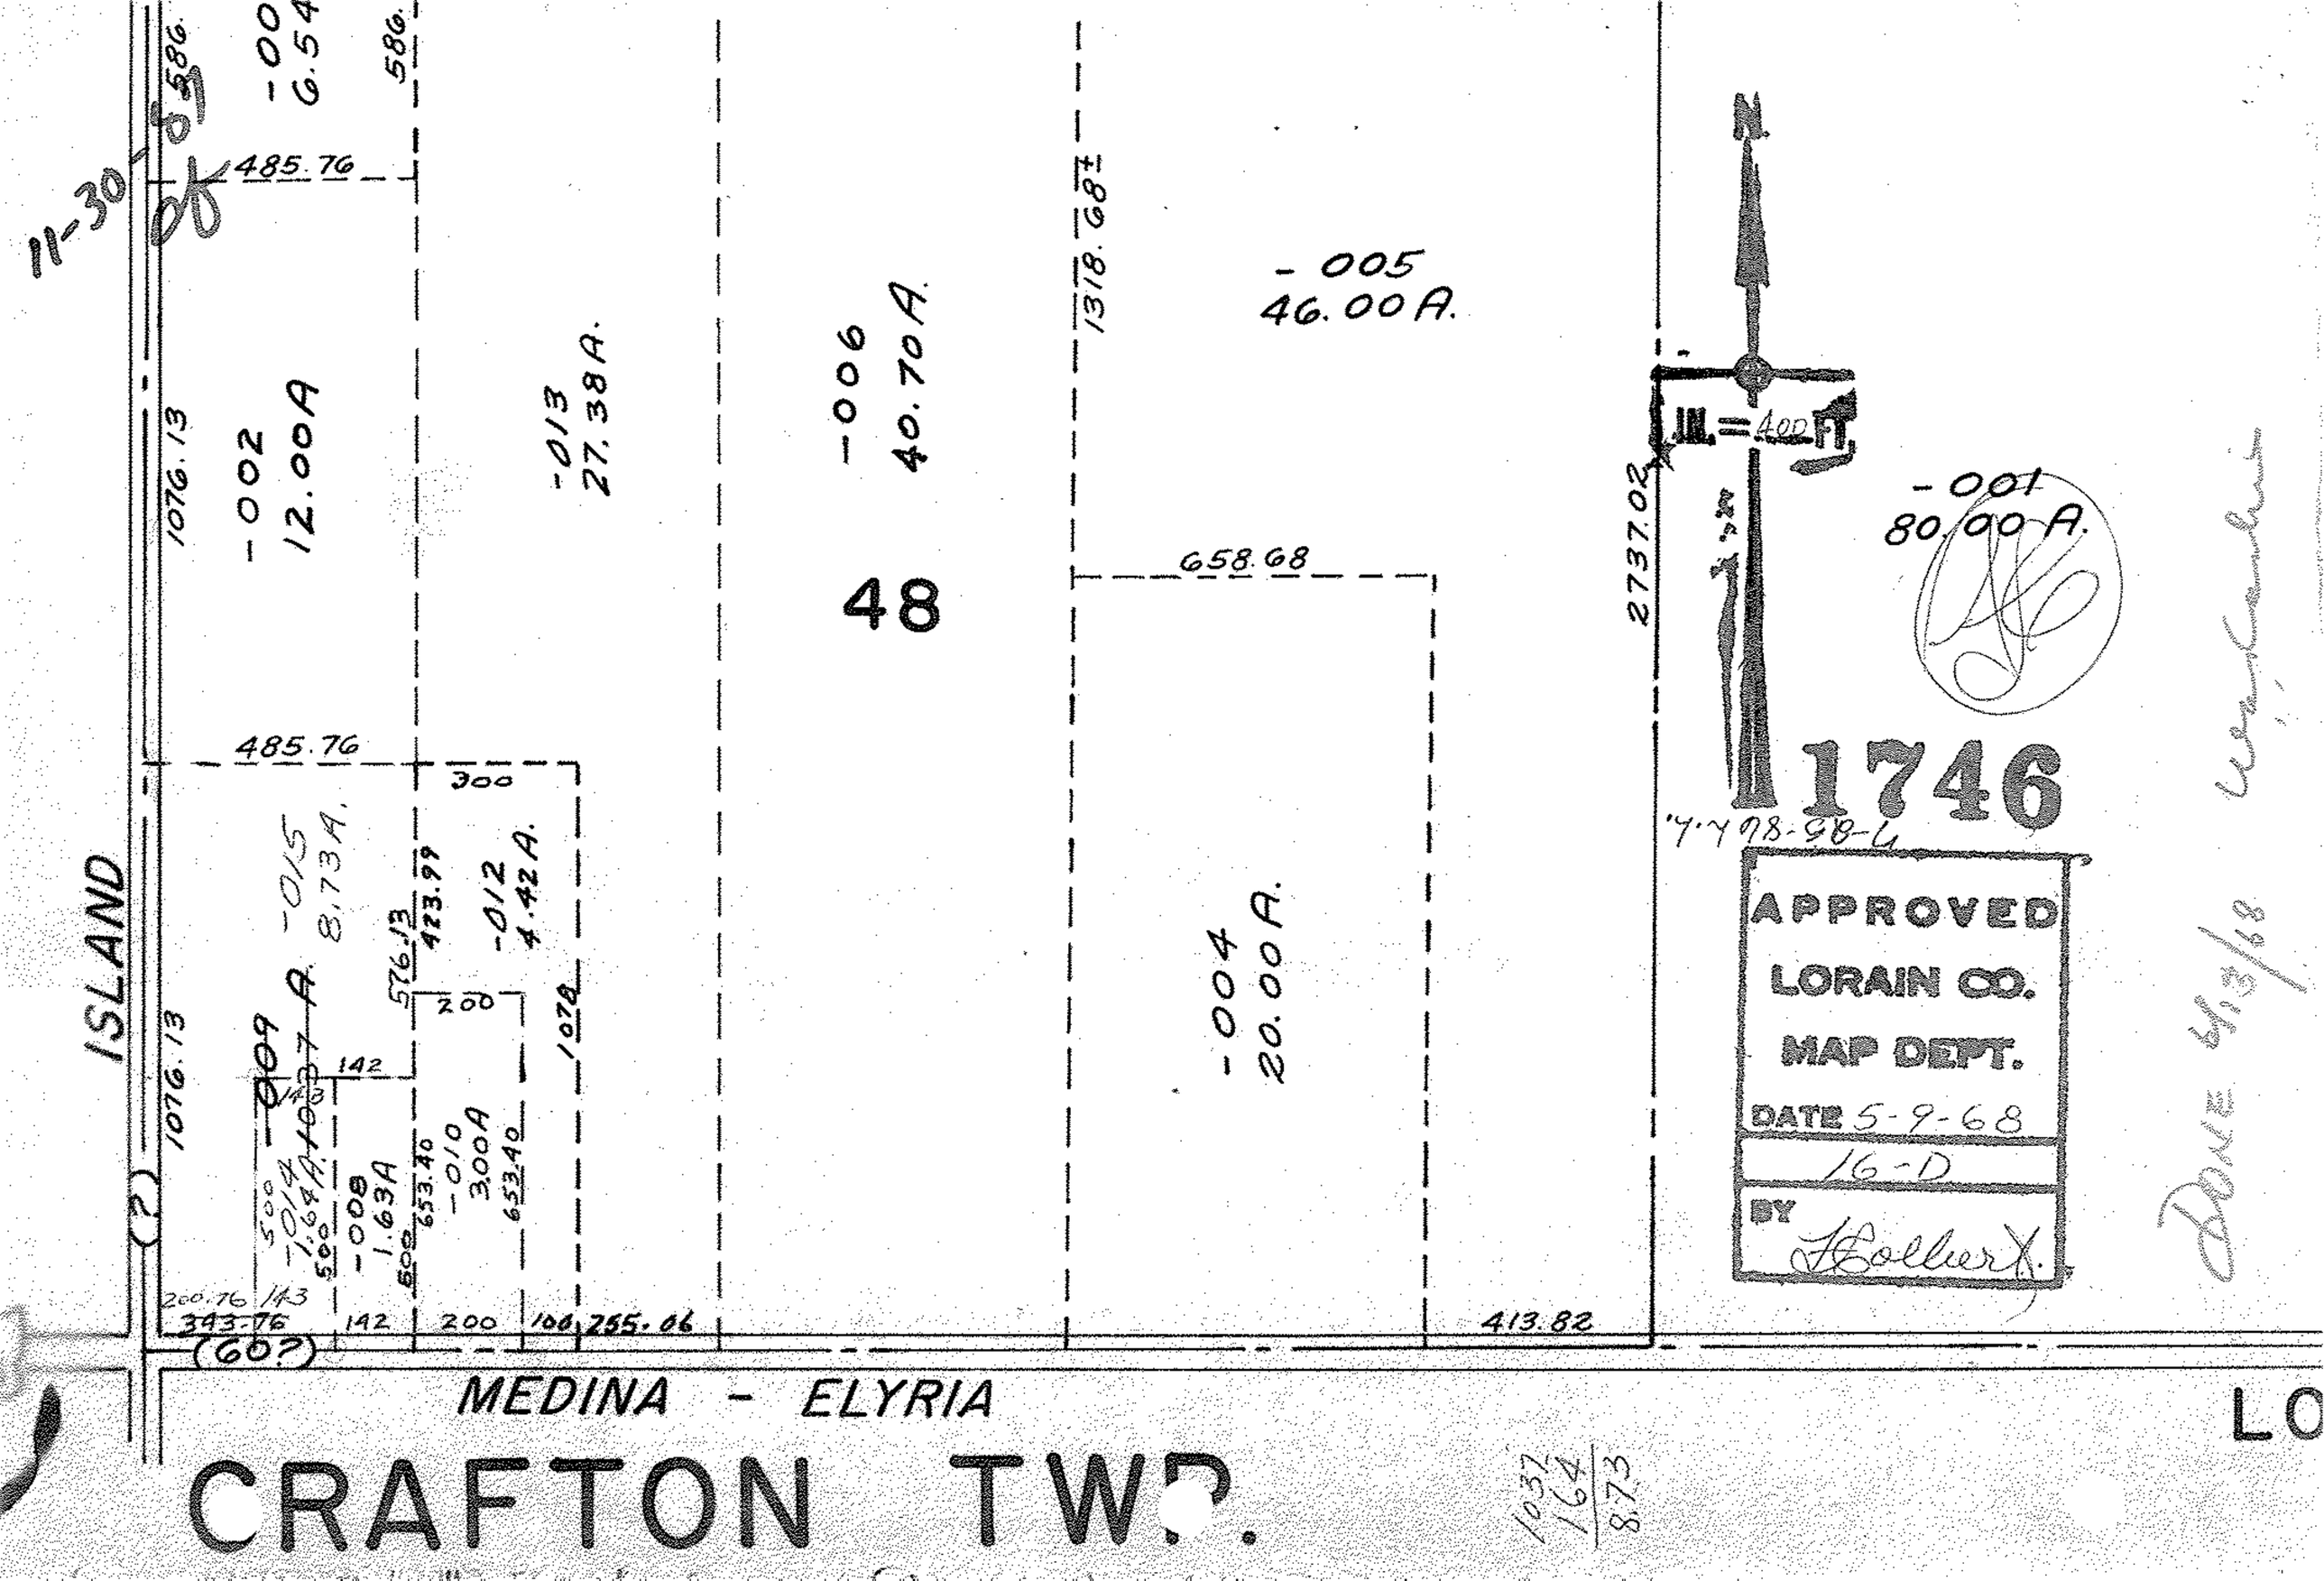

11-30-89
586.
-00
6.54
586.
485.76
1076.13
-002
12.00A
-013
27.38A.
-006
40.70A.
1318.68±
-005
46.00A.
48
658.68
2737.02
JL = 400 FT.
-001
80.00A.
1746
485.76
300
-015
8.73A.
423.99
-012
4.42A.
576.13
200
1078
142
-009
1.037 A.
143
-014
1.64A.
500
-008
1.63A
500
653.40
-010
3.00A
653.40
-004
20.00A.
ISLAND
1076.13
(?)
200.76
143
343.76
142
200
100
255.06
413.82
(60?)
MEDINA - ELYRIA
APPROVED
LORAIN CO.
MAP DEPT.
DATE 5-9-68
16-D
BY
LO
CRAFTON TWP.
1037
164
8.73