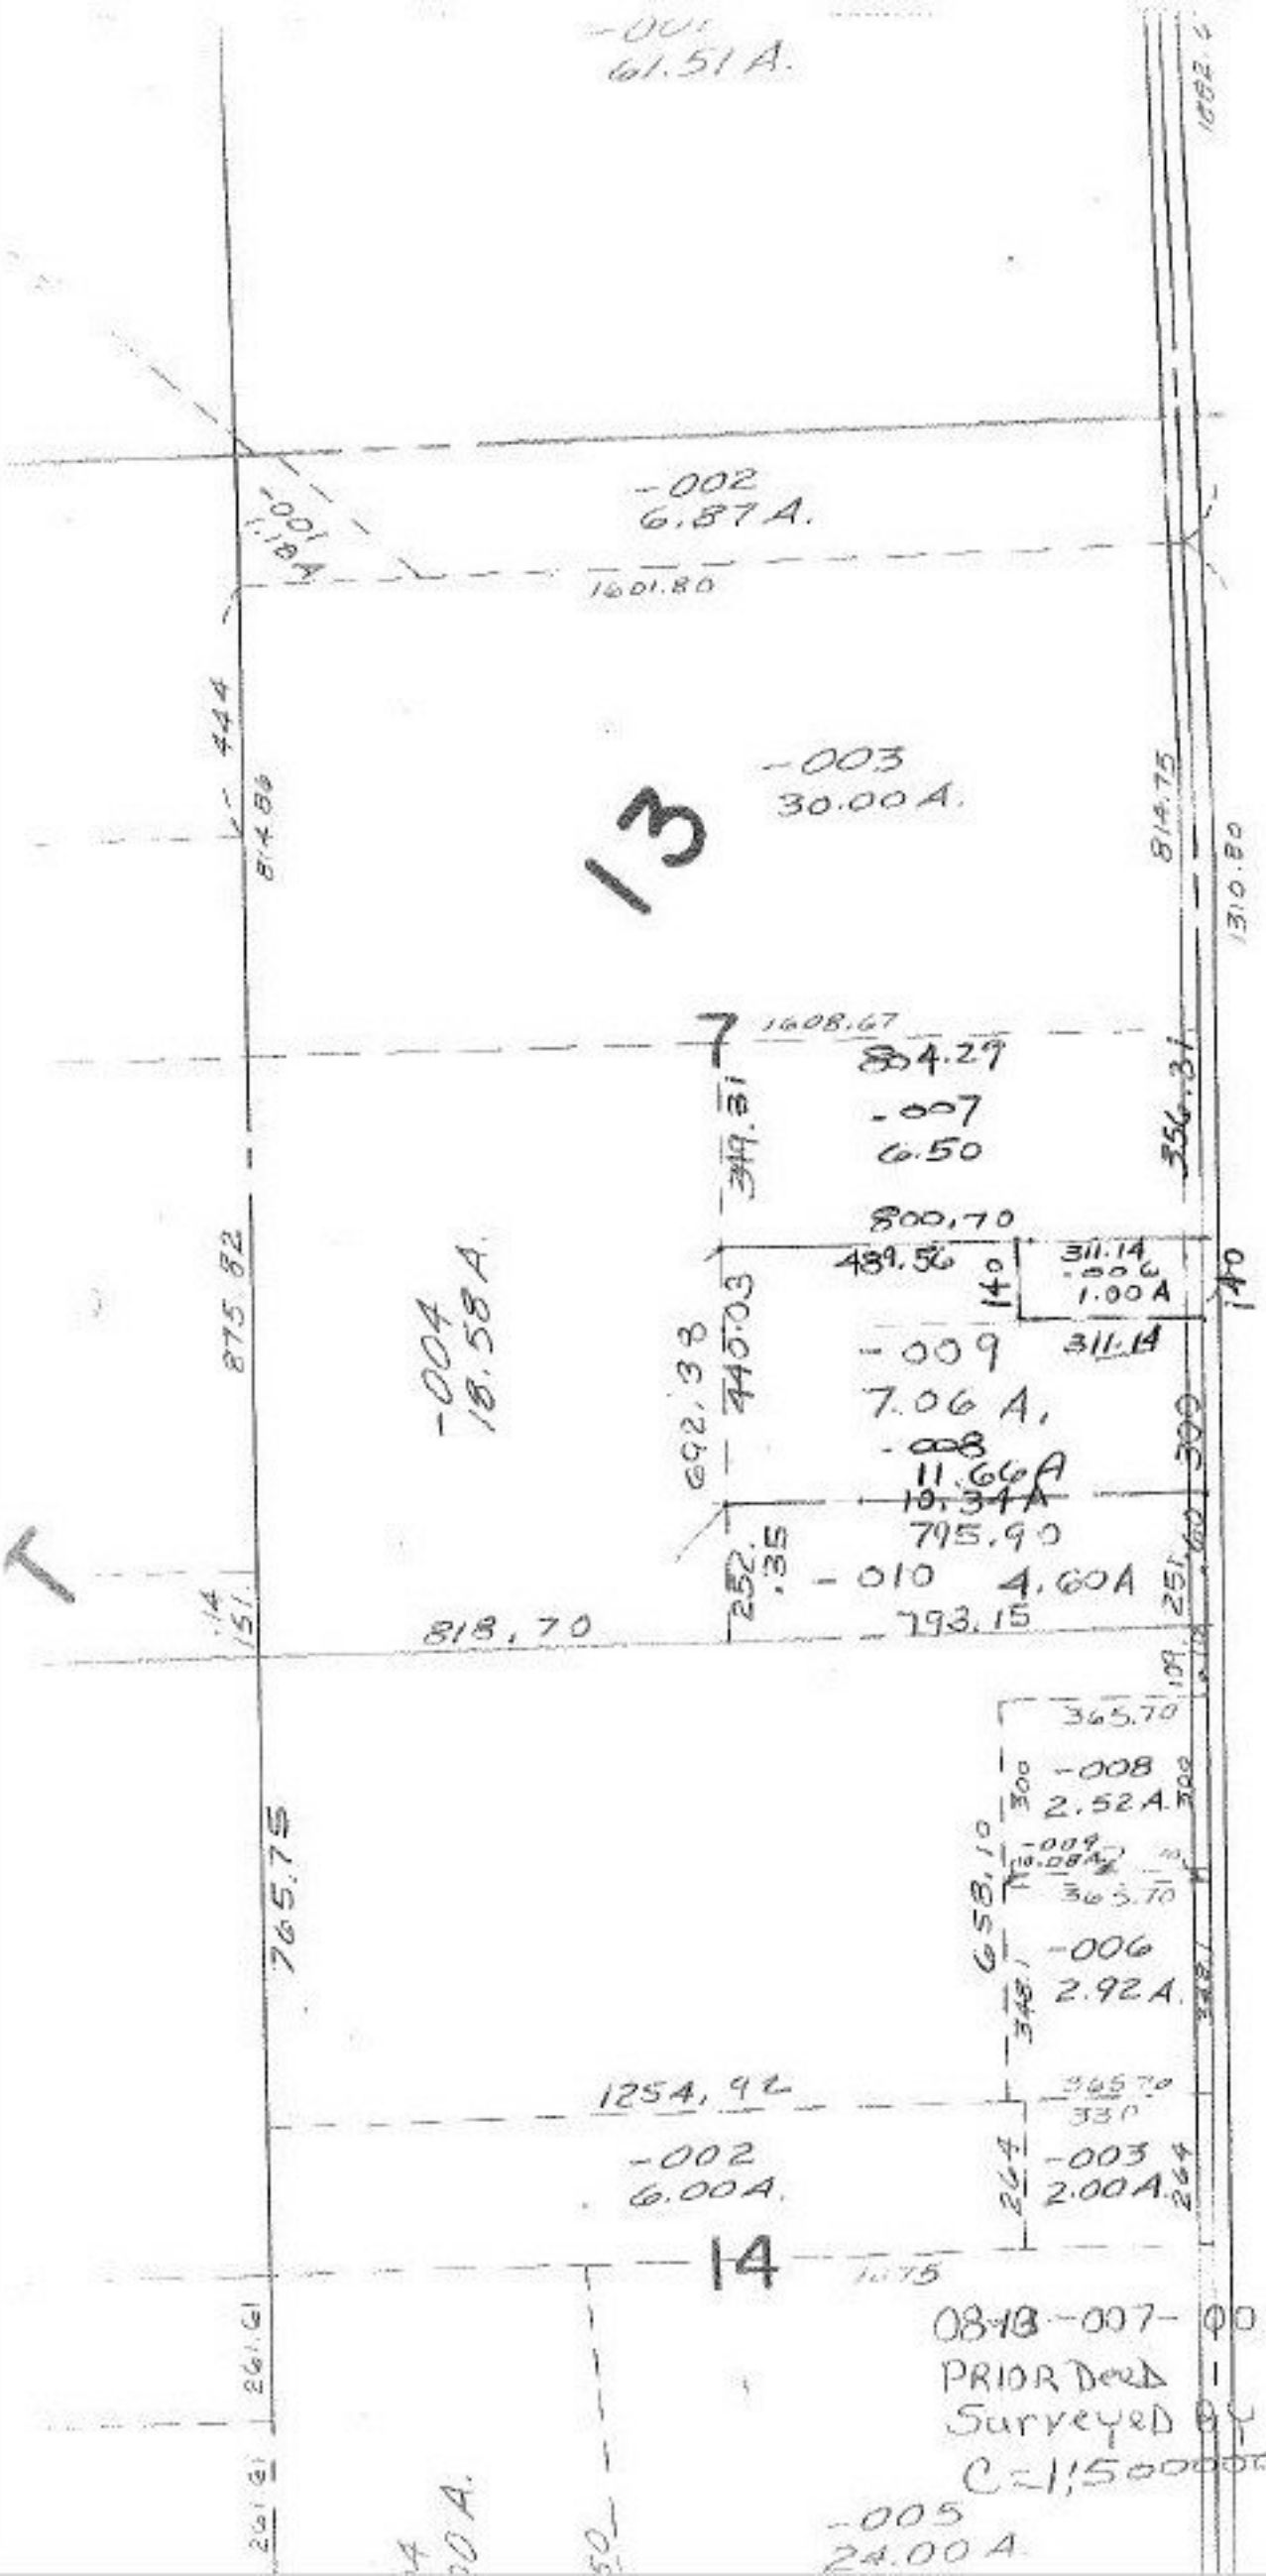

S.C. 07-09-87

#17468

APPROVED
LORAIN CO.
MAP DEPT.

DATE 6-8-87

PAGE 8-G

BY C. FRANCIS

VOID AFTER 17468