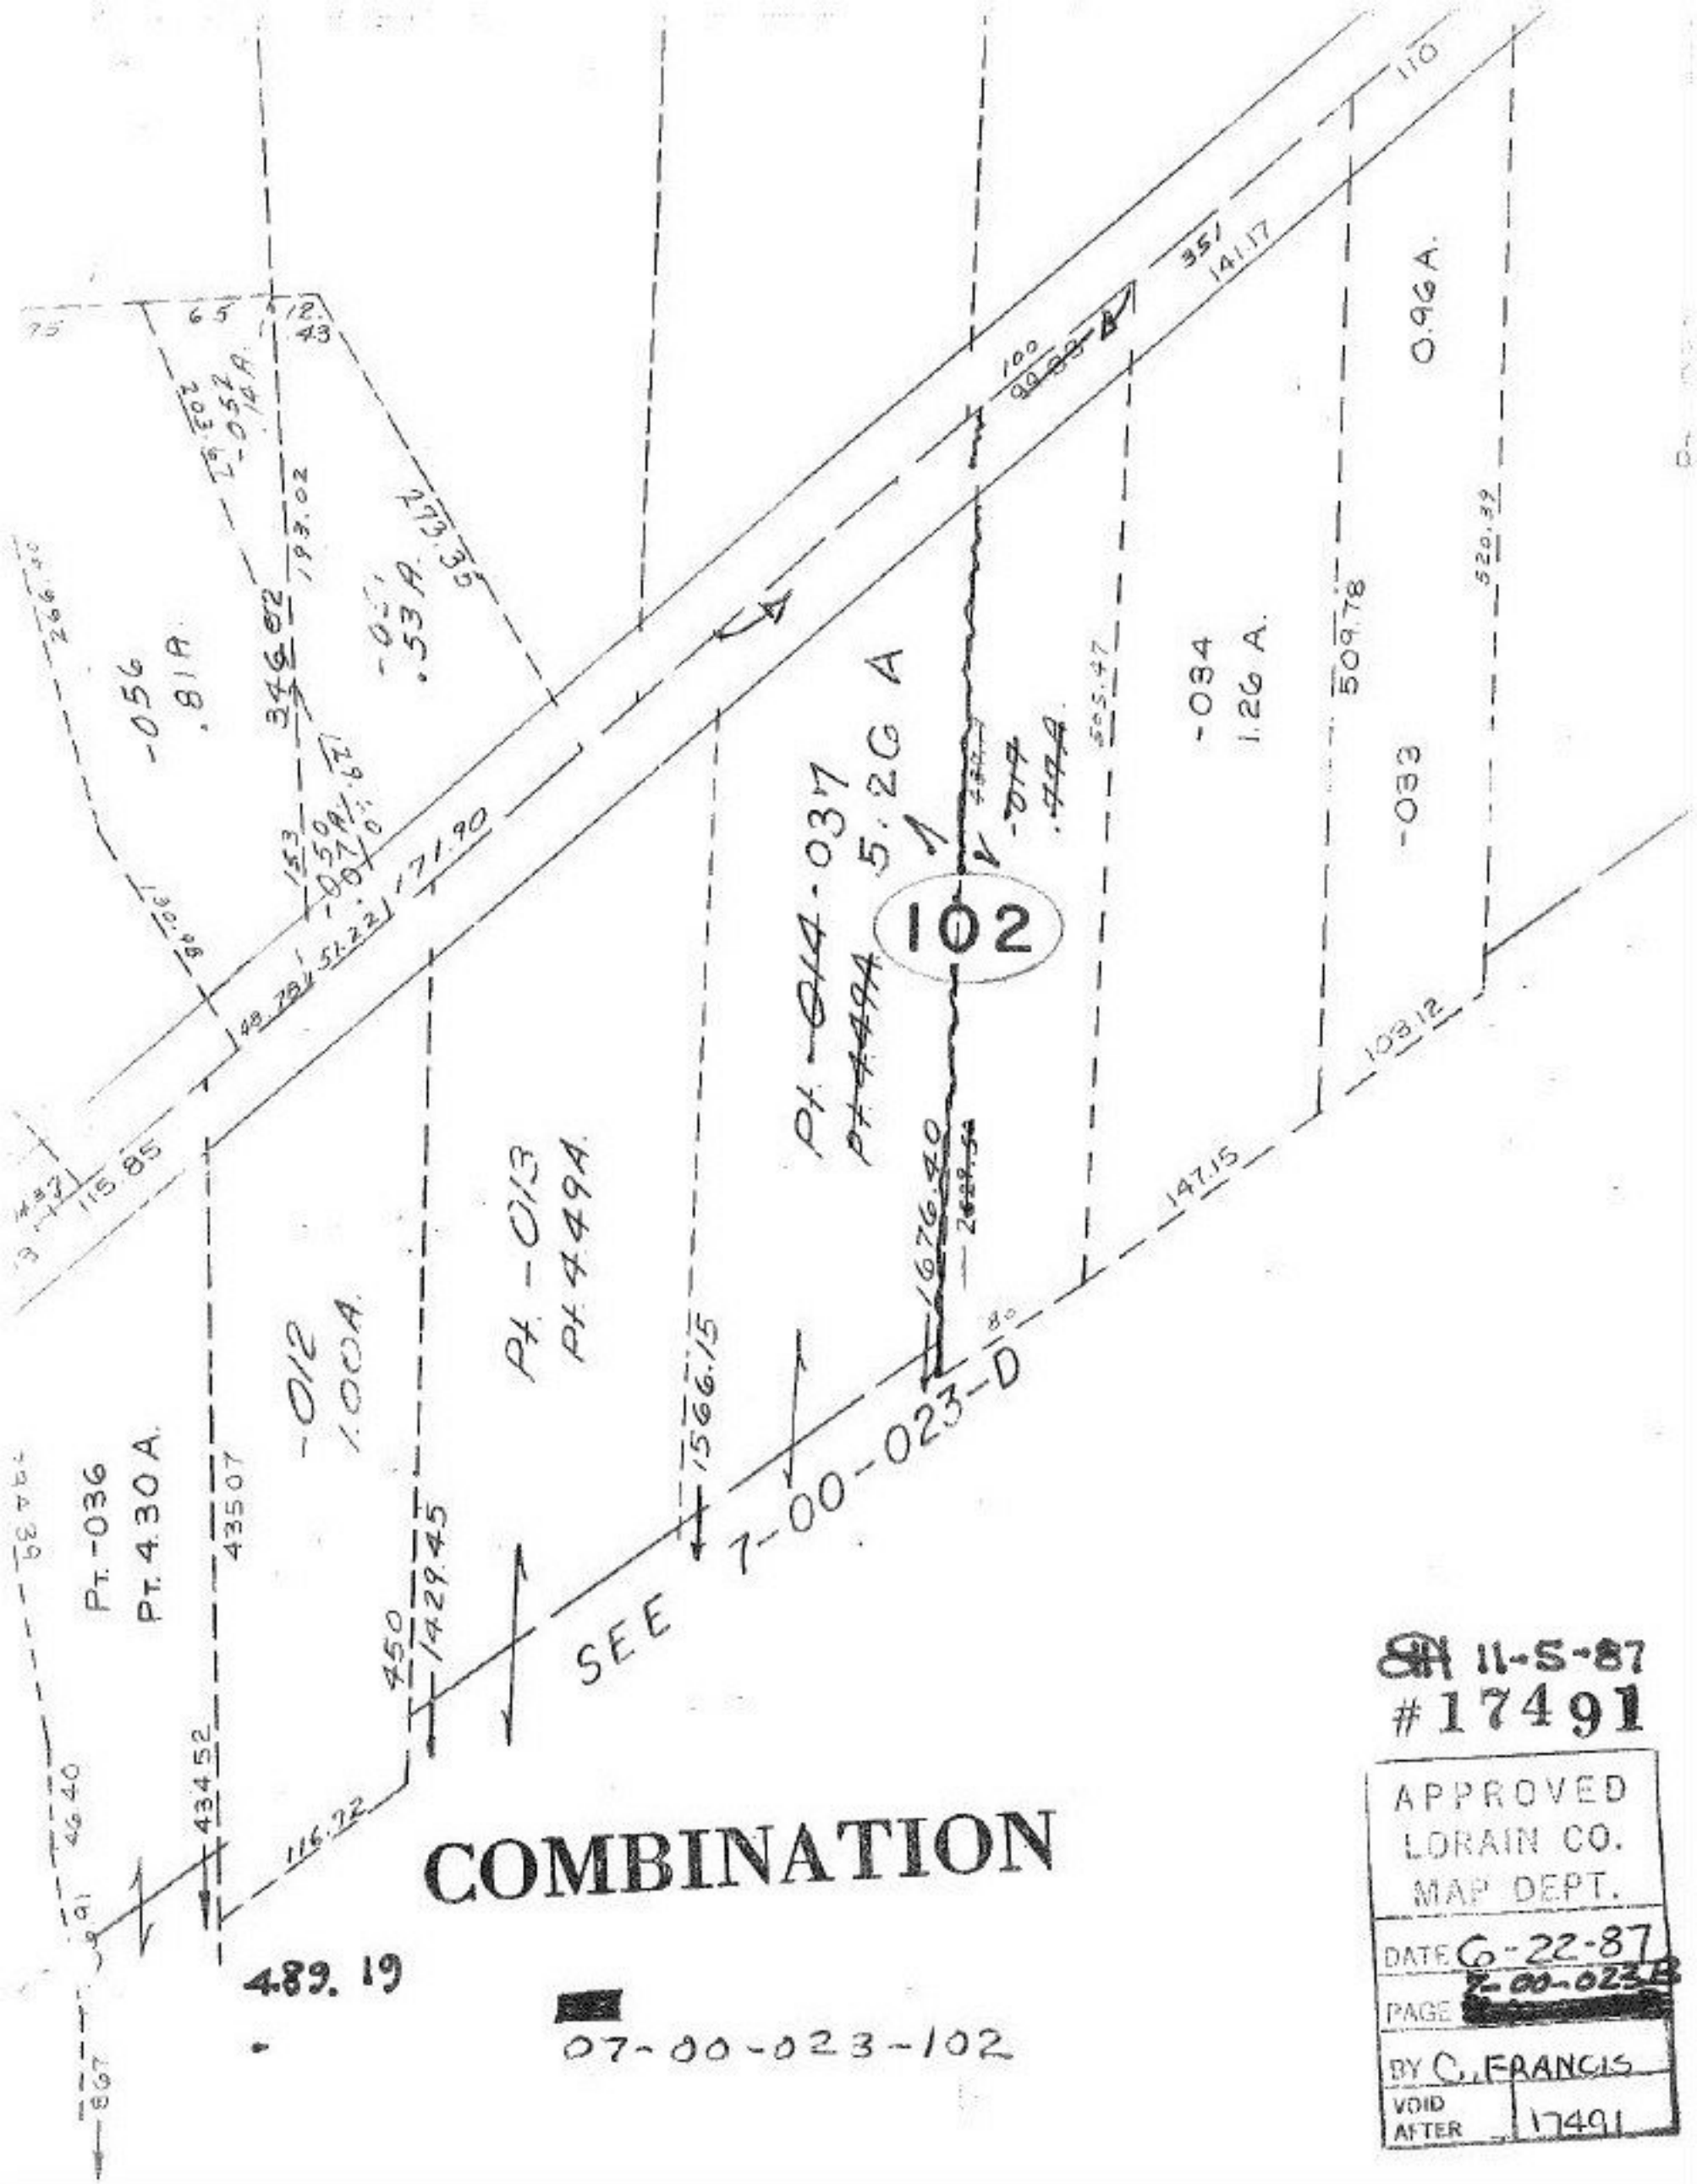

COMBINATION