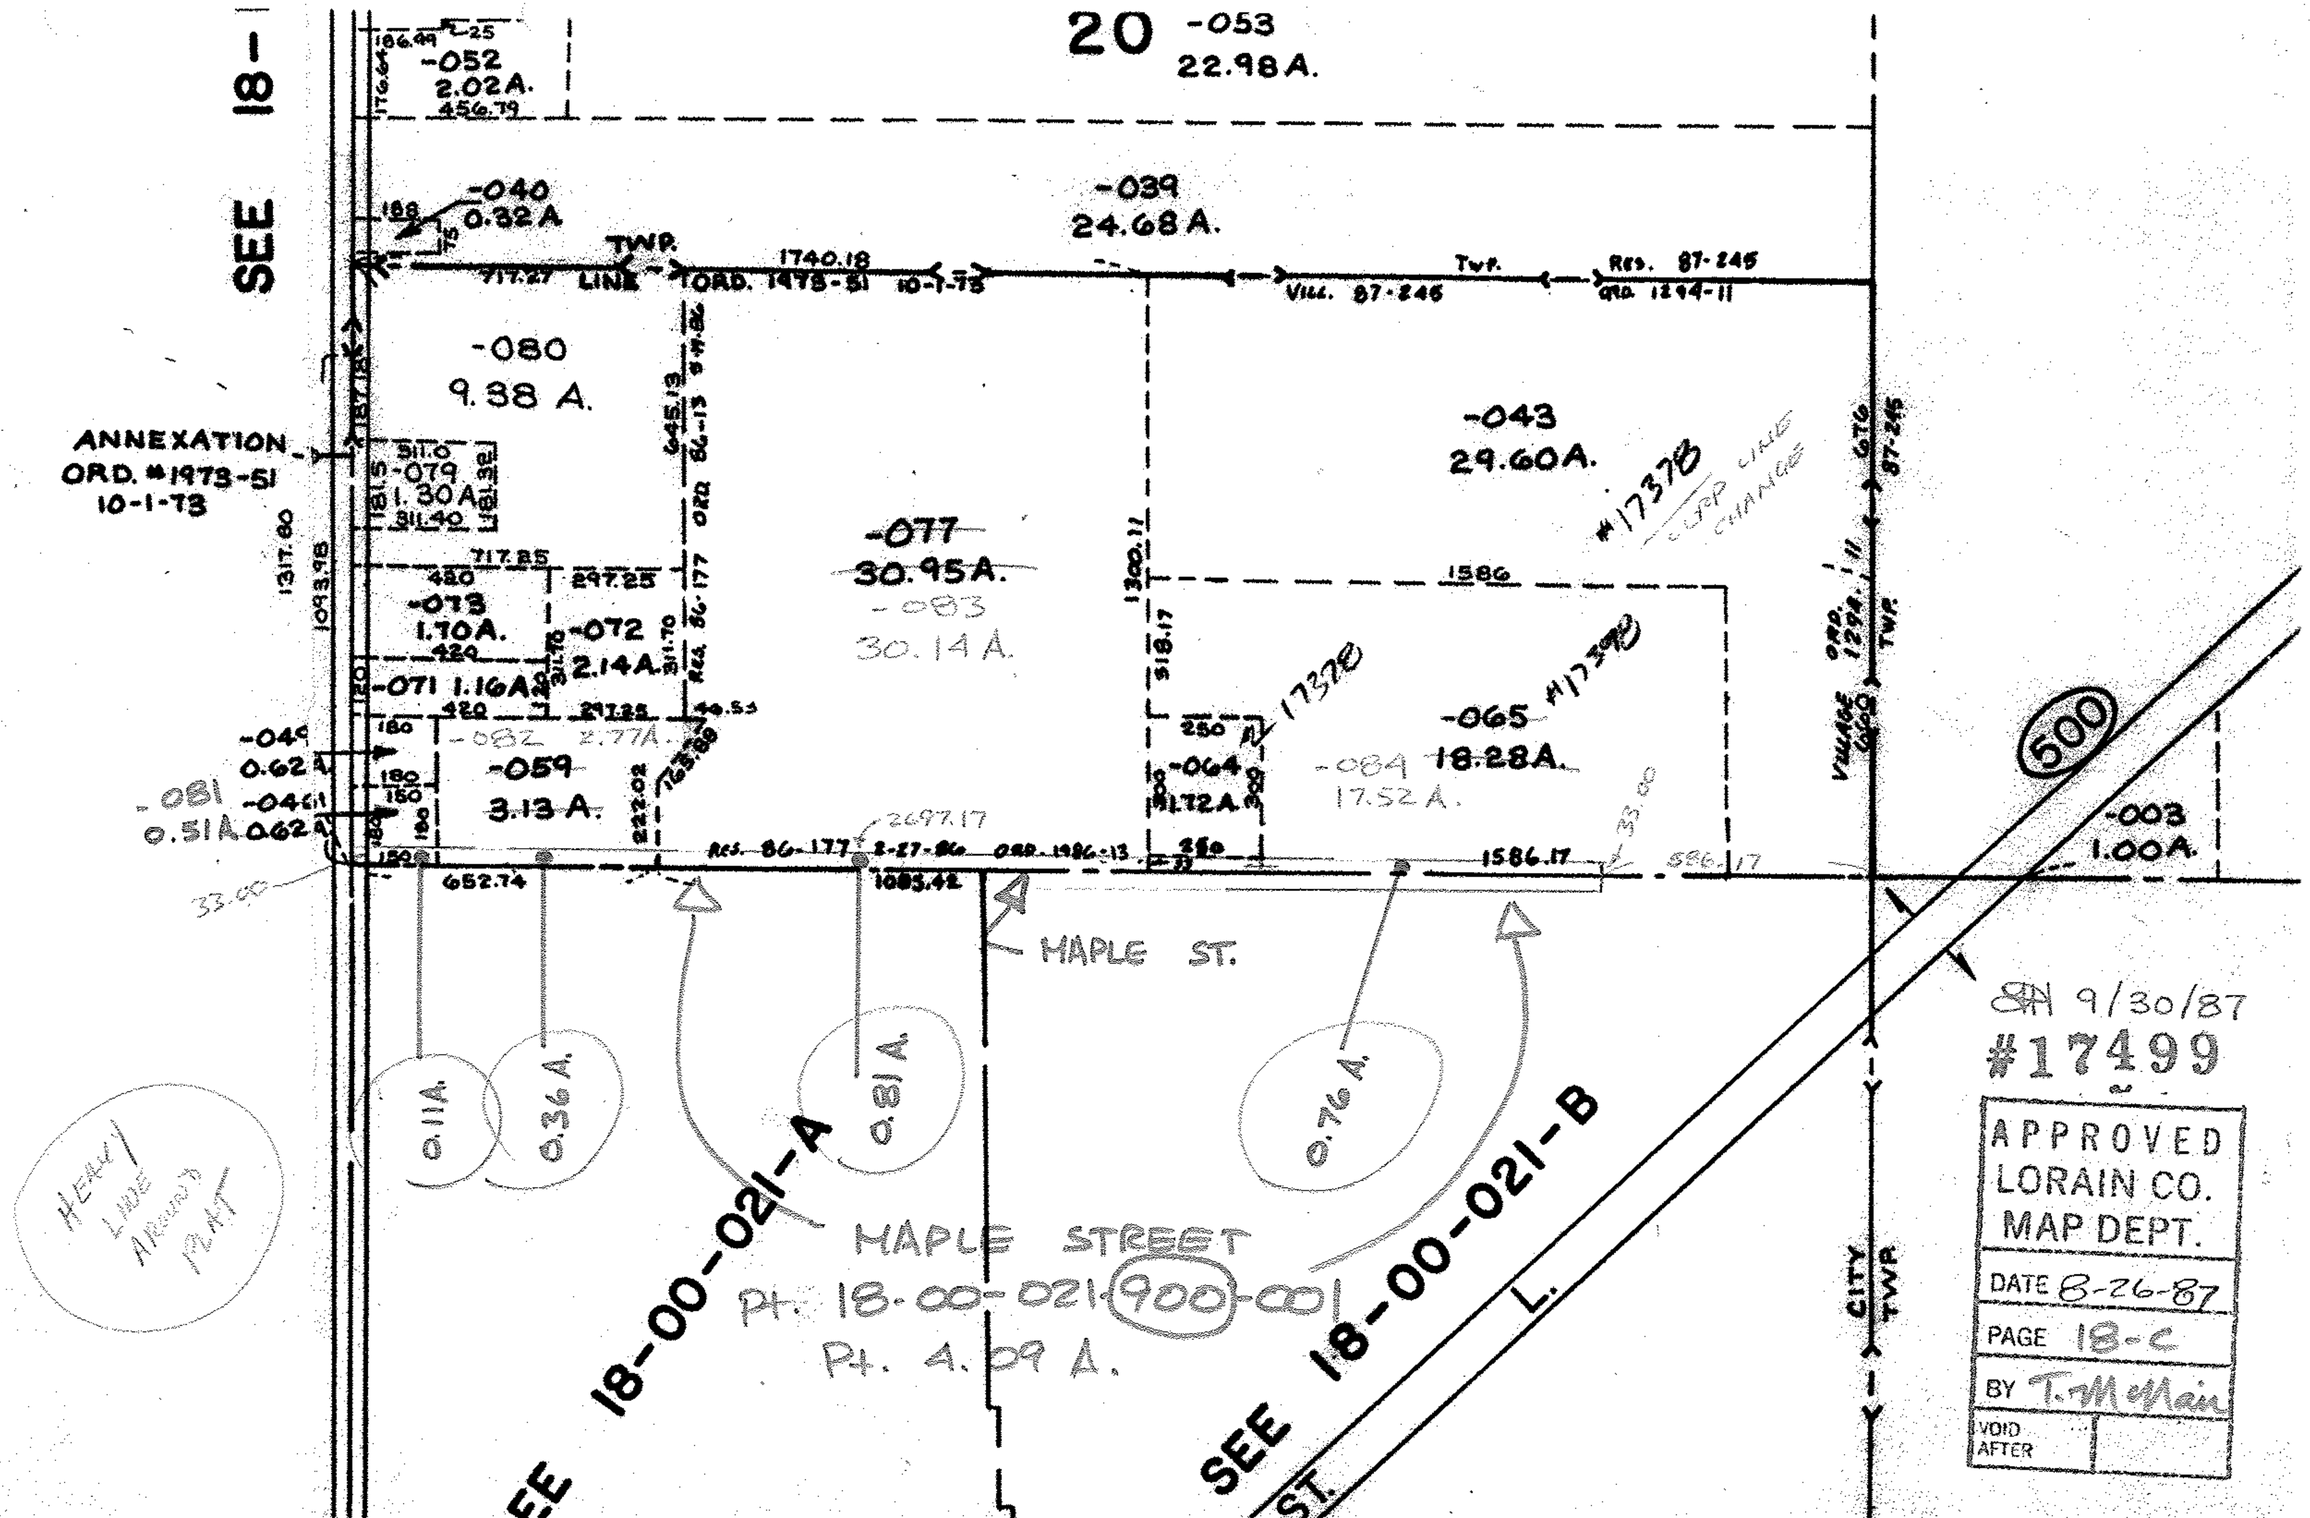

SEE 18-
20
-053
22.98 A.
-052
2.02 A.
-040
0.32 A
-039
24.68 A.
TWP. LINE
ORD. 1973-51 10-1-73
1740.18
717.27
VILL. 87-245
TWP.
RES. 87-245
ORD. 1294-11
-080
9.38 A.
ANNEXATION
ORD. #1973-51
10-1-73
-079
1.30 A
-043
29.60 A.
#17378
CLPP LINE CHANGE
-077
30.95 A.
-083
30.14 A.
-073
1.70 A.
-072
2.14 A.
-071 1.16 A
-082 2.77 A.
-059
3.13 A.
-049
0.62 A
-081
0.51 A
-065
18.28 A.
-084
17.52 A.
-064
1.72 A.
-003
1.00 A.
1586
1586.17
652.74
1083.42
2697.17
RES. 86-177
ORD. 1986-13
MAPLE ST.
0.11 A.
0.36 A.
0.81 A.
0.76 A.
MAPLE STREET
Pt. 18-00-021-900-001
Pt. 4.09 A.
SEE 18-00-021-A
SEE 18-00-021-B
HEAVY LINE AROUND PLAT
500
CITY TWP.
VILLAGE
ORD. 1294-11
TWP.
676
87-245
9/30/87
#17499
APPROVED
LORAIN CO.
MAP DEPT.
DATE 8-26-87
PAGE 18-C
BY T. McMain
VOID AFTER