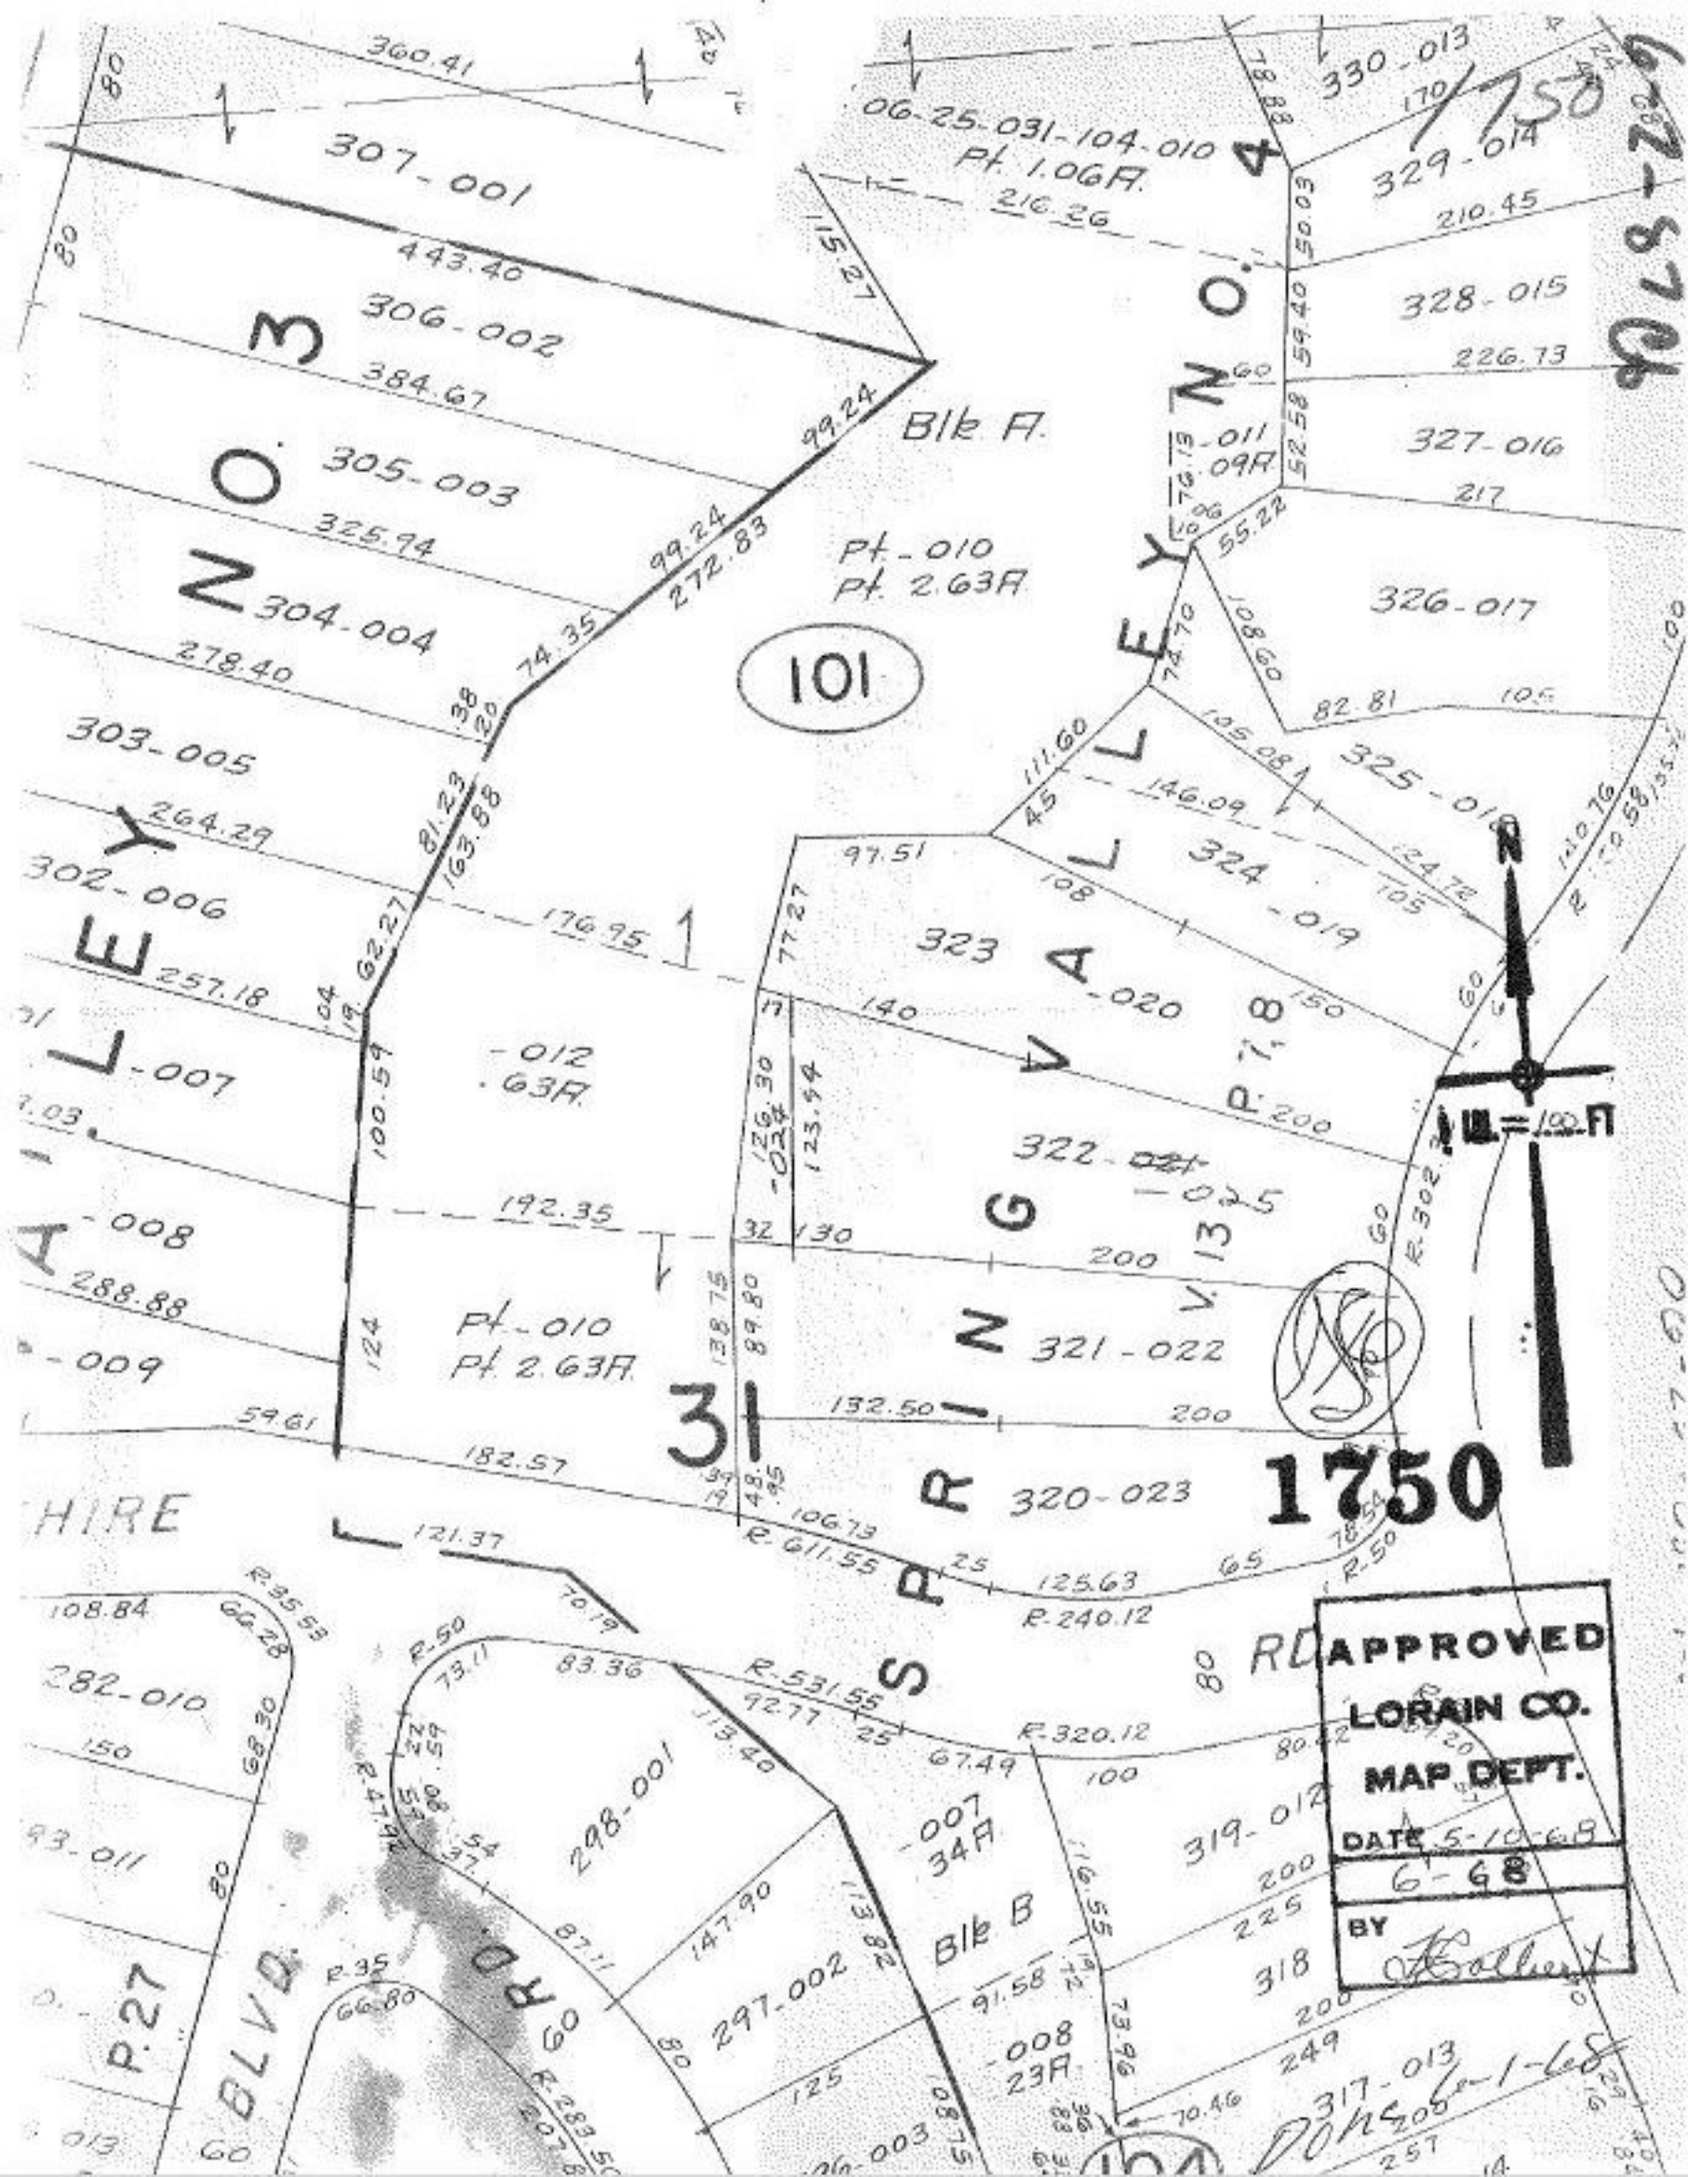
360.41
307-001
443.40
306-002
384.67
305-003
325.94
304-004
278.40
303-005
264.29
302-006
257.18
-007
288.88
-008
-009
59.61
182.57
192.35
176.95
-012
.63A.
Pt.-010
Pt. 2.63A.
06-25-031-104-010
Pt. 1.06A.
216.26
Blk A.
Pt.-010
Pt. 2.63A.
101
272.83
99.24
74.35
81.23
163.88
62.27
100.59
330-013
329-014
328-015
327-016
326-017
325-016
324-019
323-020
322-021
321-022
320-023
-011
1.09A.
-024
123.54
129.30
146.09
111.60
97.51
77.27
140
130
200
132.50
106.73
611.55
125.63
240.12
NO. 4 VALLEY
NO. 3 VALLEY
SPRING VALLEY
P. 7, 8
V. 13
P. 200
P. 302
1" = 100 FT
N
1750
1750
80 RD
HIRE
BLVD.
ROAD
282-010
298-001
297-002
-007
34A.
Blk B
-008
23A.
317-013
319-012
318
249
225
APPROVED
LORAIN CO.
MAP DEPT.
DATE 5-10-68
6-68
BY