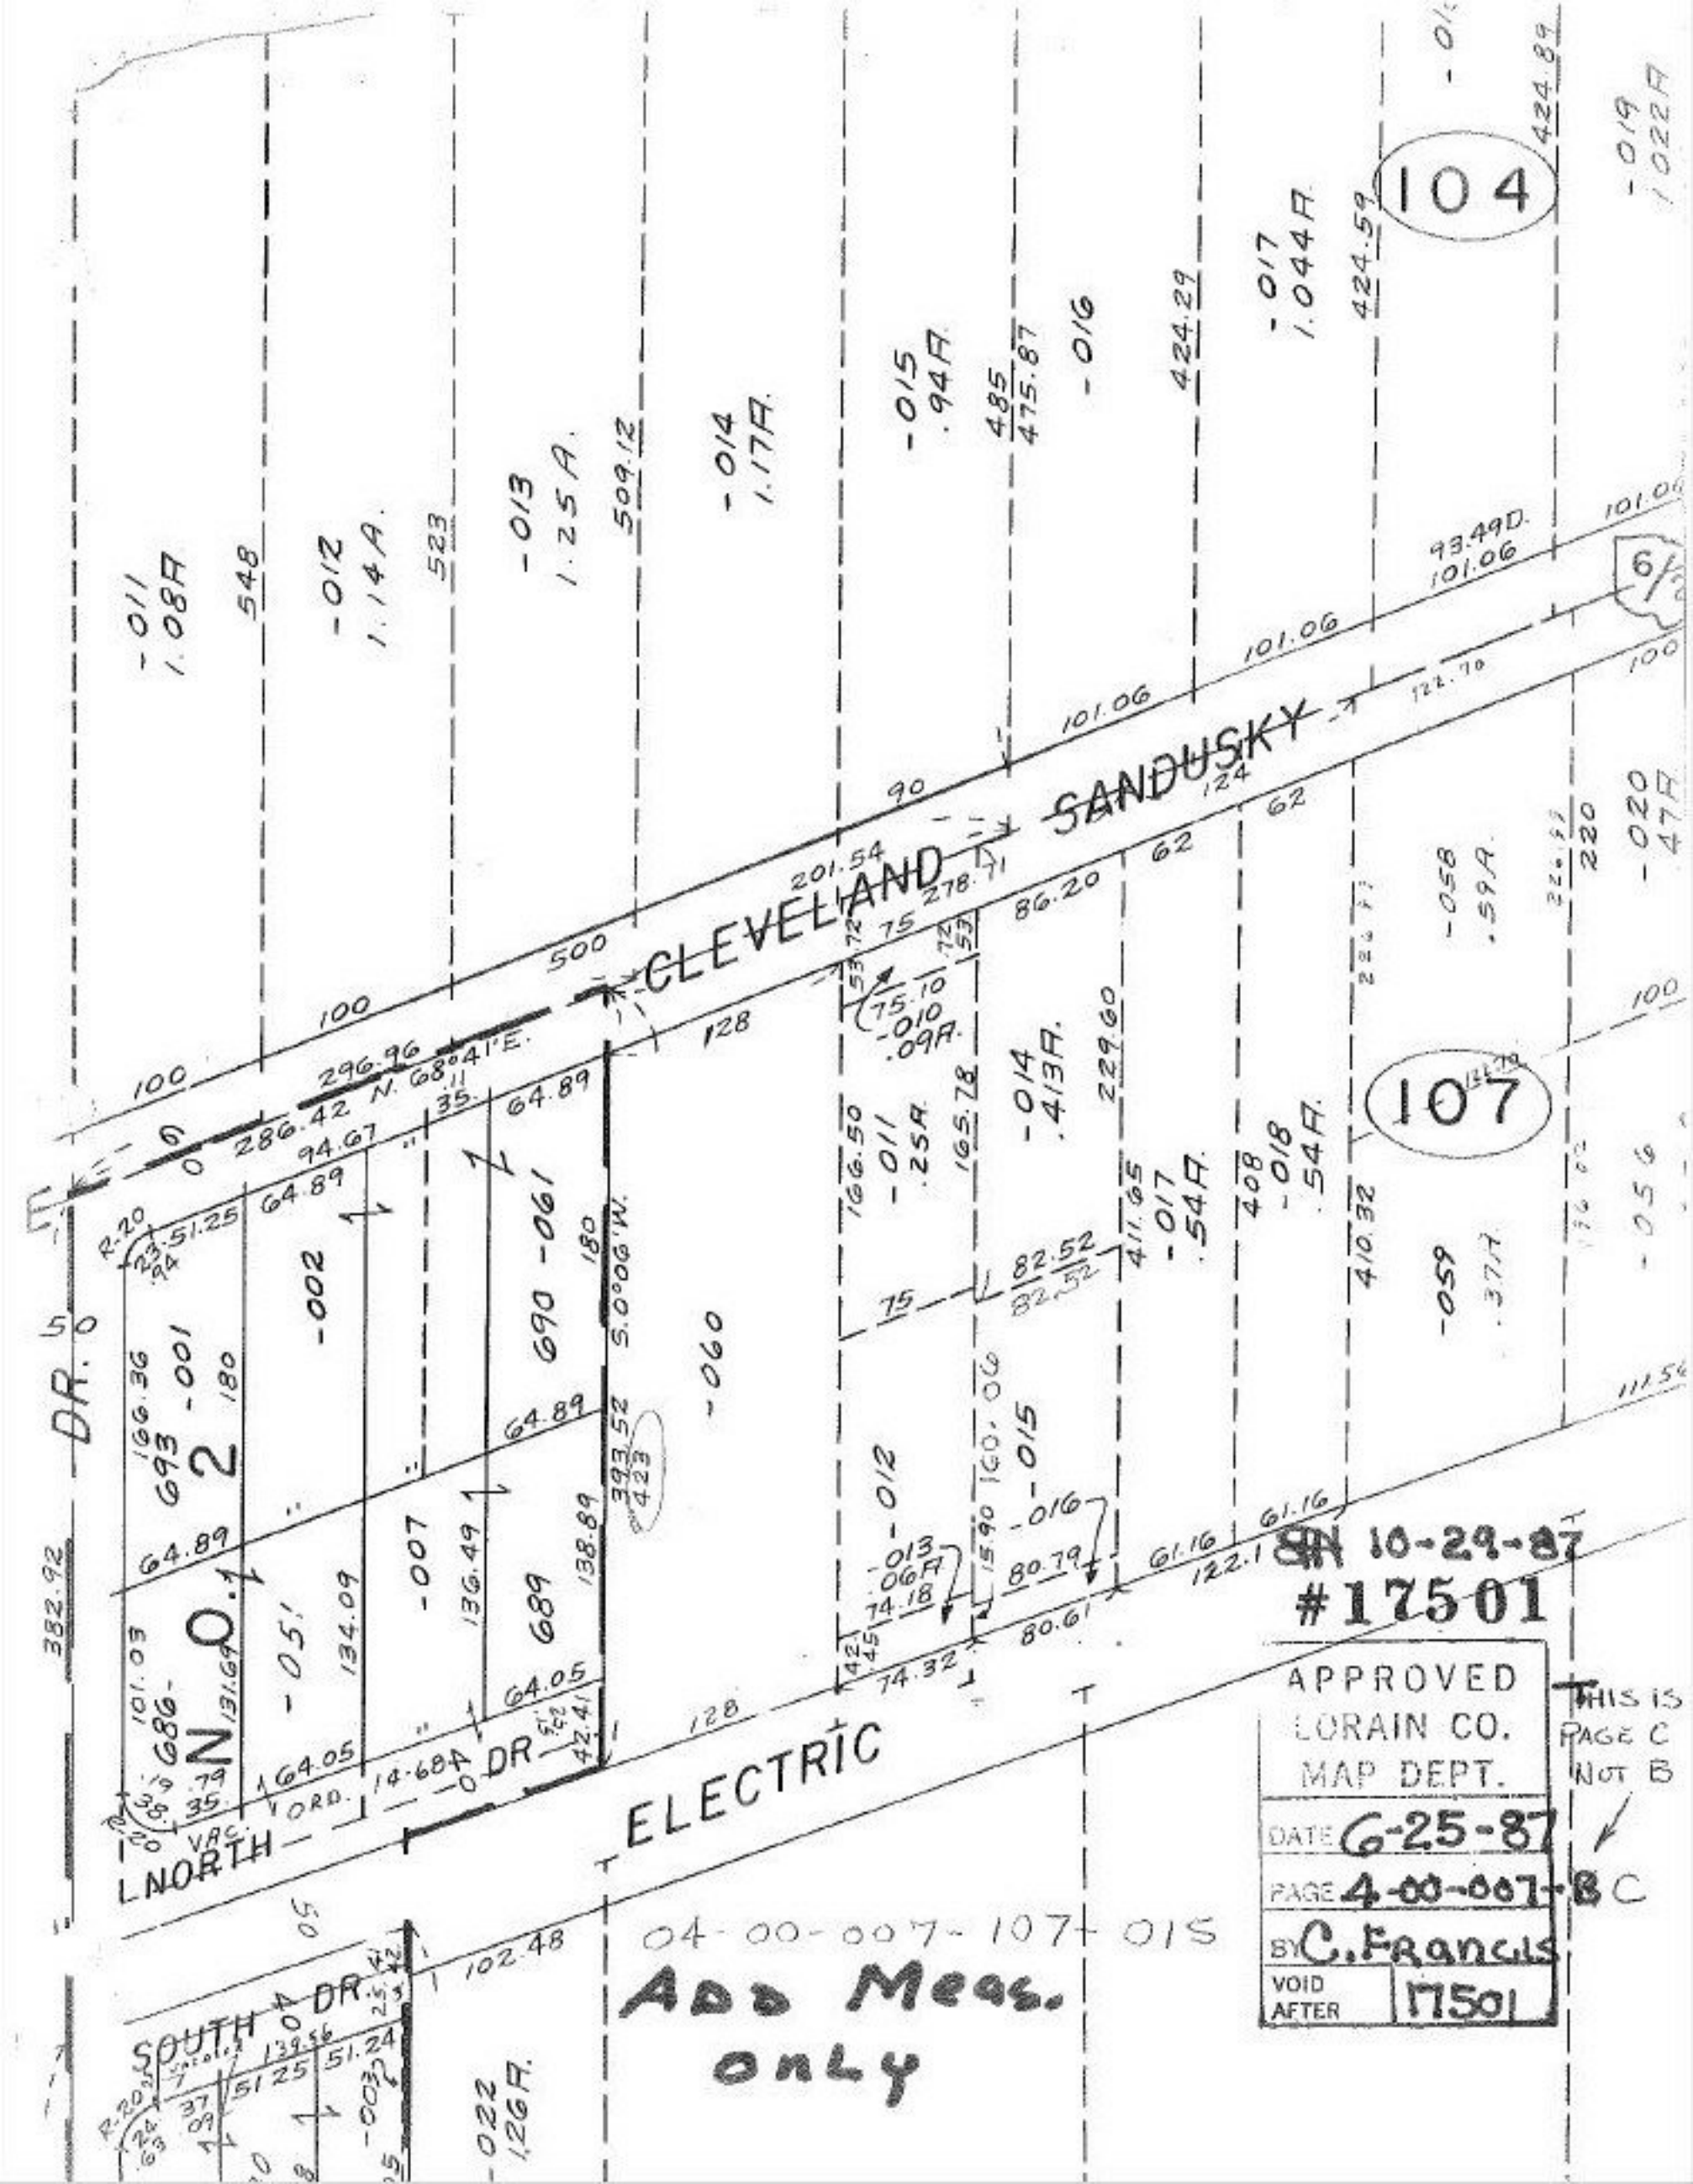
104
107
CLEVELAND SANDUSKY
NORTH ELECTRIC
NO. 2
DR.
SOUTH DR.
-011 1.08A
-012 1.14A.
-013 1.25A.
-014 1.17A.
-015 .94A.
-016
-017 1.044A.
-019 1.022A
-020 .47A
-058 .59A.
-059 .37A
-060
-061
-010 .09A.
-014 .413A.
-011 .25A.
-017 .54A.
-018 .54A.
-012
-013 .06A
-015
-016
-022 1.26A.
-001
-002
-003
-005
-007
-051
690
689
693
686
04-00-007-107-015
Add Meas. only
SN 10-29-87
#17501
APPROVED
LORAIN CO.
MAP DEPT.
DATE 6-25-87
PAGE 4-00-007-B C
BY C. Francis
VOID AFTER 17501
THIS IS PAGE C NOT B