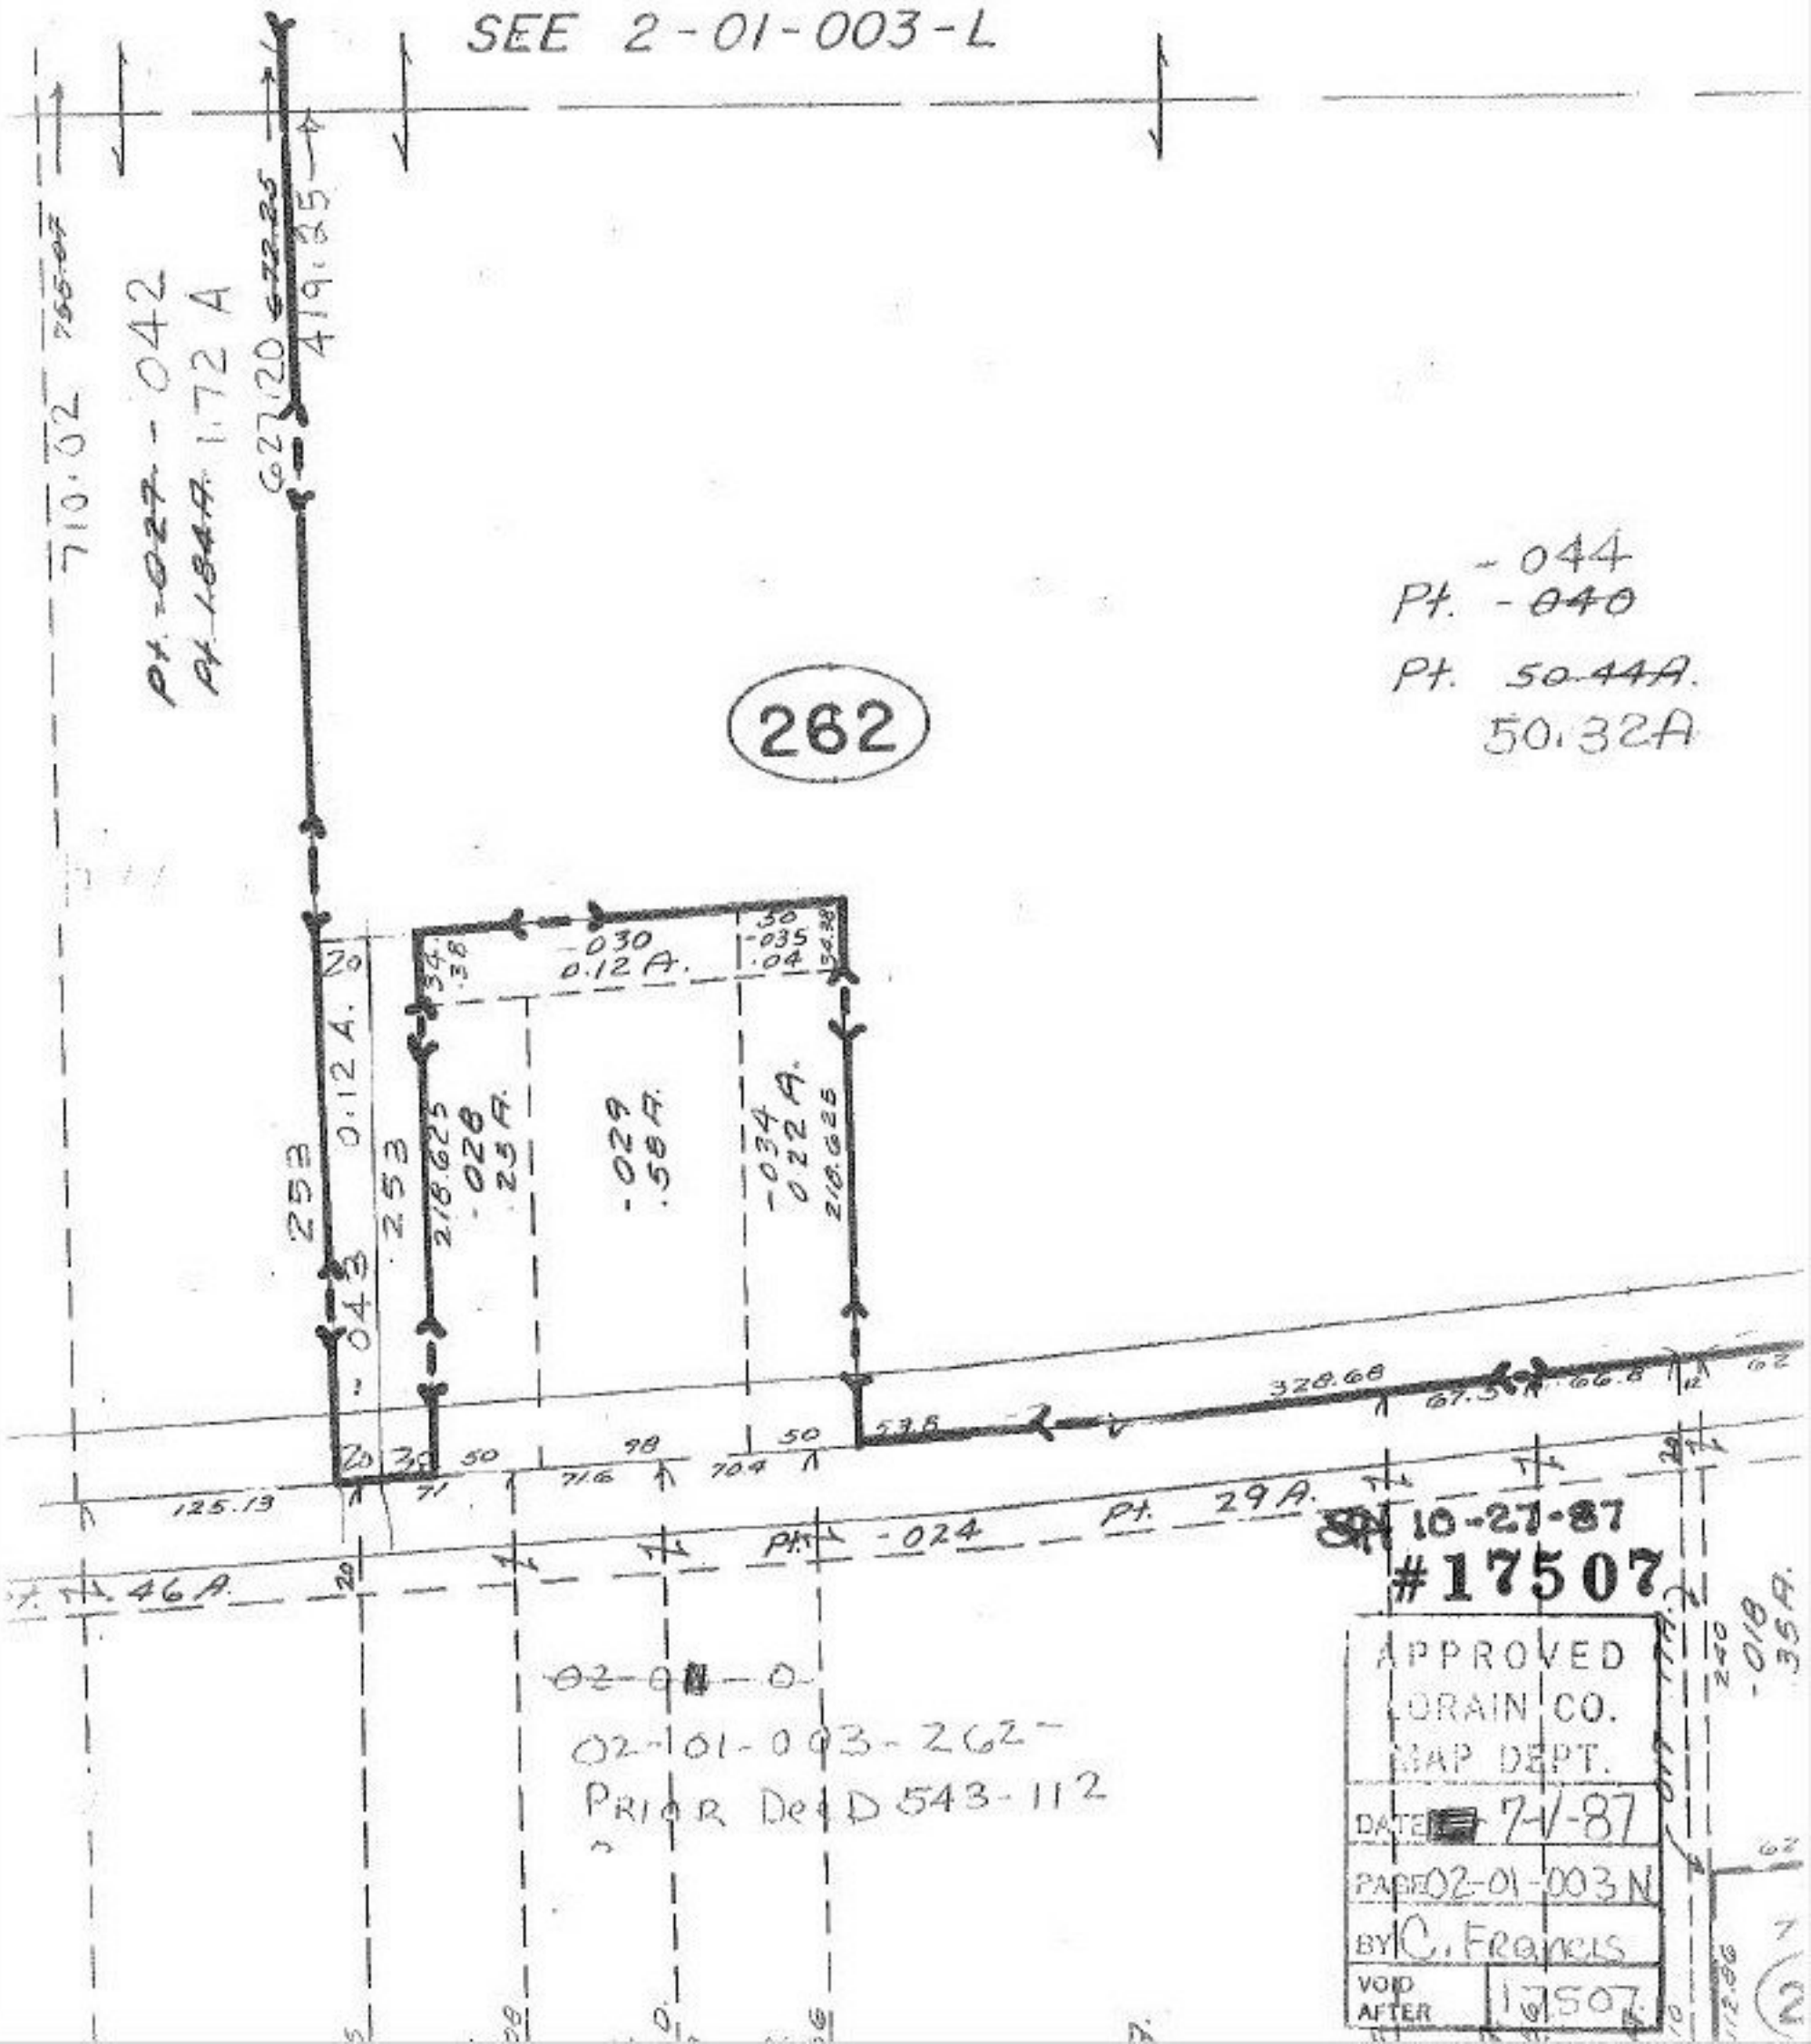
SEE 2-01-003-L
710.02
Pt. -027 - 042
Pt. 1.84A 1.72 A
627.20
419.25
262
-044
Pt. -040
Pt. 50.44A.
50.32A
-030
0.12 A.
-035
.04
0.12 A.
253
253
218.625
-028
.23 A.
-029
.58 A.
-034
0.22 A.
218.625
328.68
125.13
Pt. -024
Pt. 29 A.
46 A.
10-27-87
#17507
APPROVED
LORAIN CO.
MAP DEPT.
DATE 7-1-87
PAGE 02-01-003 N
BY C. Francis
VOID AFTER 17507
02-01-003-262
PRIOR DEED 543-112