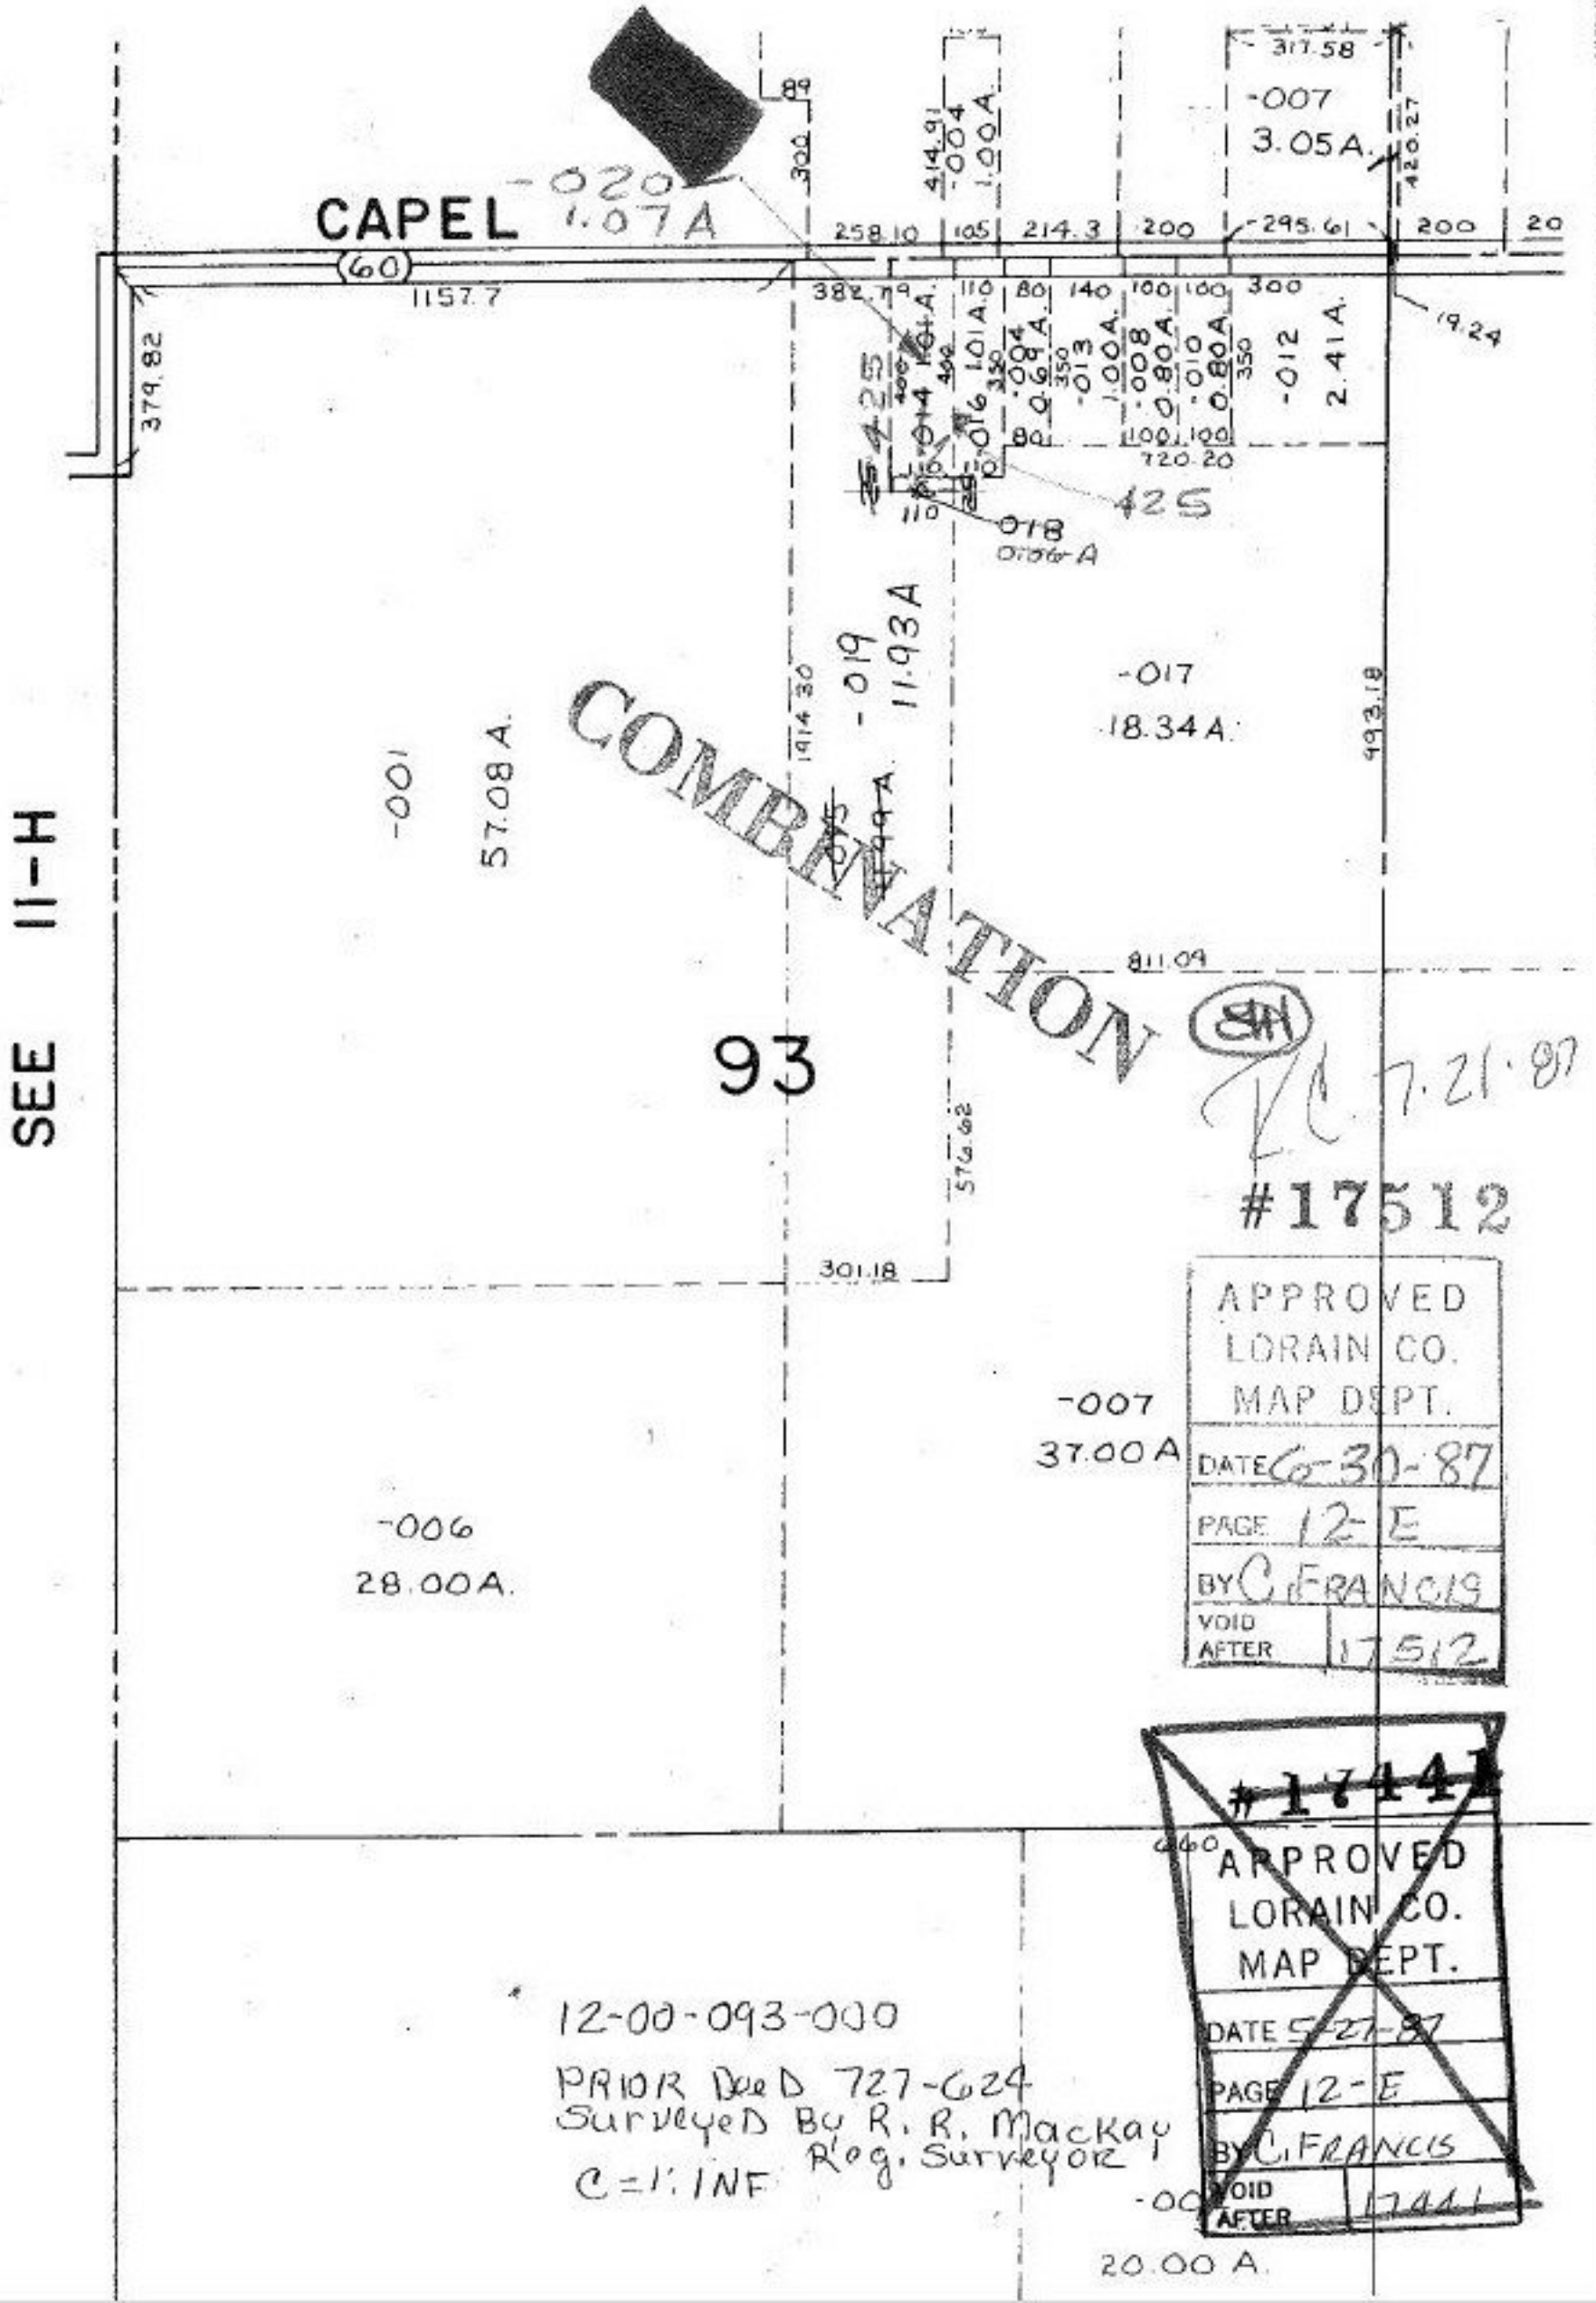
CAPEL
-020
1.07A
-007
3.05A.
-004
1.00A.
-012
2.41A.
-018
-019
11.93A
-017
18.34A.
-001
57.08A.
93
-007
37.00A
-006
28.00A.
-00
20.00 A.
SEE 11-H
COMBINATION
#17512
APPROVED
LORAIN CO.
MAP DEPT.
DATE 6-30-87
PAGE 12-E
BY C. FRANCIS
VOID AFTER 17512
#17441
APPROVED
LORAIN CO.
MAP DEPT.
DATE 5-27-87
PAGE 12-E
BY C. FRANCIS
VOID AFTER 17441
12-00-093-000
PRIOR DeeD 727-624
SurveyeD By R. R. Mackay
Reg. Surveyor
C=1:1NF