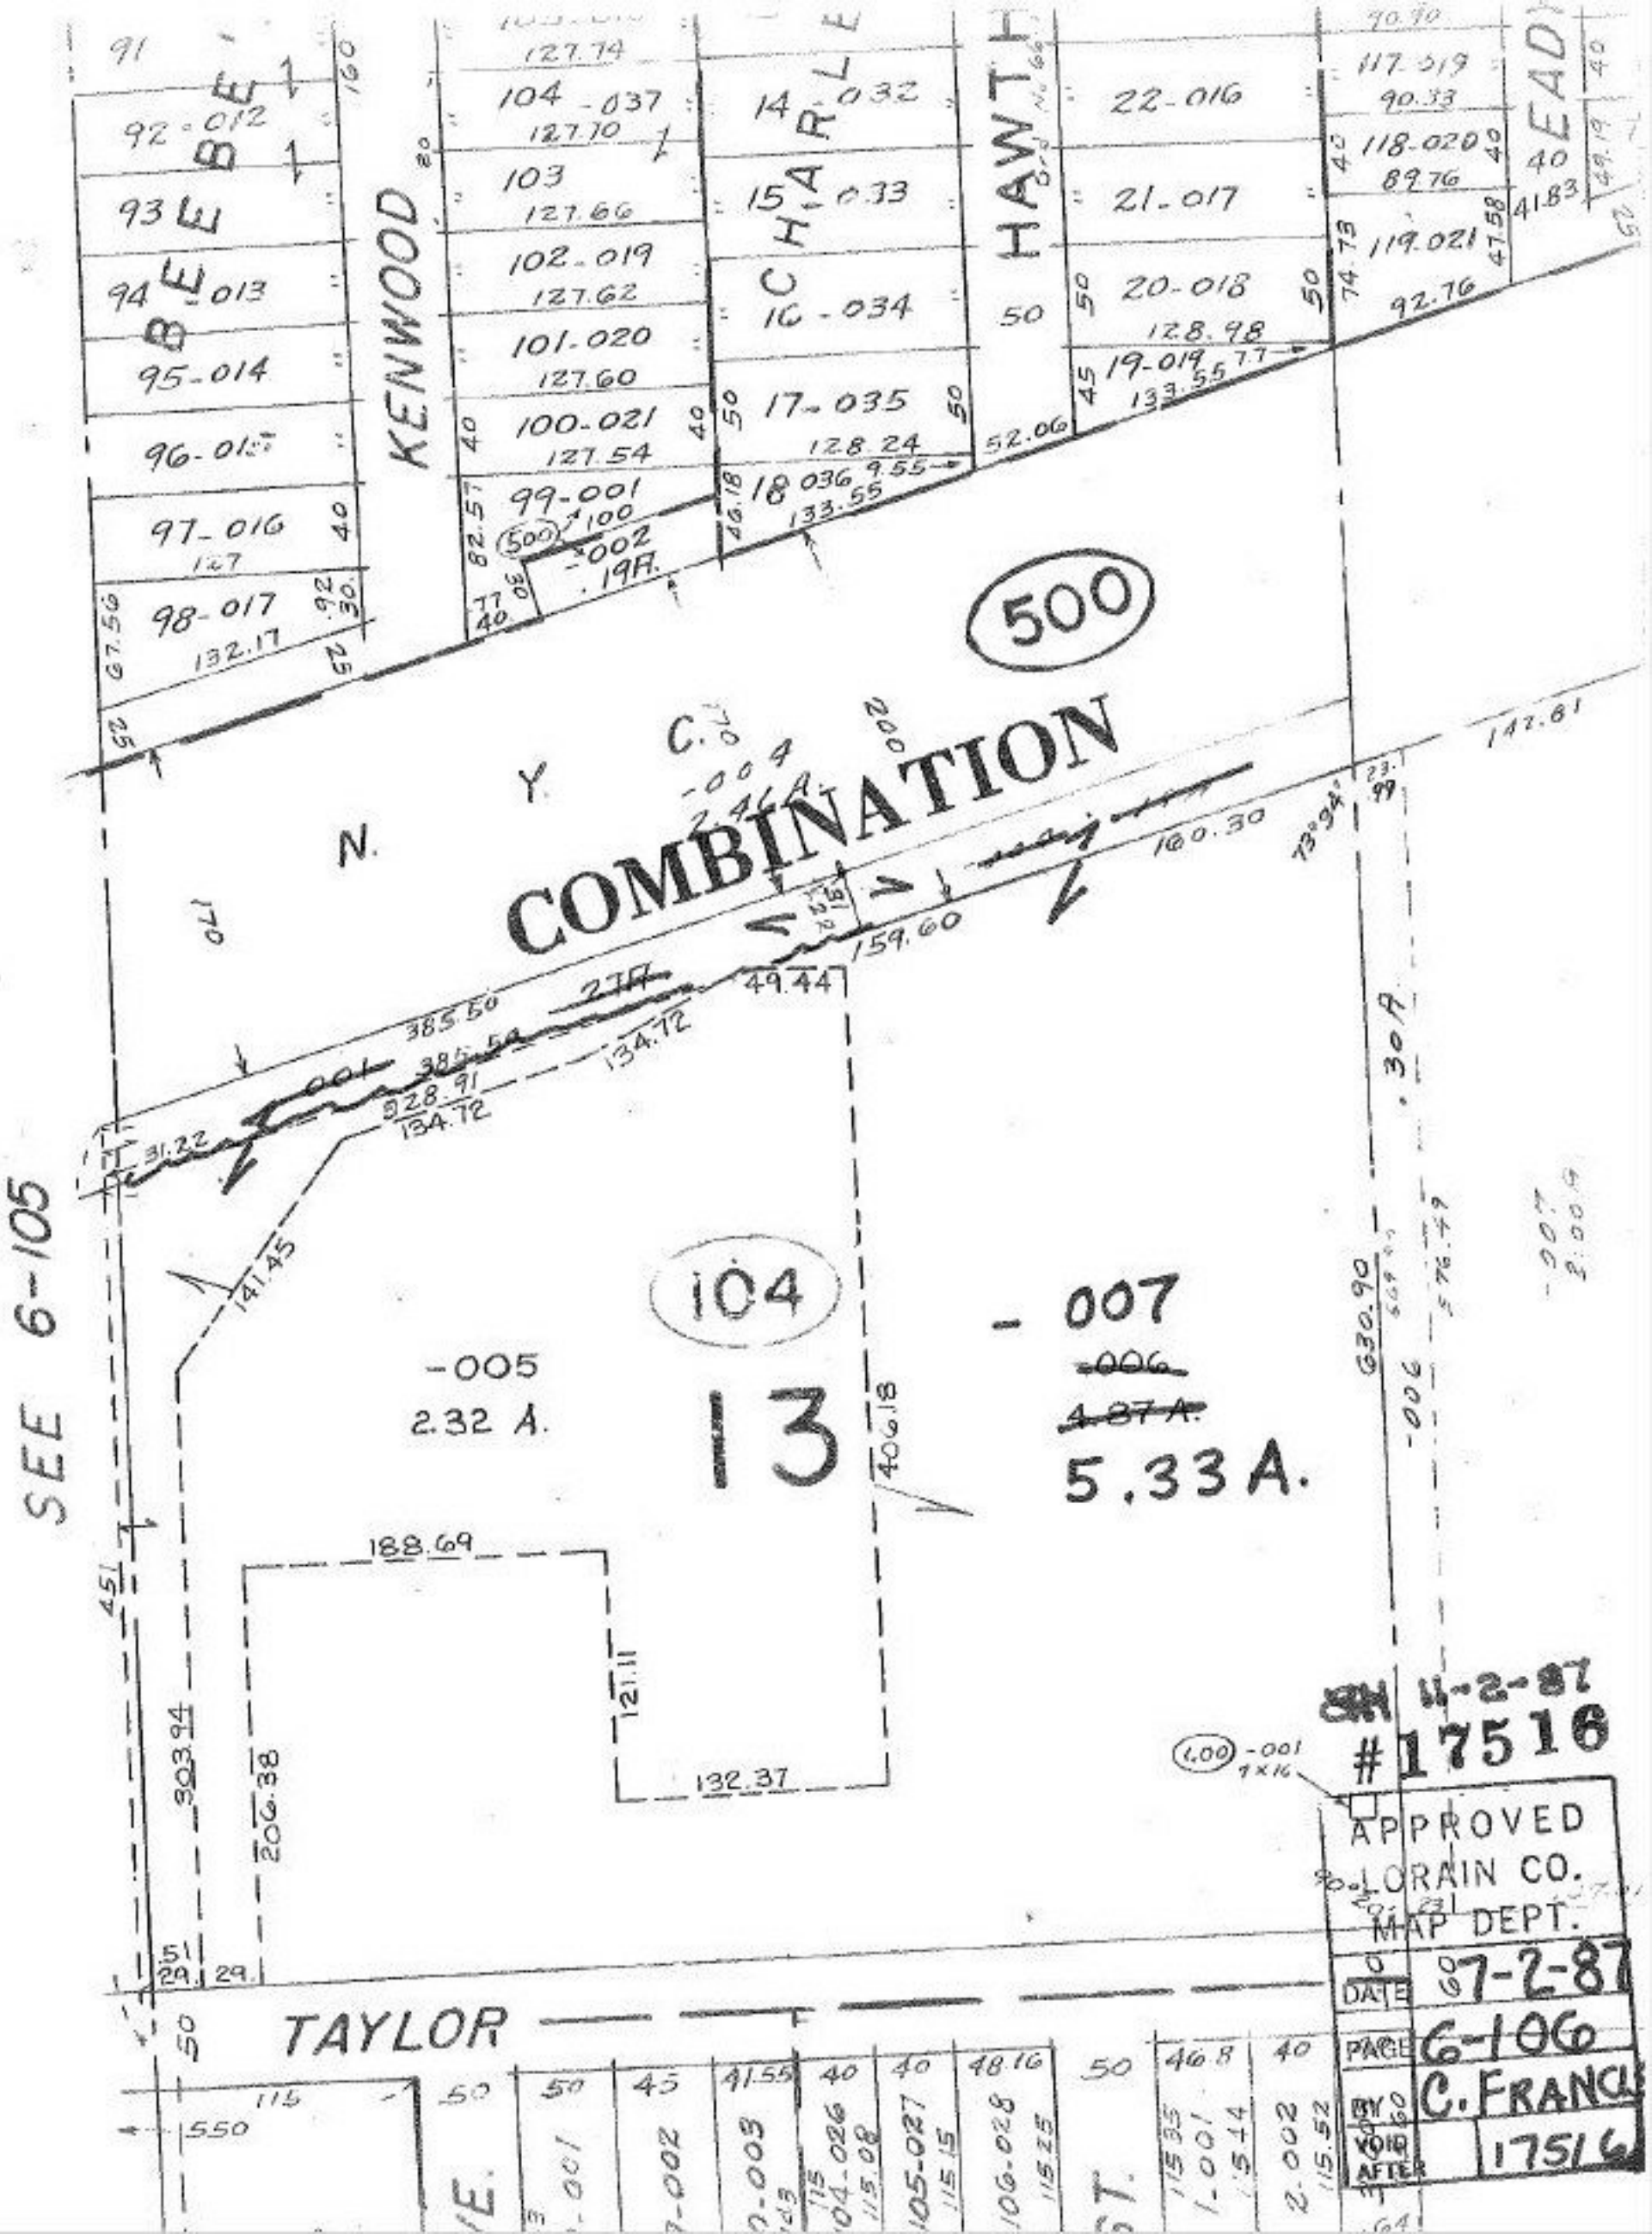

BEEBE
KENWOOD
CHARLE
HAWTH
EADY
N. Y. C.
COMBINATION
500
104
13
-005
2.32 A.
-007
~~-006~~
~~4.87 A.~~
5.33 A.
SEE 6-105
TAYLOR
SH 11-2-87
#17516
APPROVED
LORAIN CO.
MAP DEPT.
DATE 7-2-87
PAGE 6-106
BY C. FRANCIS
VOID AFTER 17516