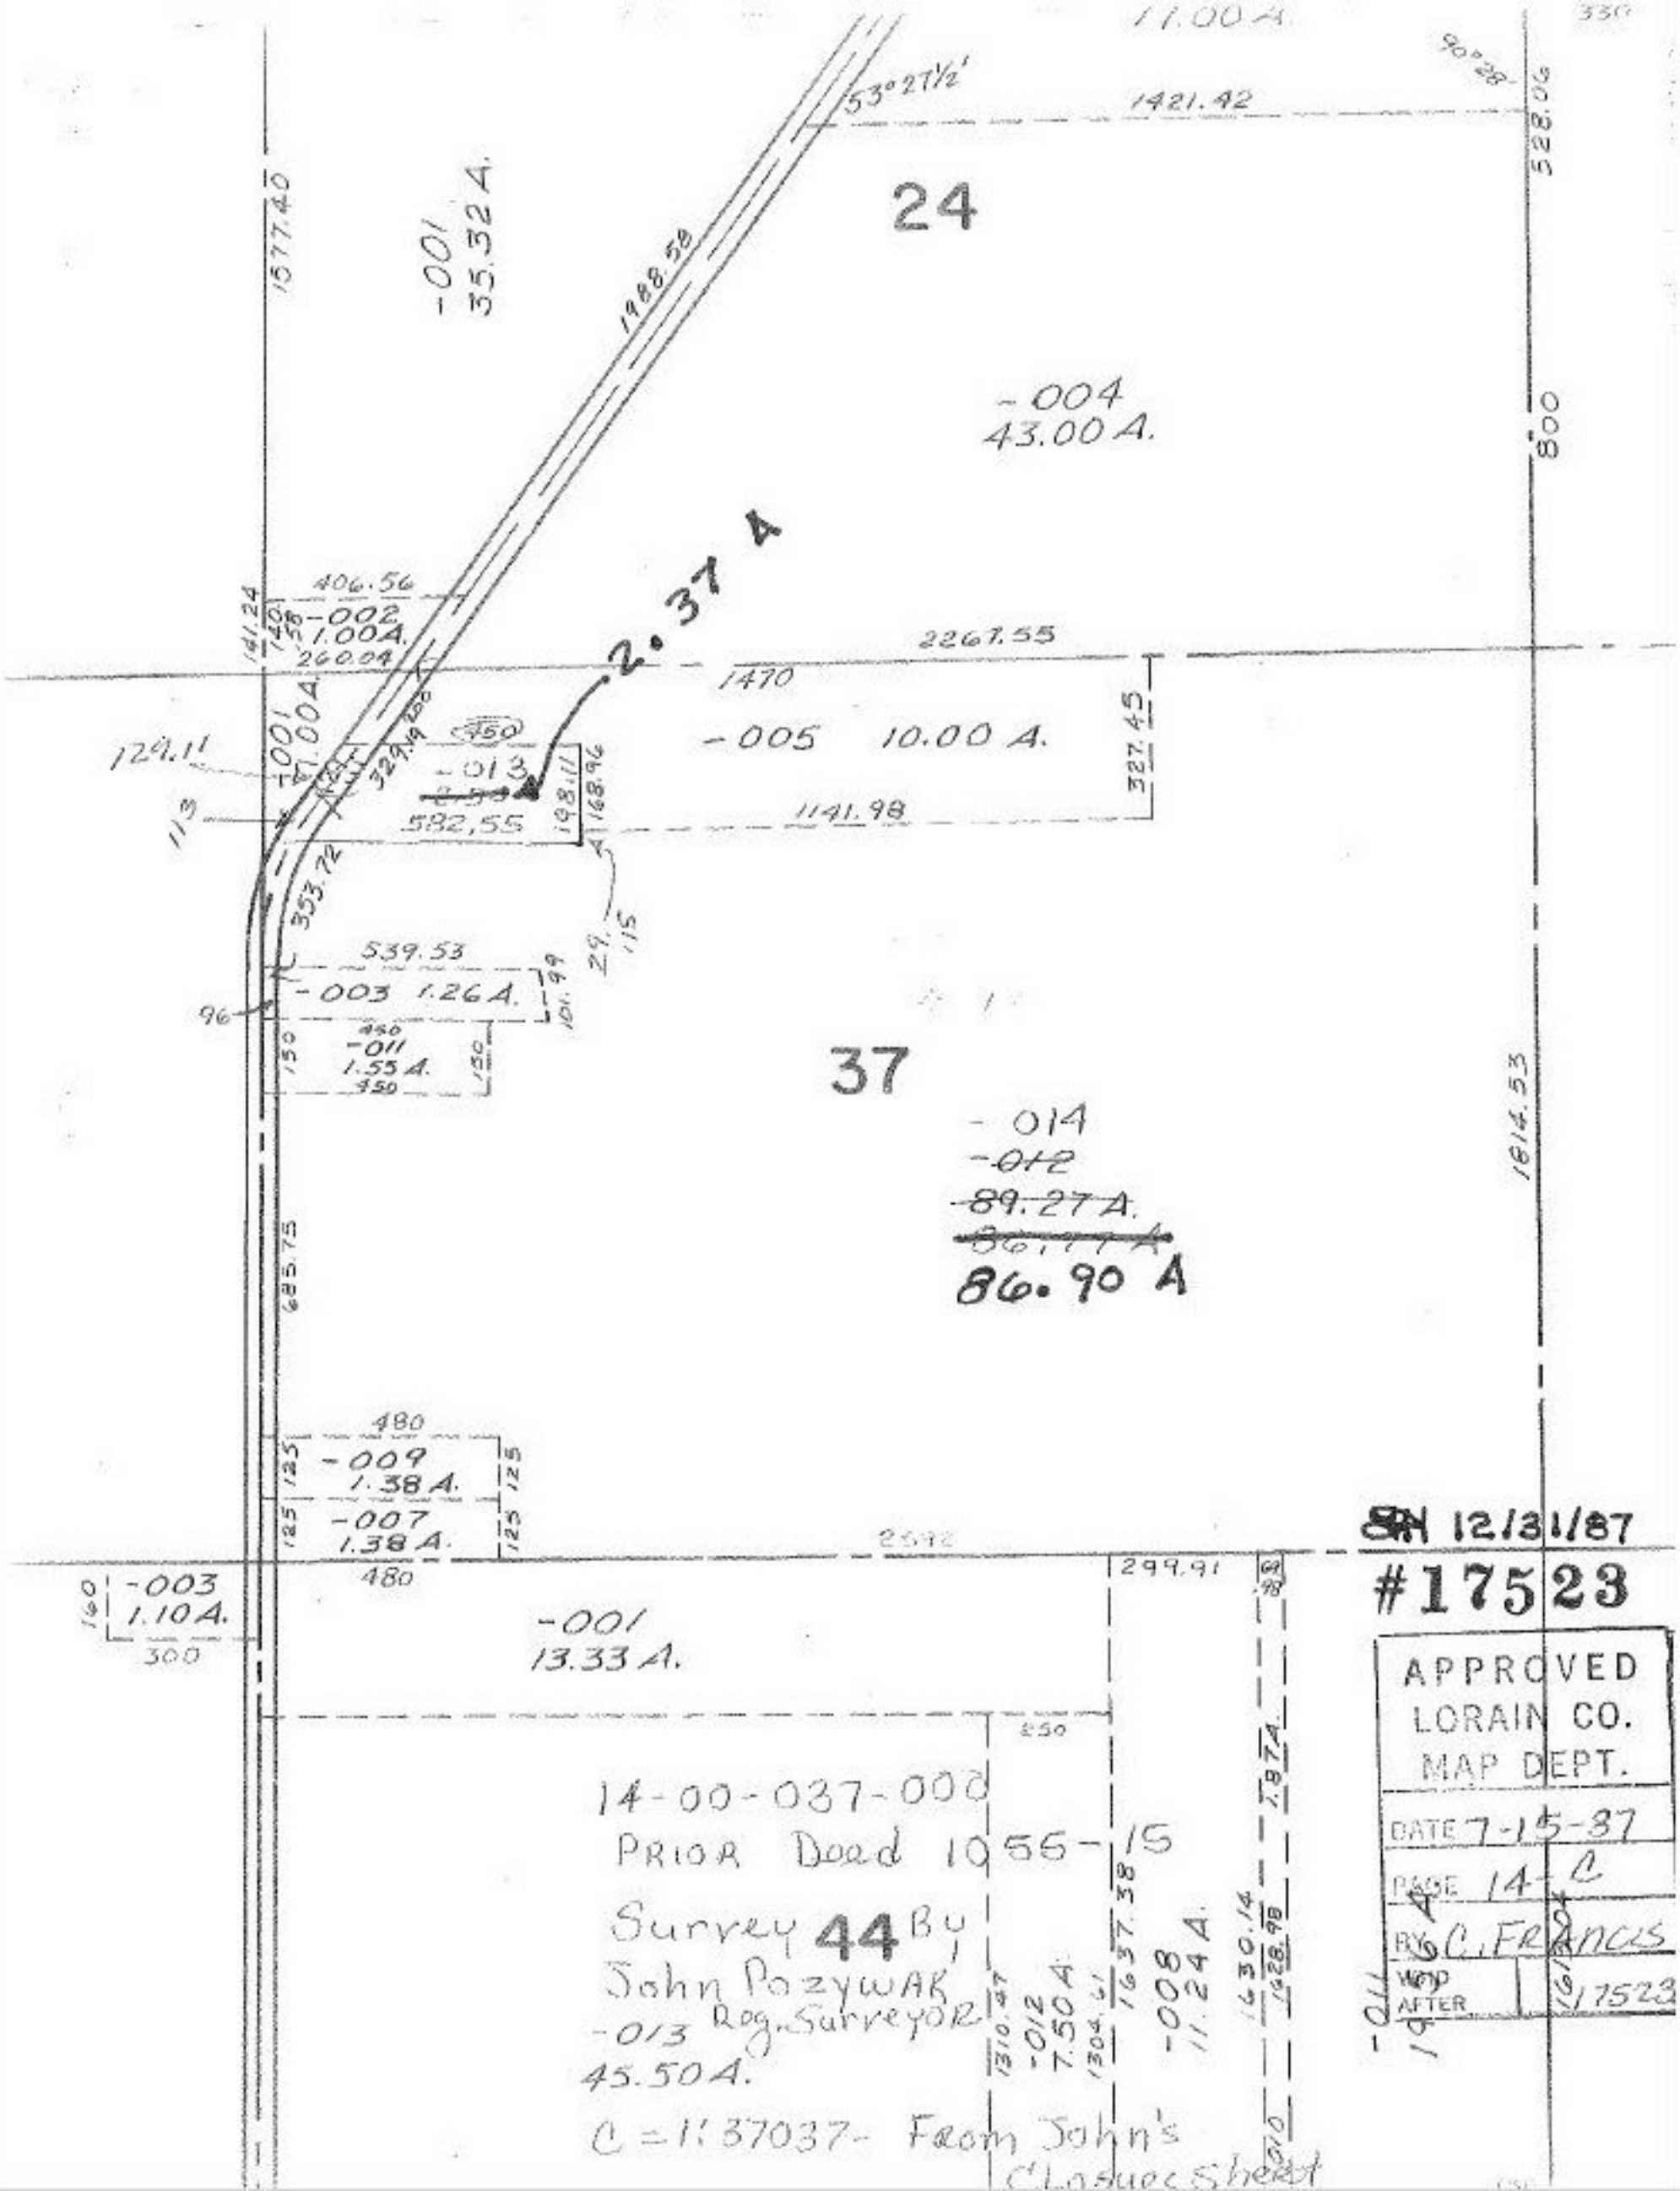

24
37
-001
35.32 A.
-004
43.00 A.
-005 10.00 A.
-002
1.00 A.
-003 1.26 A.
-011
1.55 A.
-014
-012
-89.27 A.
86.90 A
-009
1.38 A.
-007
1.38 A.
-003
1.10 A.
-001
13.33 A.
2.37 A
-013
582.55
1141.98
1421.42
1988.58
2267.55
1470
1577.40
528.06
800
1814.53
685.75
2592
299.91
14-00-037-000
PRIOR Deed 1055-15
Survey 44 By
John Pozywak
Reg. Surveyor
-013
45.50 A.
C = 1:37037 - From John's
Closure Sheet
SH 12/31/87
#17523
APPROVED
LORAIN CO.
MAP DEPT.
DATE 7-15-87
PAGE 14-C
BY C. FRANCIS
WHO AFTER
17523