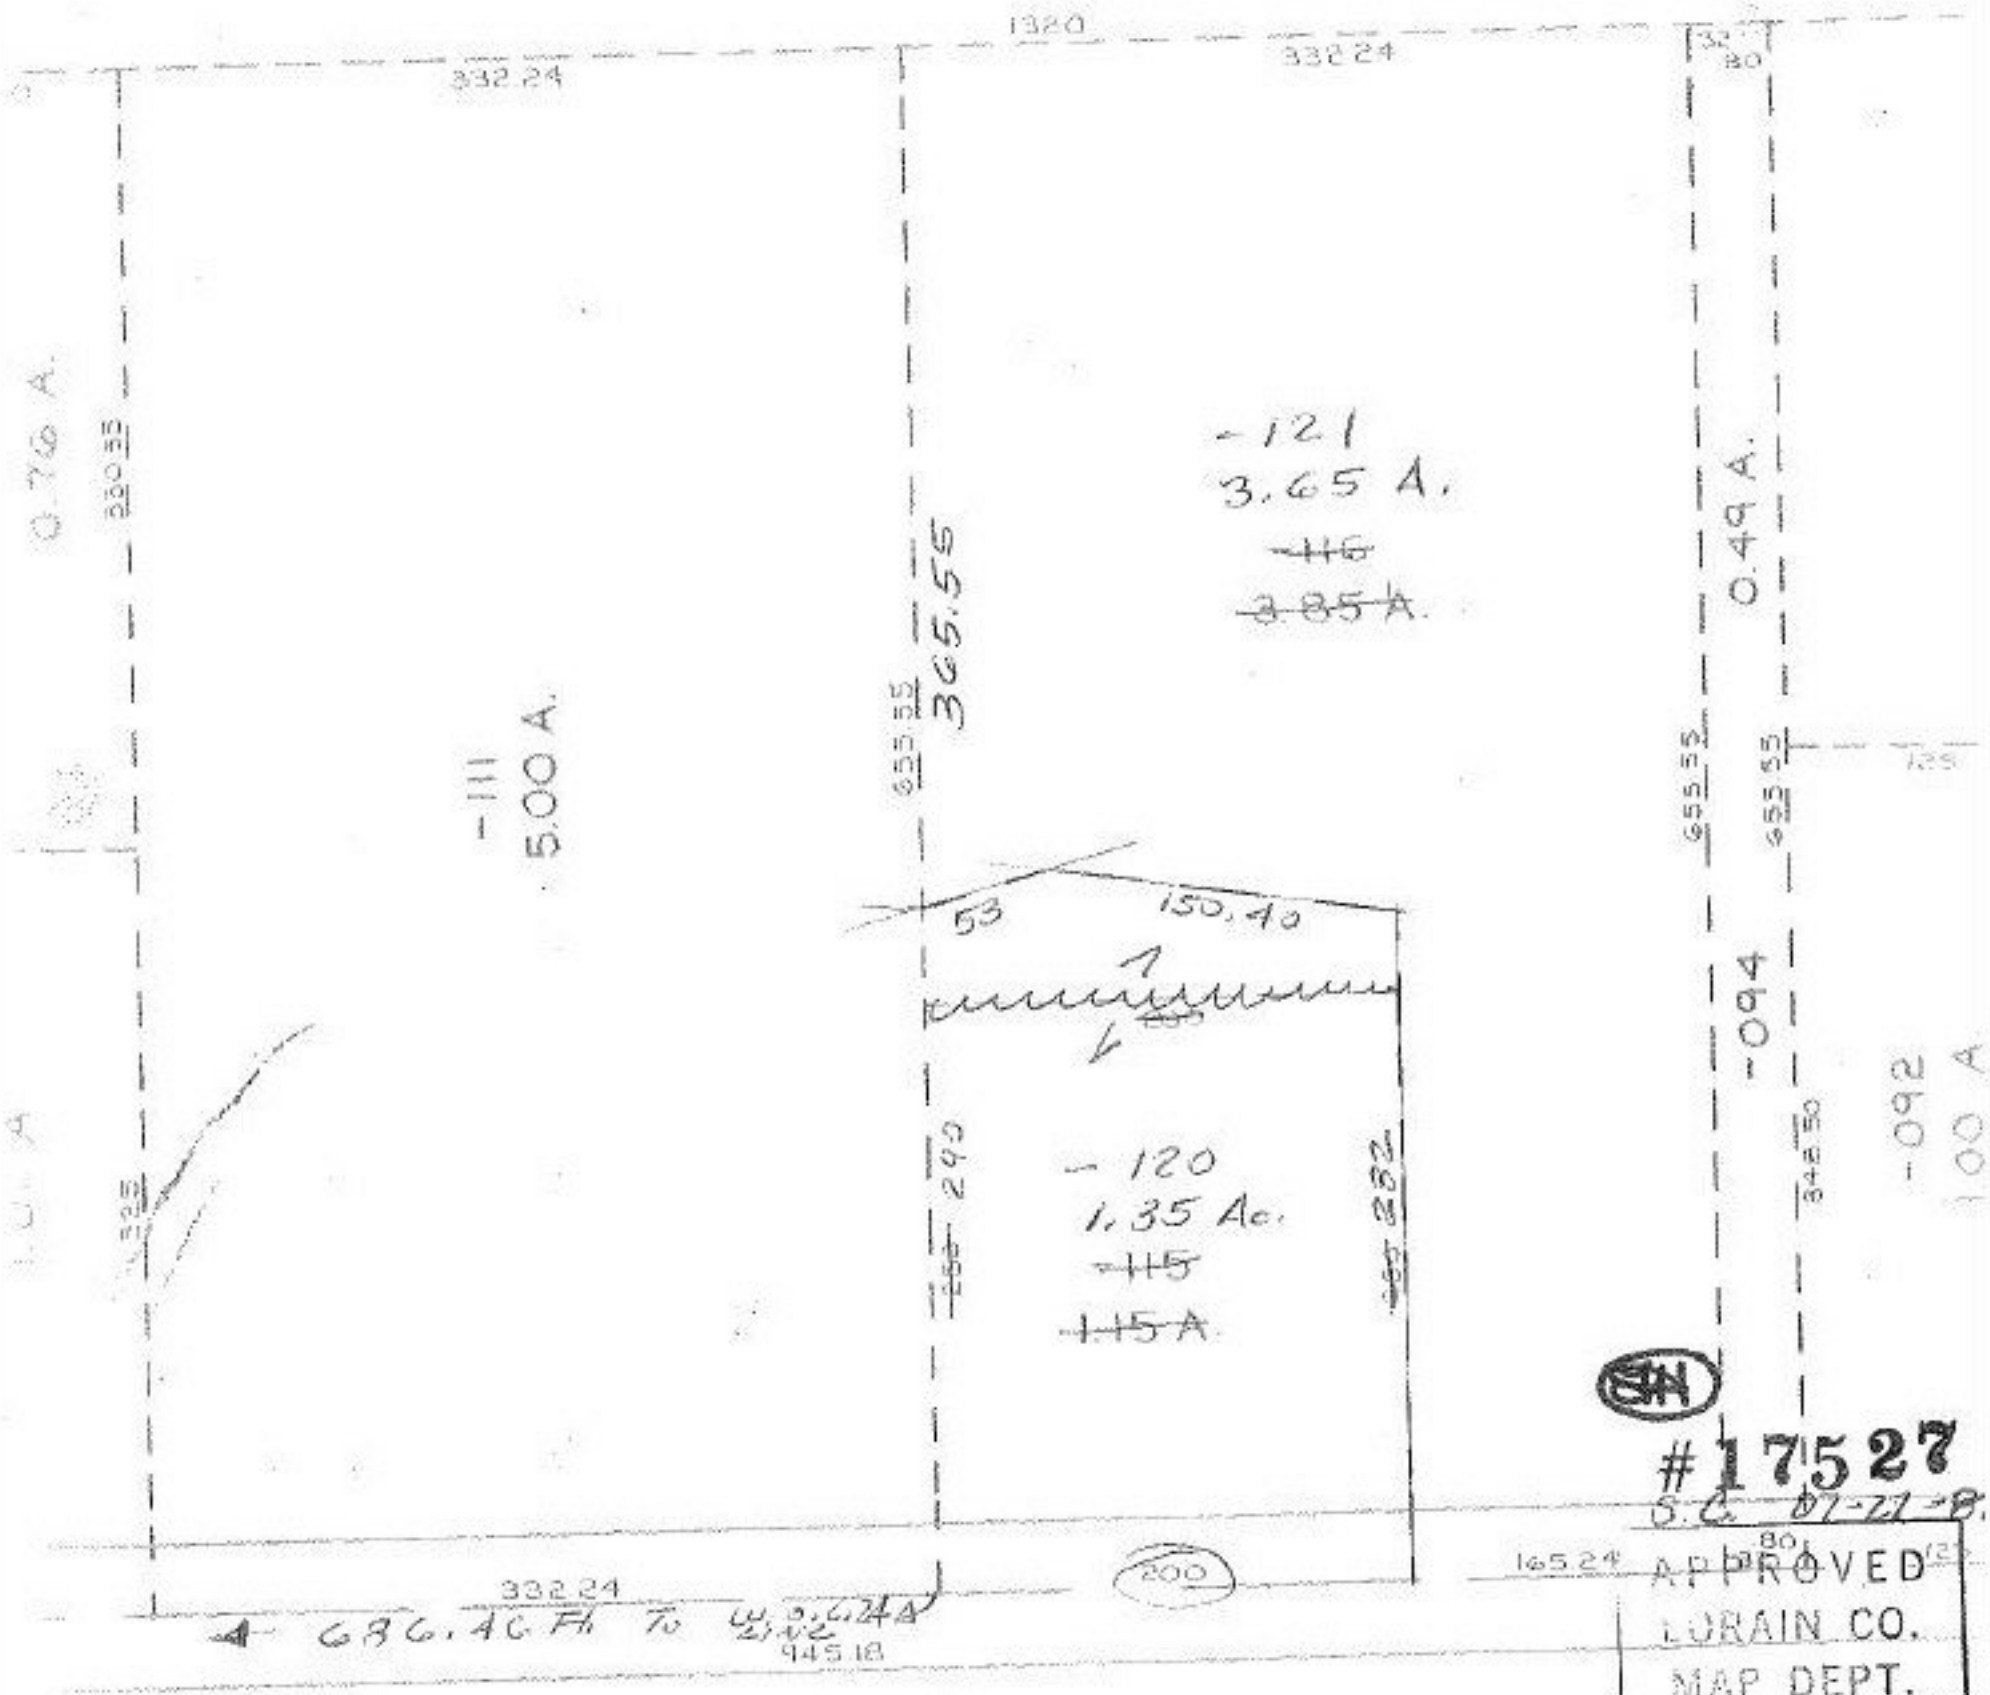

#17527
S.C. 07-27-87

APPROVED
LORAIN CO.
MAP DEPT.
DATE 7-7-87
PAGE 10-00-024A
BY C. FRANCIS
VOID AFTER 17527

10-00-024-000

PRIOR DEED 1408-804
C = 1.83333 1057-665

~~PARCEL MAP~~

SURVEY [redacted] John Pozywak