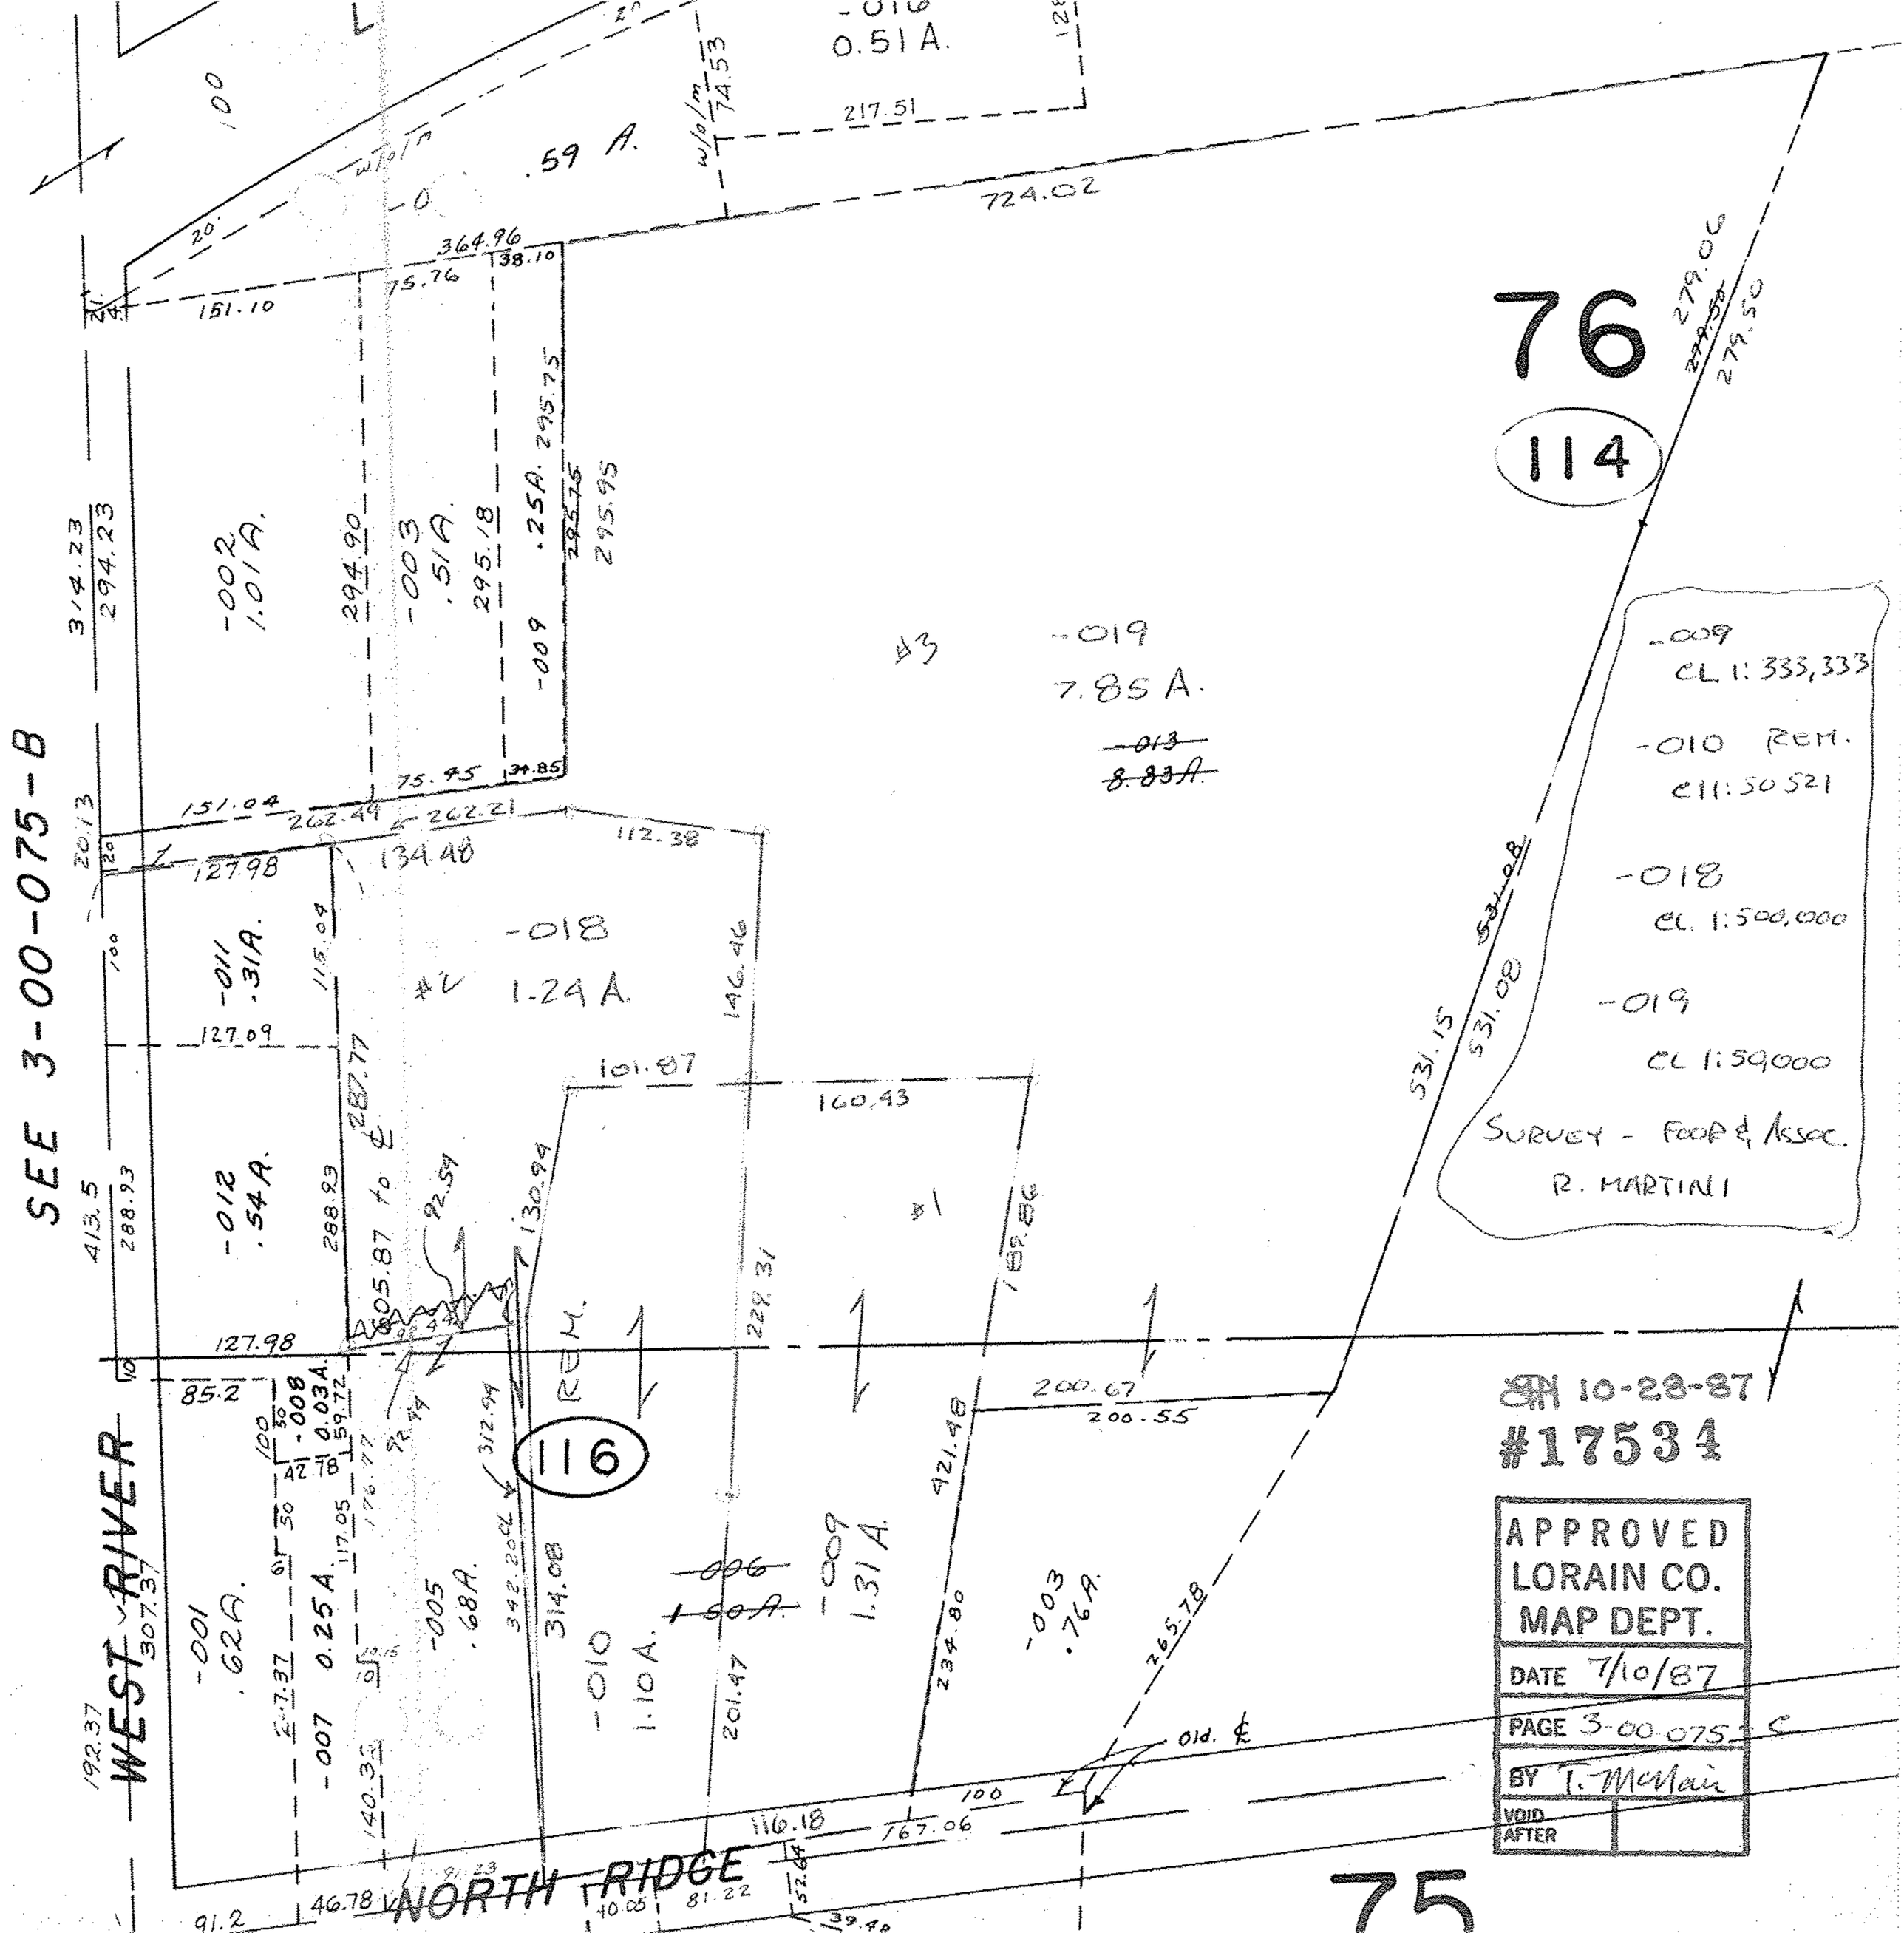

SEE 3-00-075-B
WEST RIVER
NORTH RIDGE
76
114
116
75
-016
0.51 A.
.59 A.
-019
7.85 A.
-013
8.83 A.
-018
1.24 A.
-002
1.01 A.
-003
.51 A.
-009
.25 A.
-011
.31 A.
-012
.54 A.
-001
.62 A.
-007
0.25 A.
-005
.68 A.
-010
1.10 A.
-006
1.50 A.
-009
1.31 A.
-003
.76 A.
-009
CL 1:333,333
-010 REM.
CL 1:50521
-018
CL 1:500,000
-019
CL 1:59000
SURVEY - FOOR & ASSOC.
R. MARTINI
10-28-87
#17534
APPROVED
LORAIN CO.
MAP DEPT.
DATE 7/10/87
PAGE 3-00-075-C
BY T. McNair
VOID
AFTER