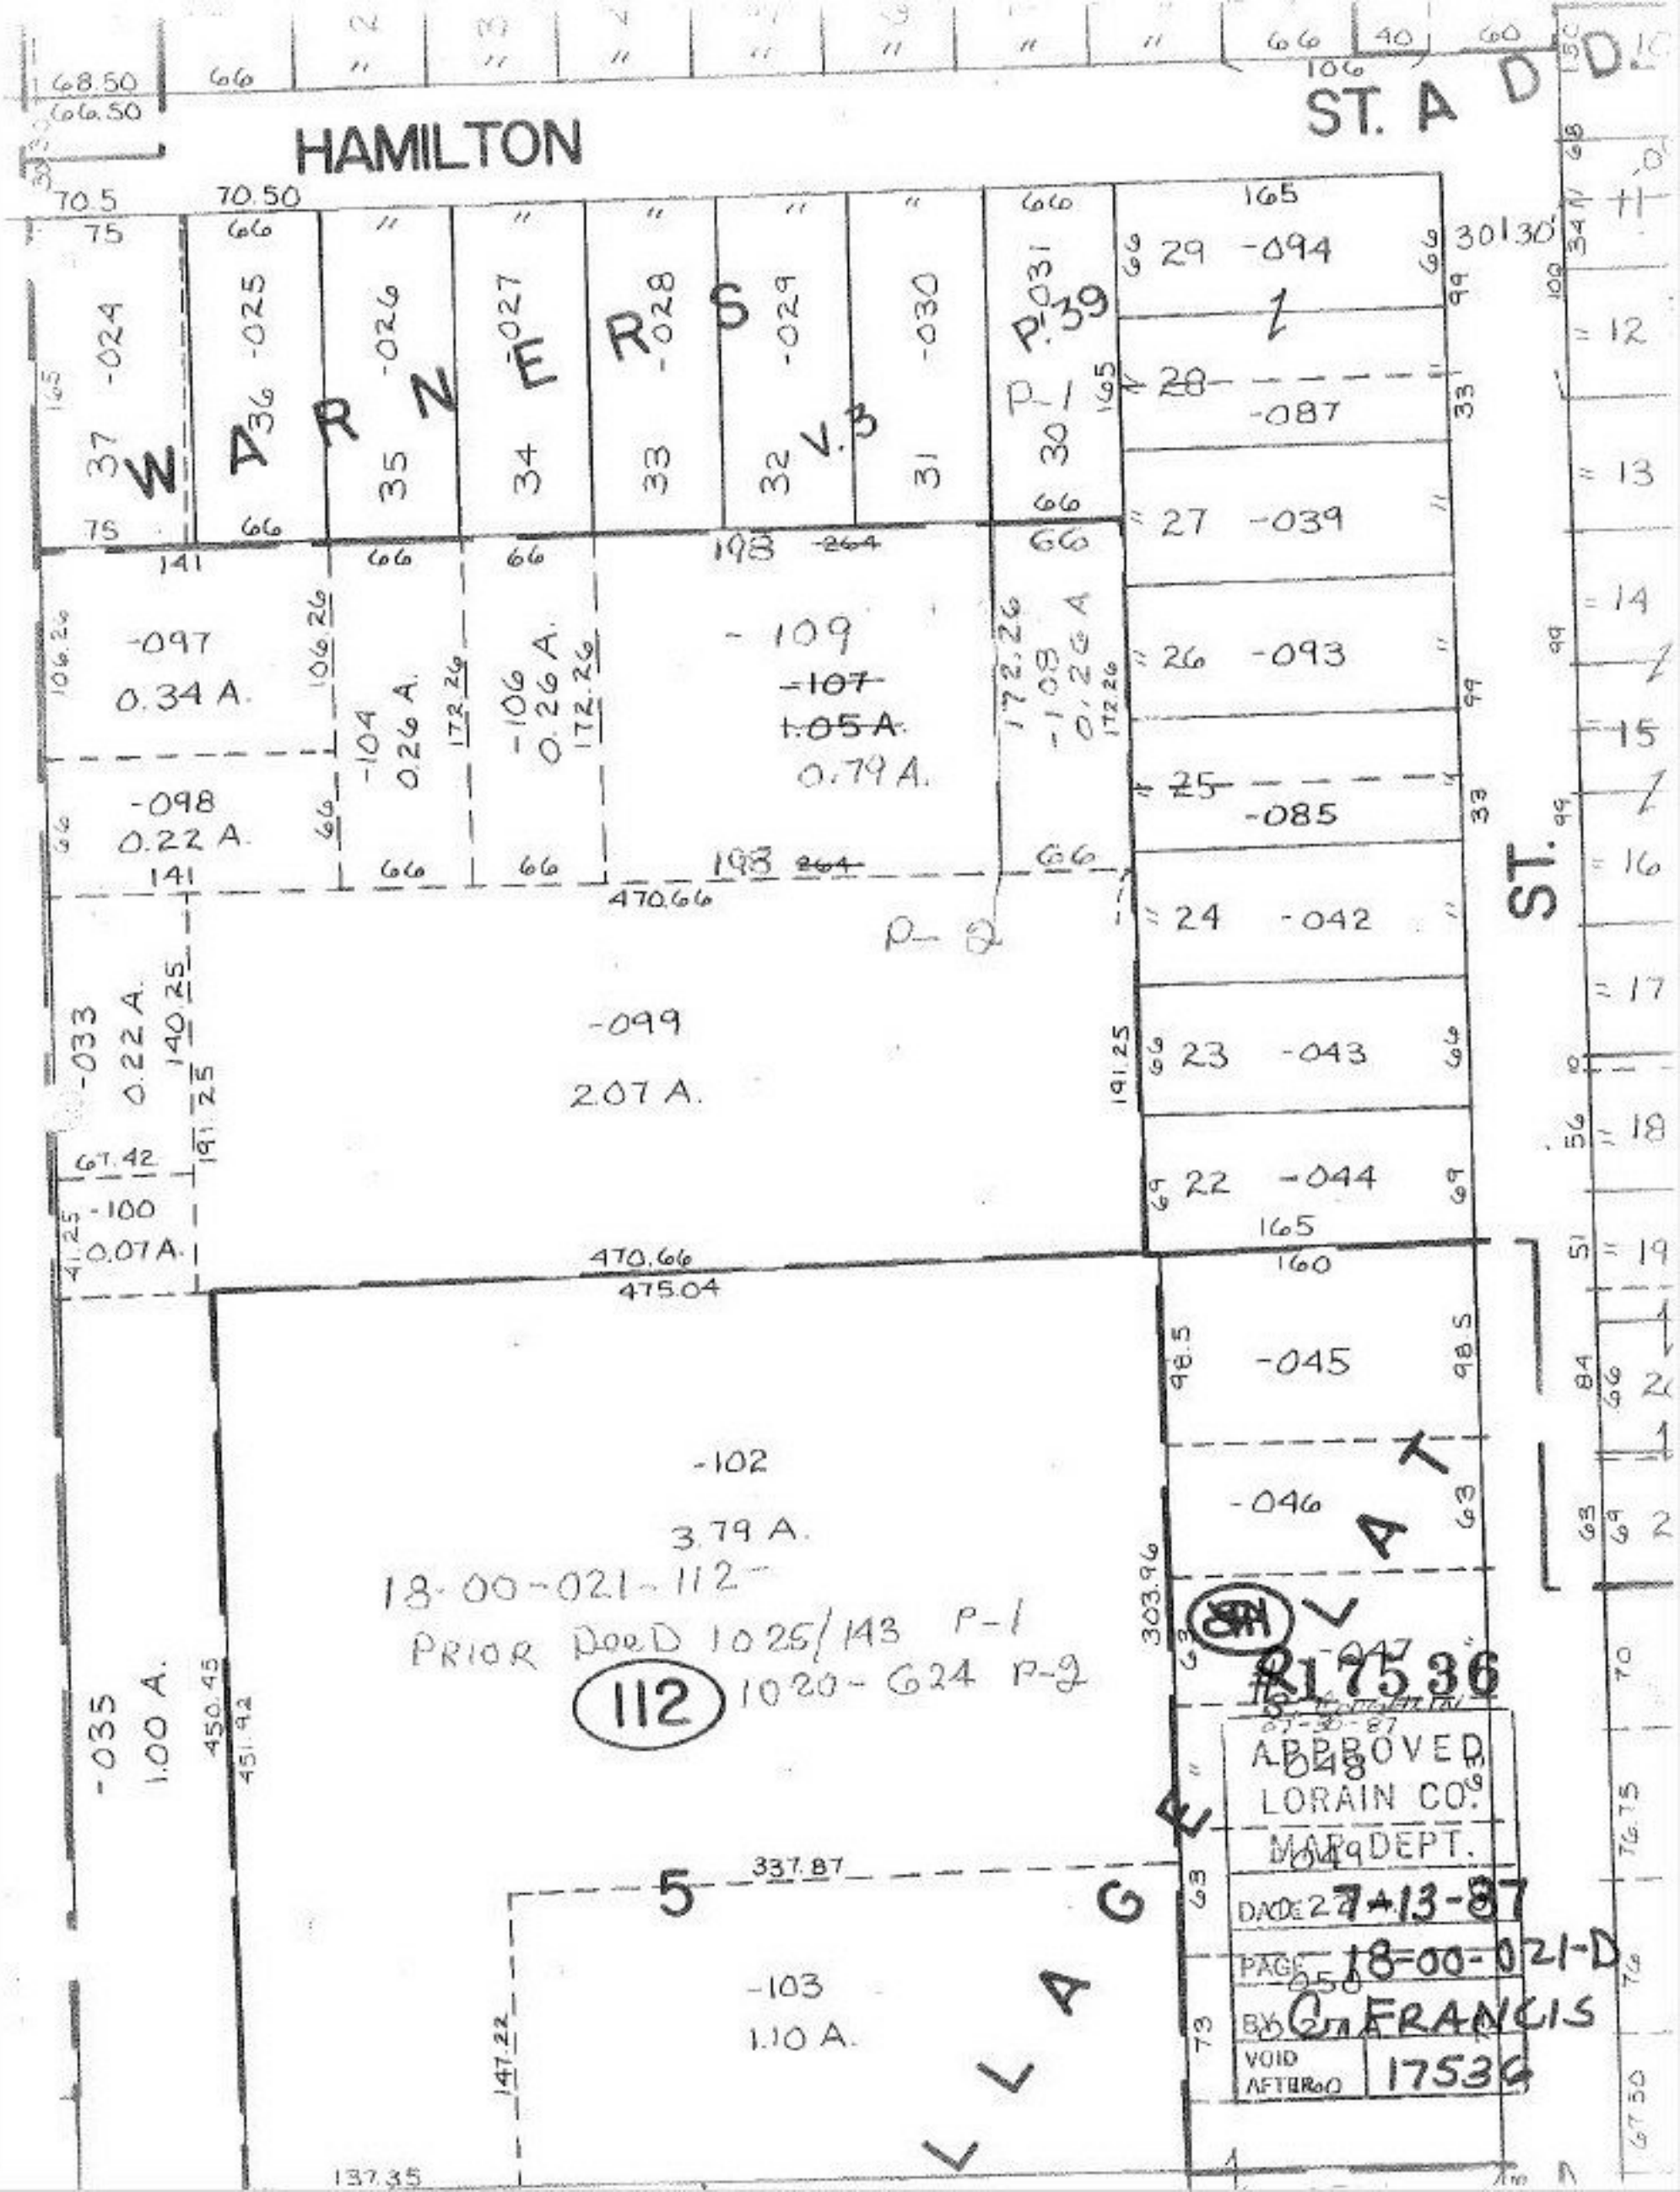
HAMILTON
ST. A D D.
WARNERS
V.3
P.39
P-1
P-2
-097
0.34 A.
-098
0.22 A.
-104
0.26 A.
-106
0.26 A.
-109
~~-107~~
~~1.05 A.~~
0.79 A.
-108
0.26 A.
-099
2.07 A.
-033
0.22 A.
-100
0.07 A.
-102
3.79 A.
-035
1.00 A.
-103
1.10 A.
-094
-087
-039
-093
-085
-042
-043
-044
-045
-046
-047
-048
-049
-050
-051
18-00-021-112
PRIOR DEED 1025/143 P-1
1020-624 P-2
112
5
ST.
LLAGE
PLAT
$17536
APPROVED
LORAIN CO.
MAP DEPT.
DATE 7-13-87
PAGE 18-00-021-D
BY G. FRANCIS
VOID AFTER 60
17536