1754

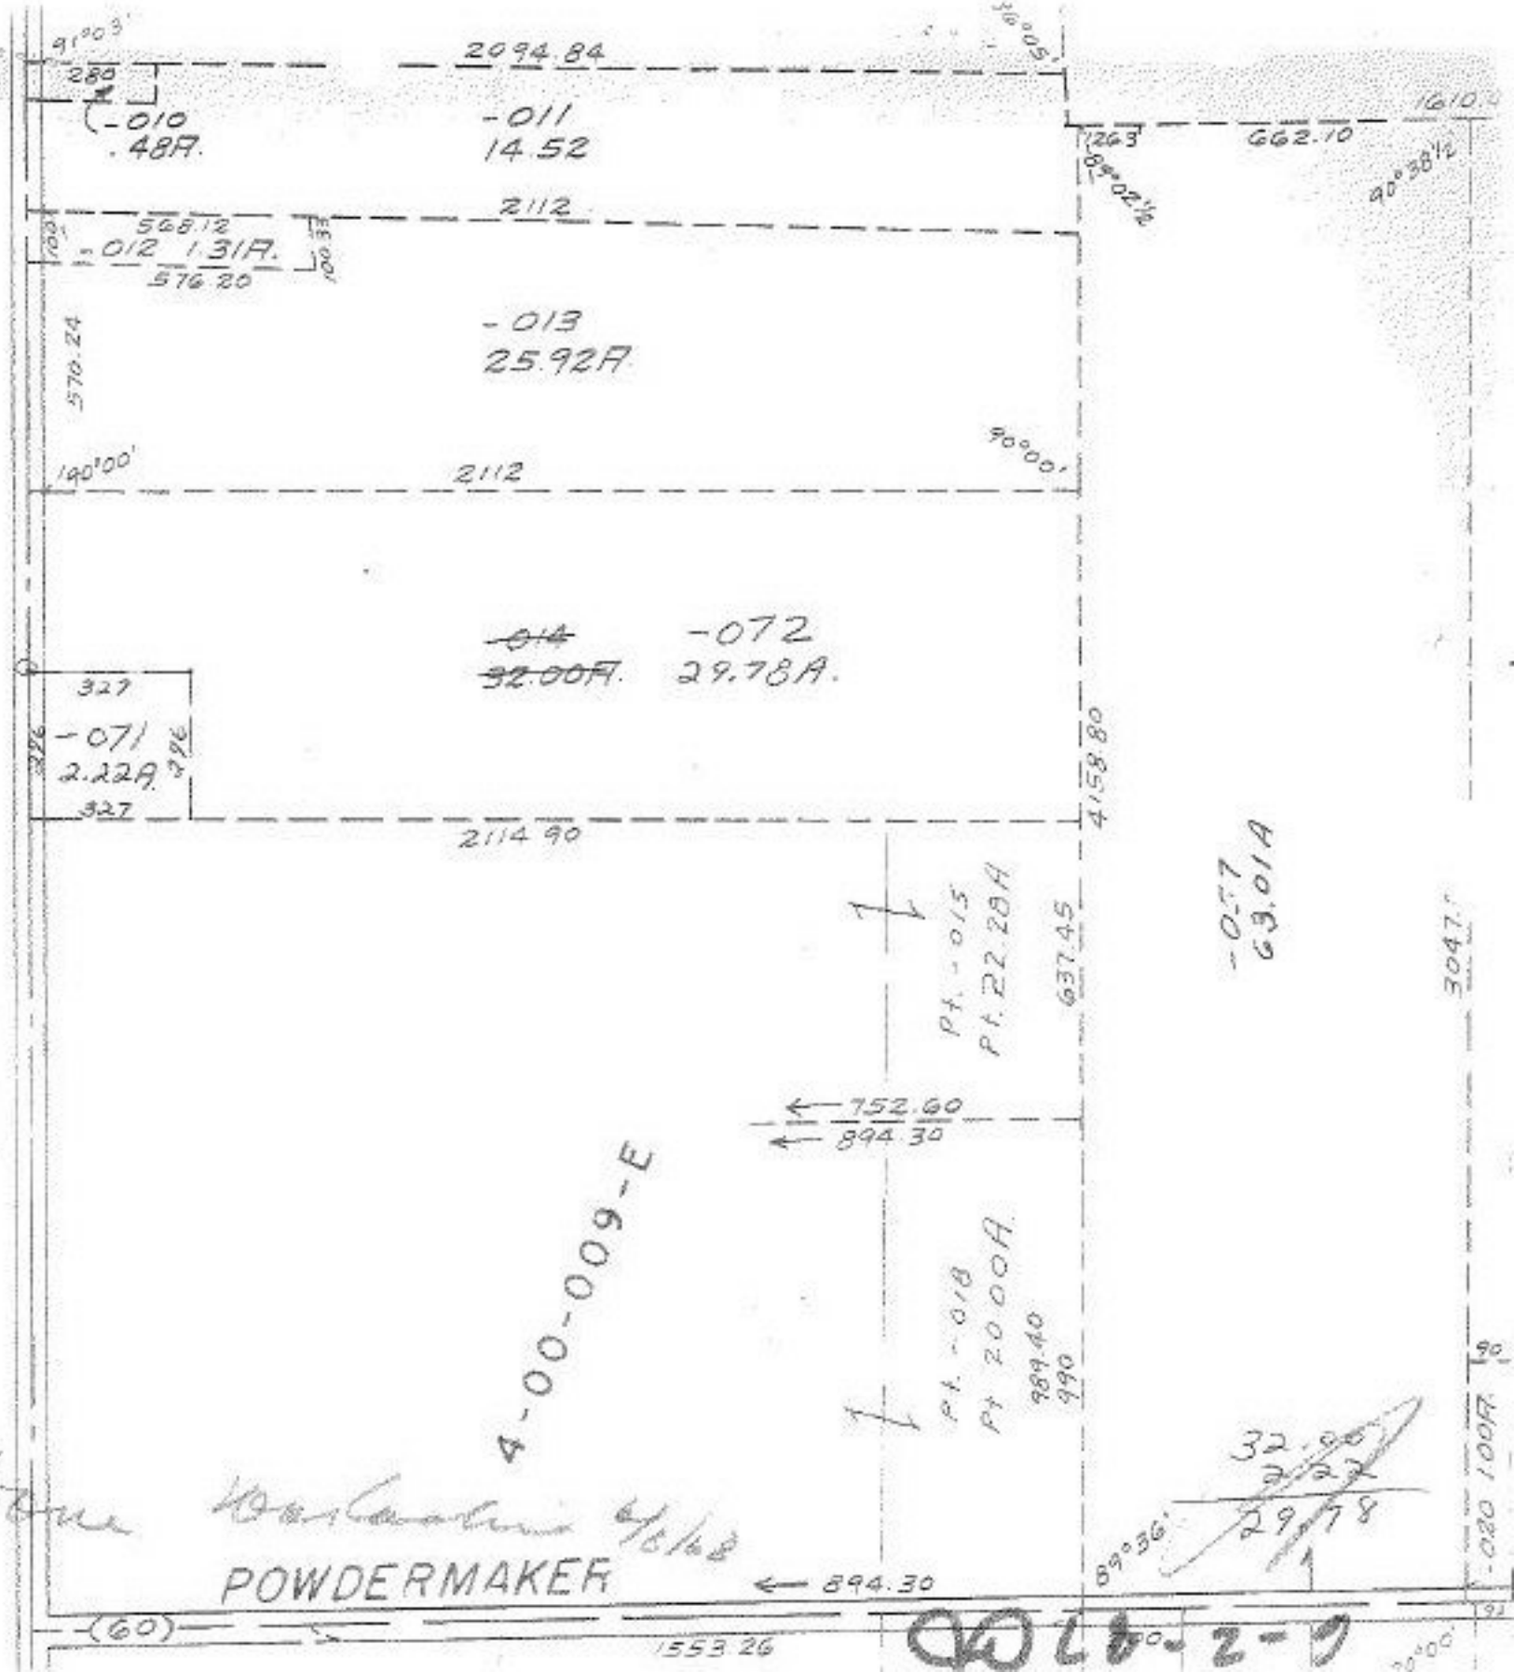

1754

7-15-86 8ma

APPROVED
LORAIN CO.
MAP DEPT.
DATE 5-11-68
4-F
BY F. Colbert