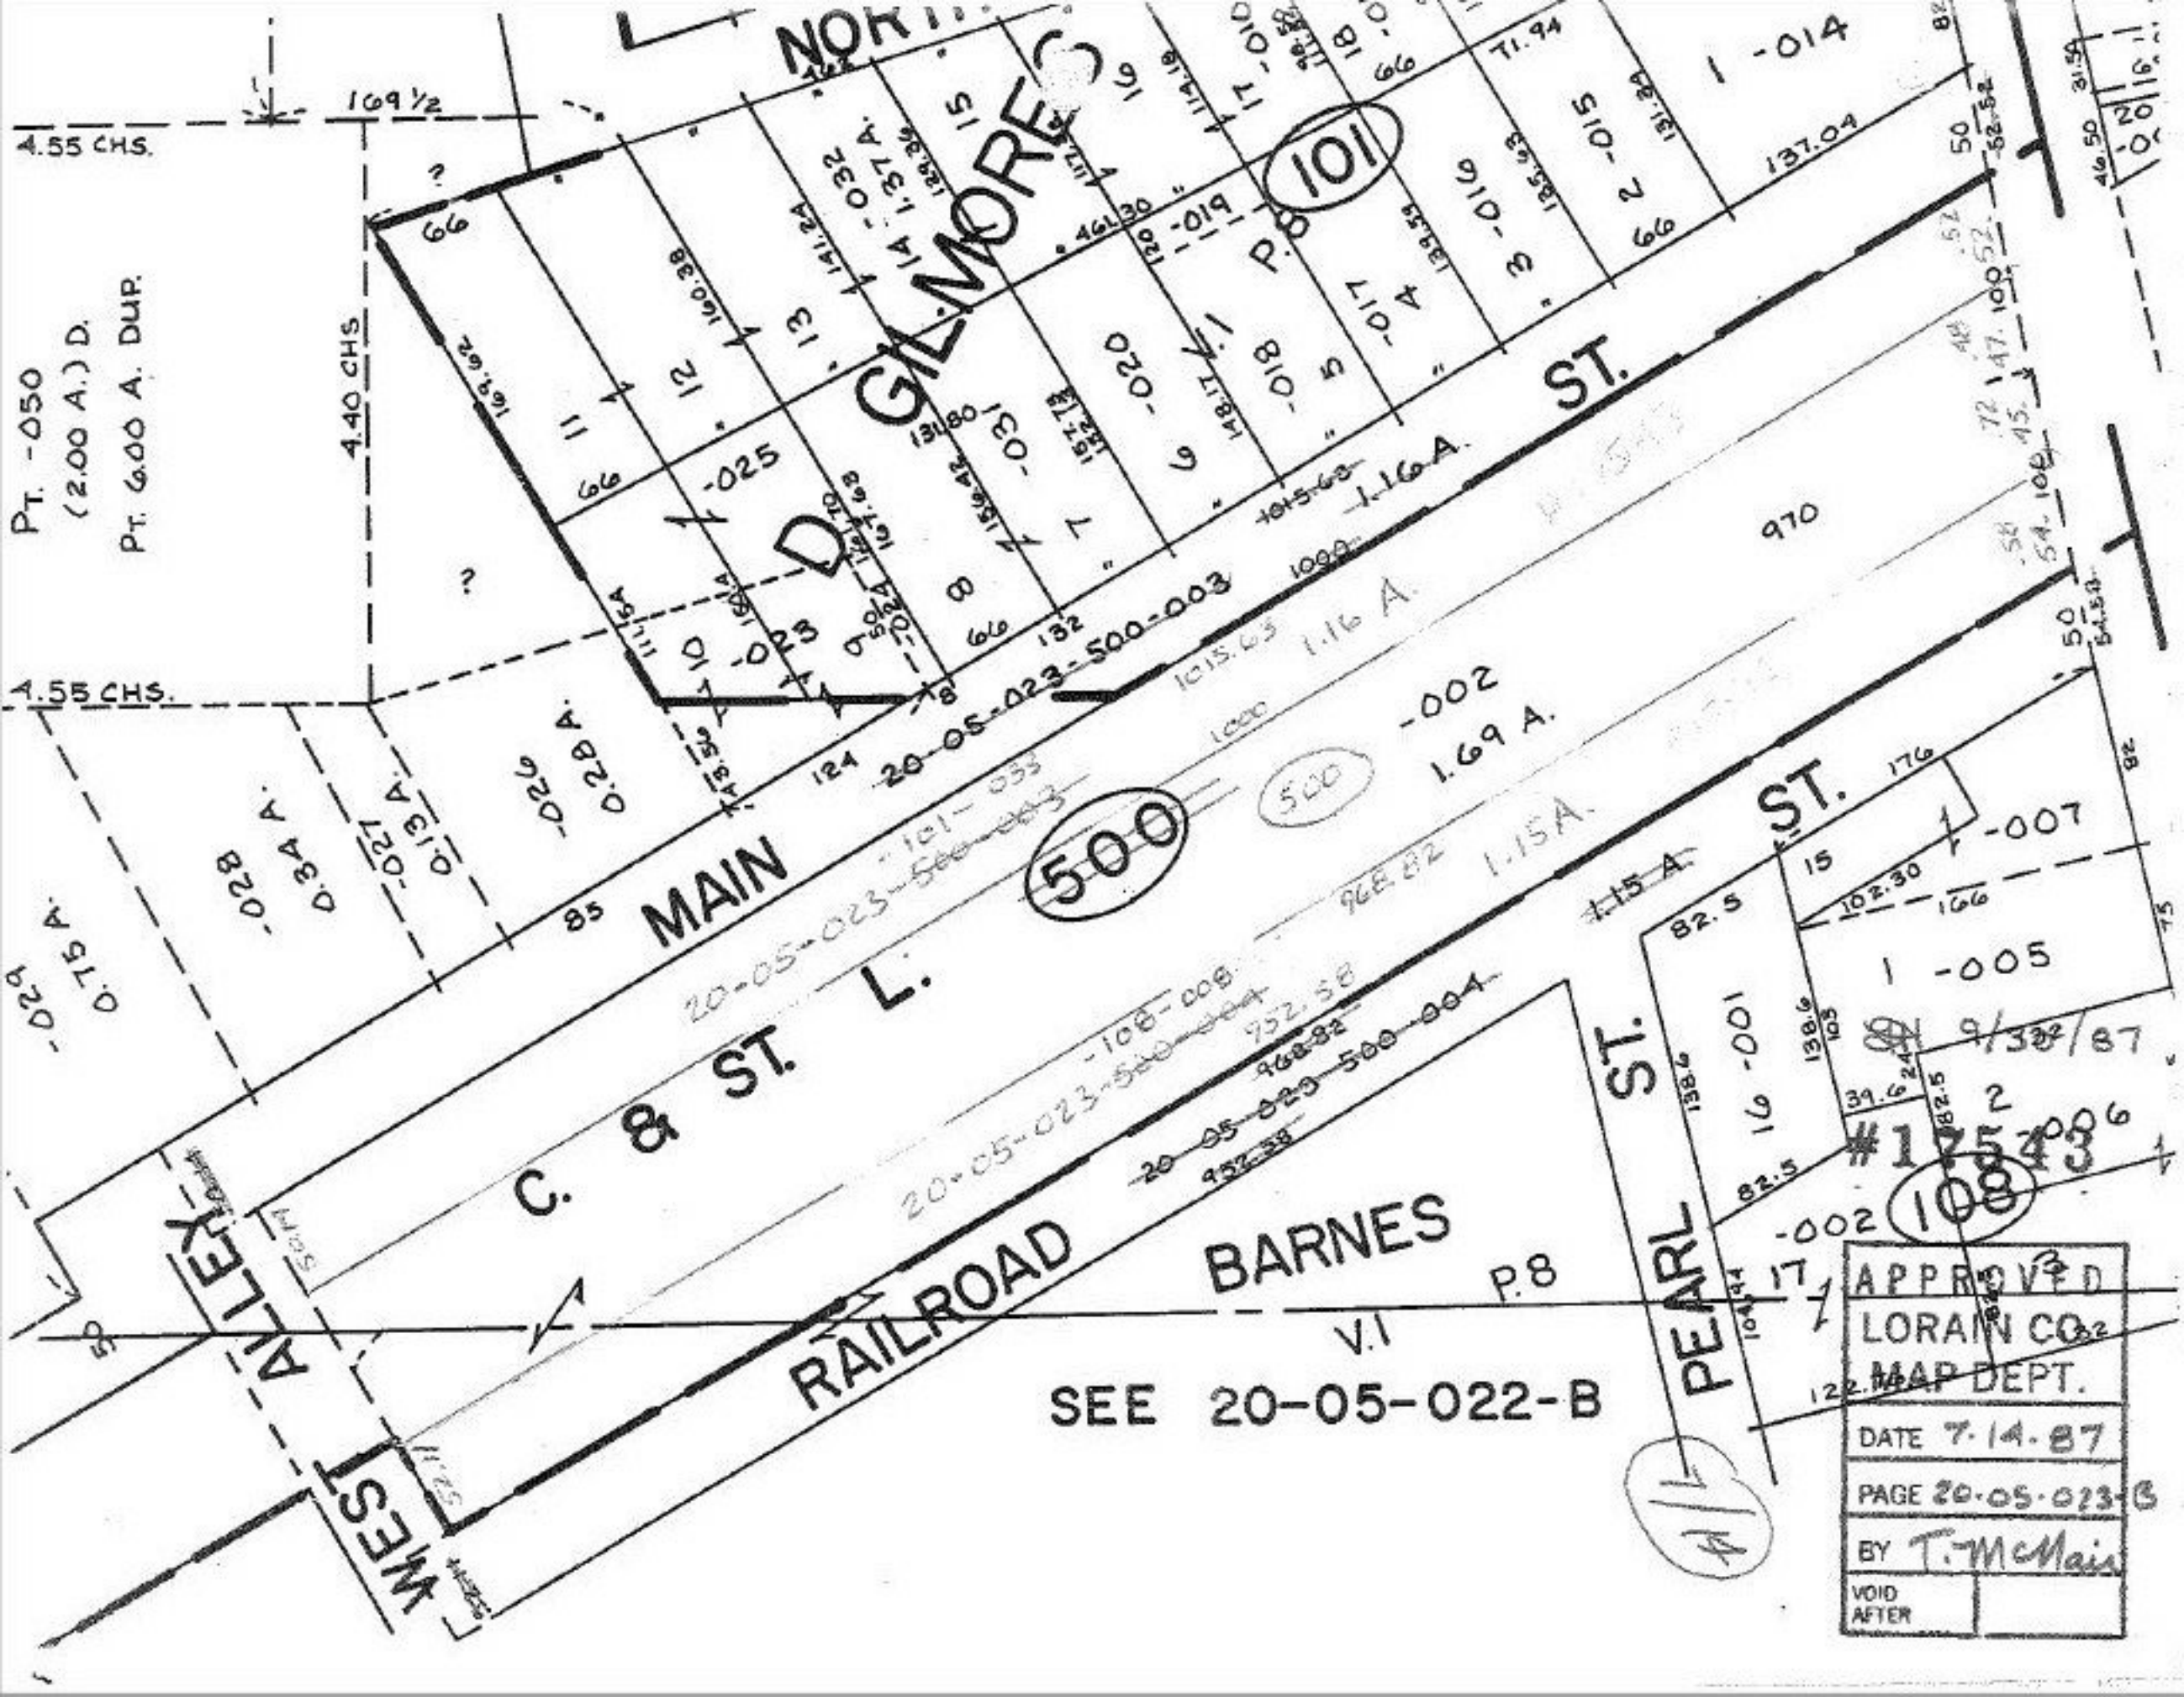

NORTH
GILMORE
101
P.8
V.1
4.55 CHS.
4.40 CHS
169 1/2
PT. -050
(2.00 A.) D.
PT. 6.00 A. DUP.
D
ST.
MAIN
C. & ST. L.
500
20-05-023-500-003
20-05-023-500-004
20-05-023-500-003
20-05-023-500-004
1.16 A.
1.69 A.
1.15 A.
970
-002
-007
1 -005
-006
-002
-001
16 -001
-025
-023
-031
-020
-018
-017
-016
-015
-014
-019
-032
-026
-028
-027
-029
0.28 A.
0.34 A.
0.13 A.
0.75 A.
WEST ALLEY
RAILROAD
BARNES
PEARL ST.
SEE 20-05-022-B
#17543
108
APPROVED
LORAIN CO.
MAP DEPT.
DATE 7-14-87
PAGE 20-05-023-B
BY T. McMain
VOID AFTER