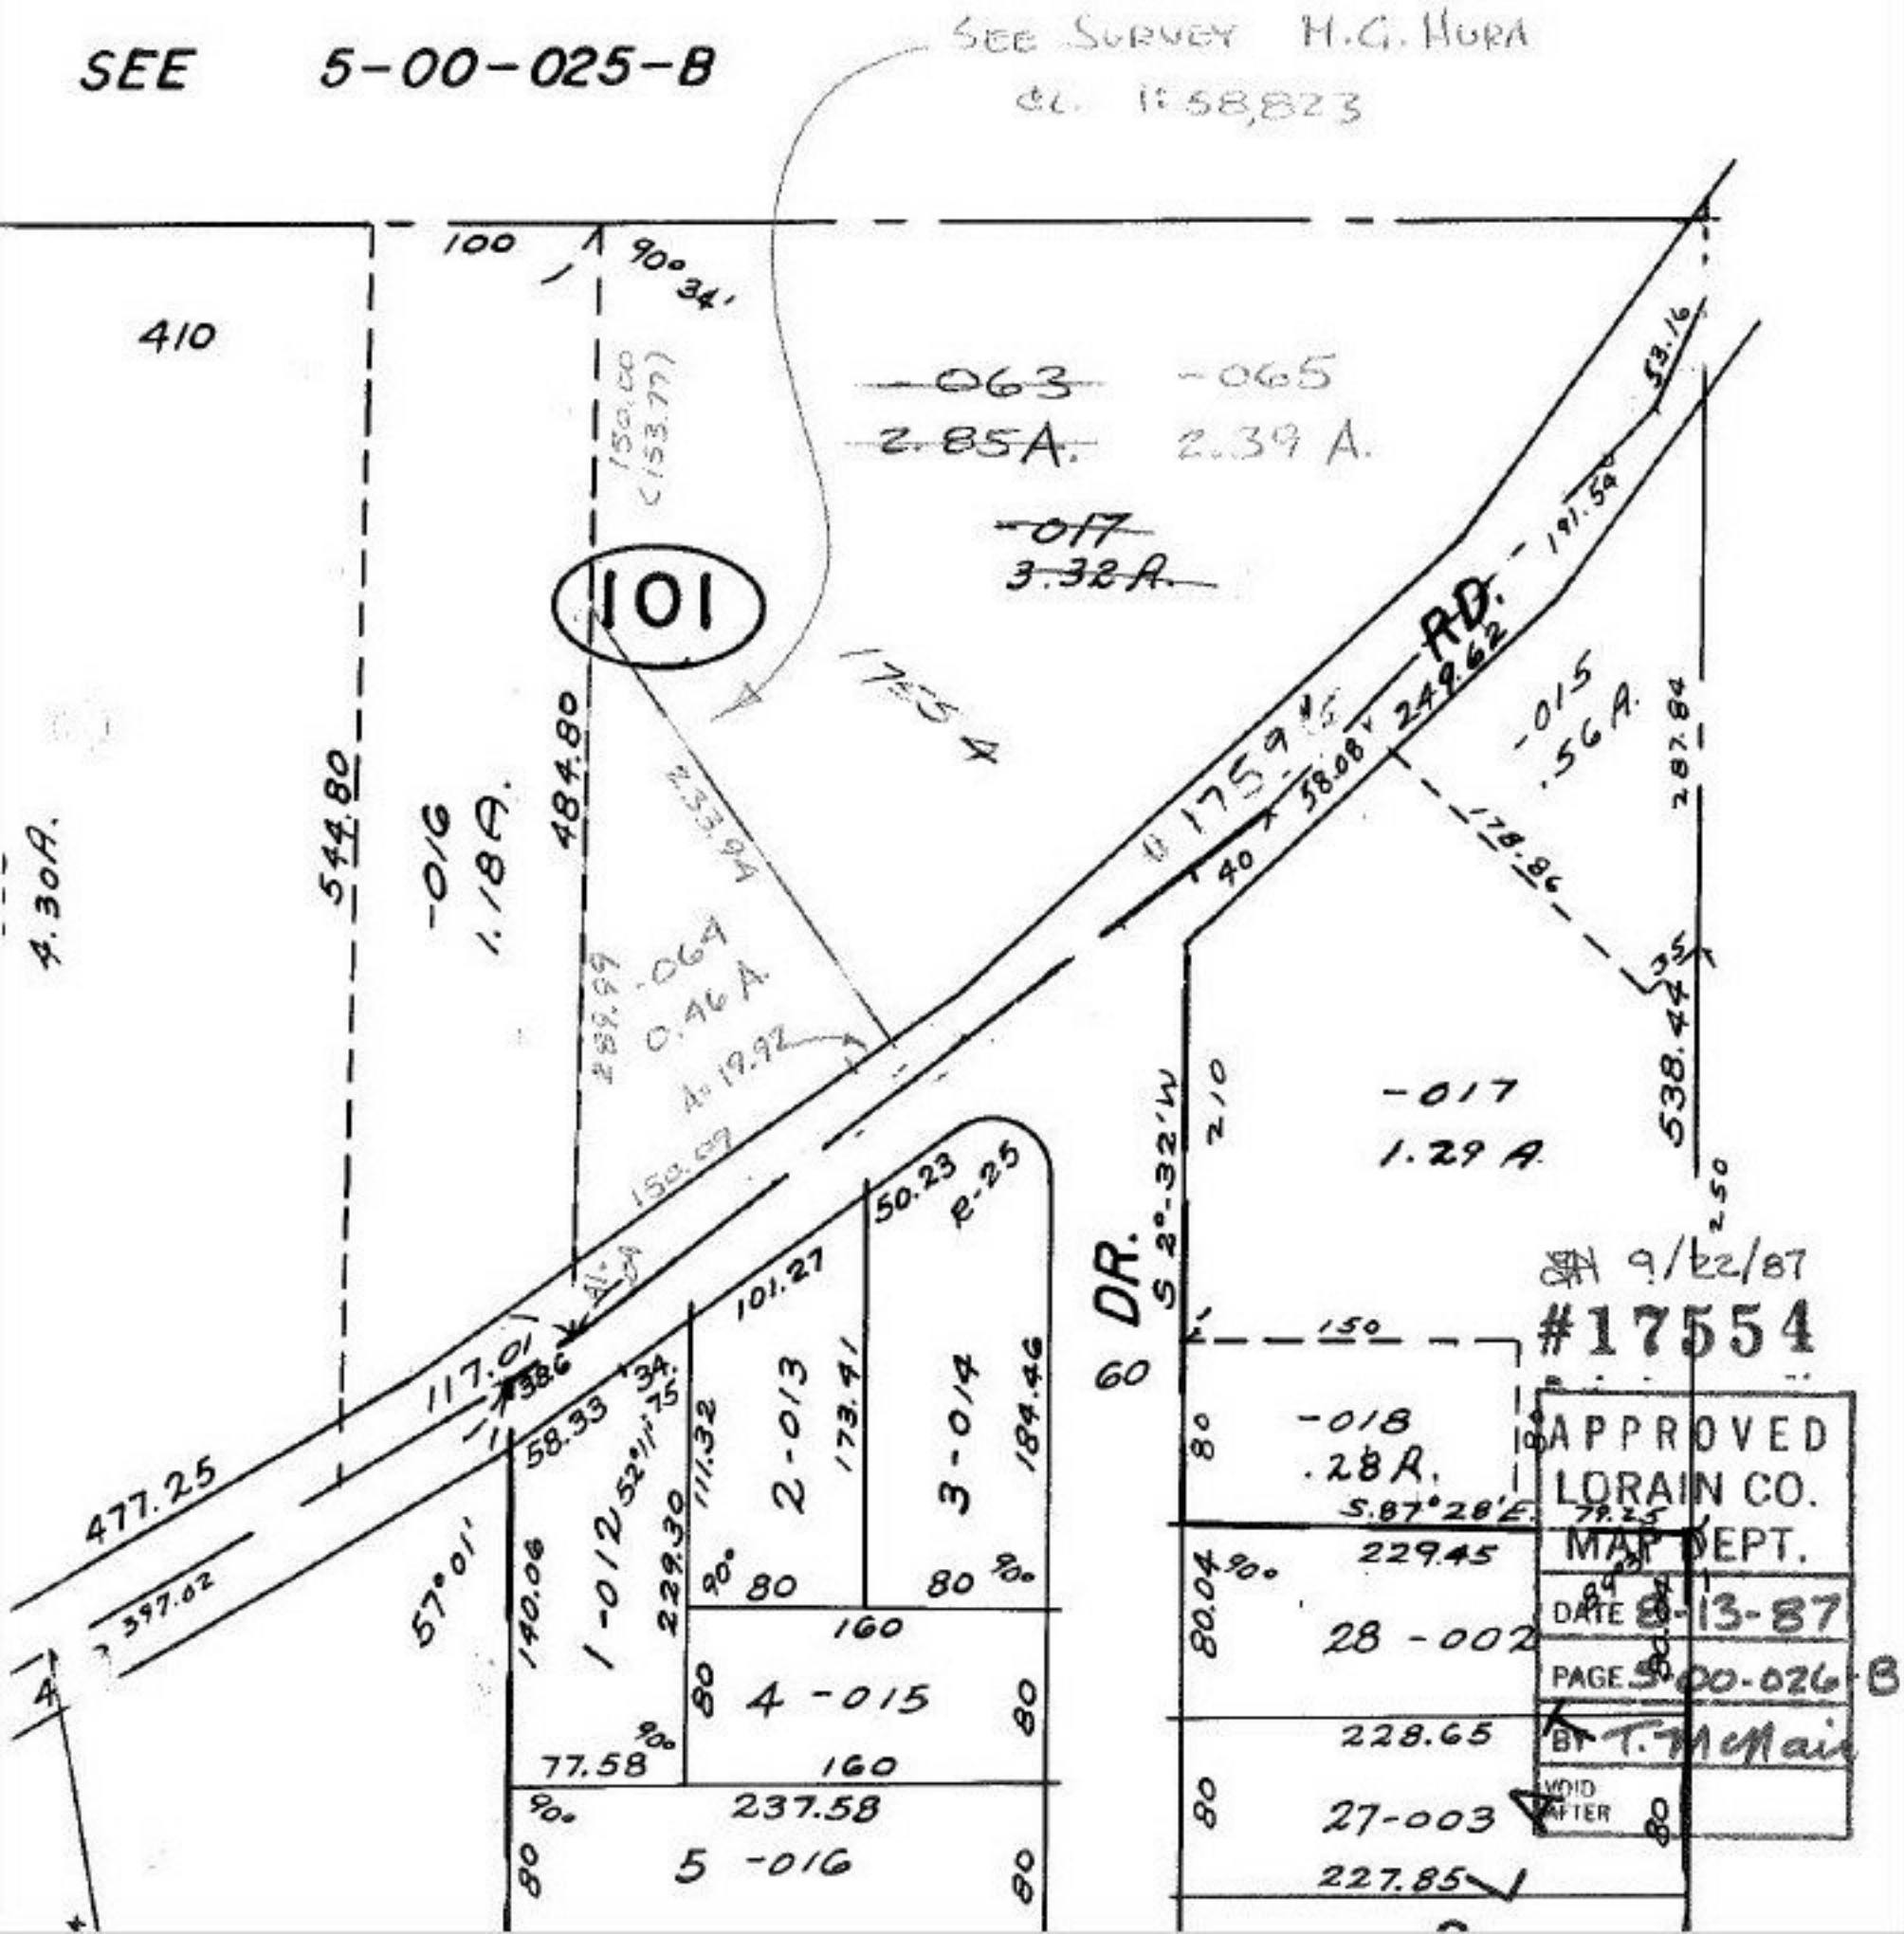
SEE 5-00-025-B
SEE SURVEY M.G. HURA
CL. 1:58,823
100
90° 34'
410
150.00 (153.77)
~~-063~~ -065
~~2.85A.~~ 2.39 A.
~~-017~~
~~3.32A.~~
101
1755 4
RD.
1759
249.62
58.08
40
53.16
191.54
-015
.56A.
287.84
178.86
538.44
35
544.80
-016
1.18A.
484.80
4.30A.
233.94
289.99
-064
0.46 A.
A=19.92
150.09
-017
1.29 A.
210
S 2°-32'W
DR.
60
150
50.23
R-25
101.27
117.01
58.33
34.75
52°11'
1-012
229.30
111.32
2-013
173.41
3-014
184.46
477.25
397.02
57°01'
140.06
80
160
4-015
77.58
237.58
5-016
-018
.28A.
S.87°28'E.
79.25
229.45
80.04
28-002
228.65
27-003
227.85
9/22/87
#17554
APPROVED
LORAIN CO.
MAP DEPT.
DATE 8-13-87
PAGE 5-00-026-B
BY T. McNair
VOID AFTER