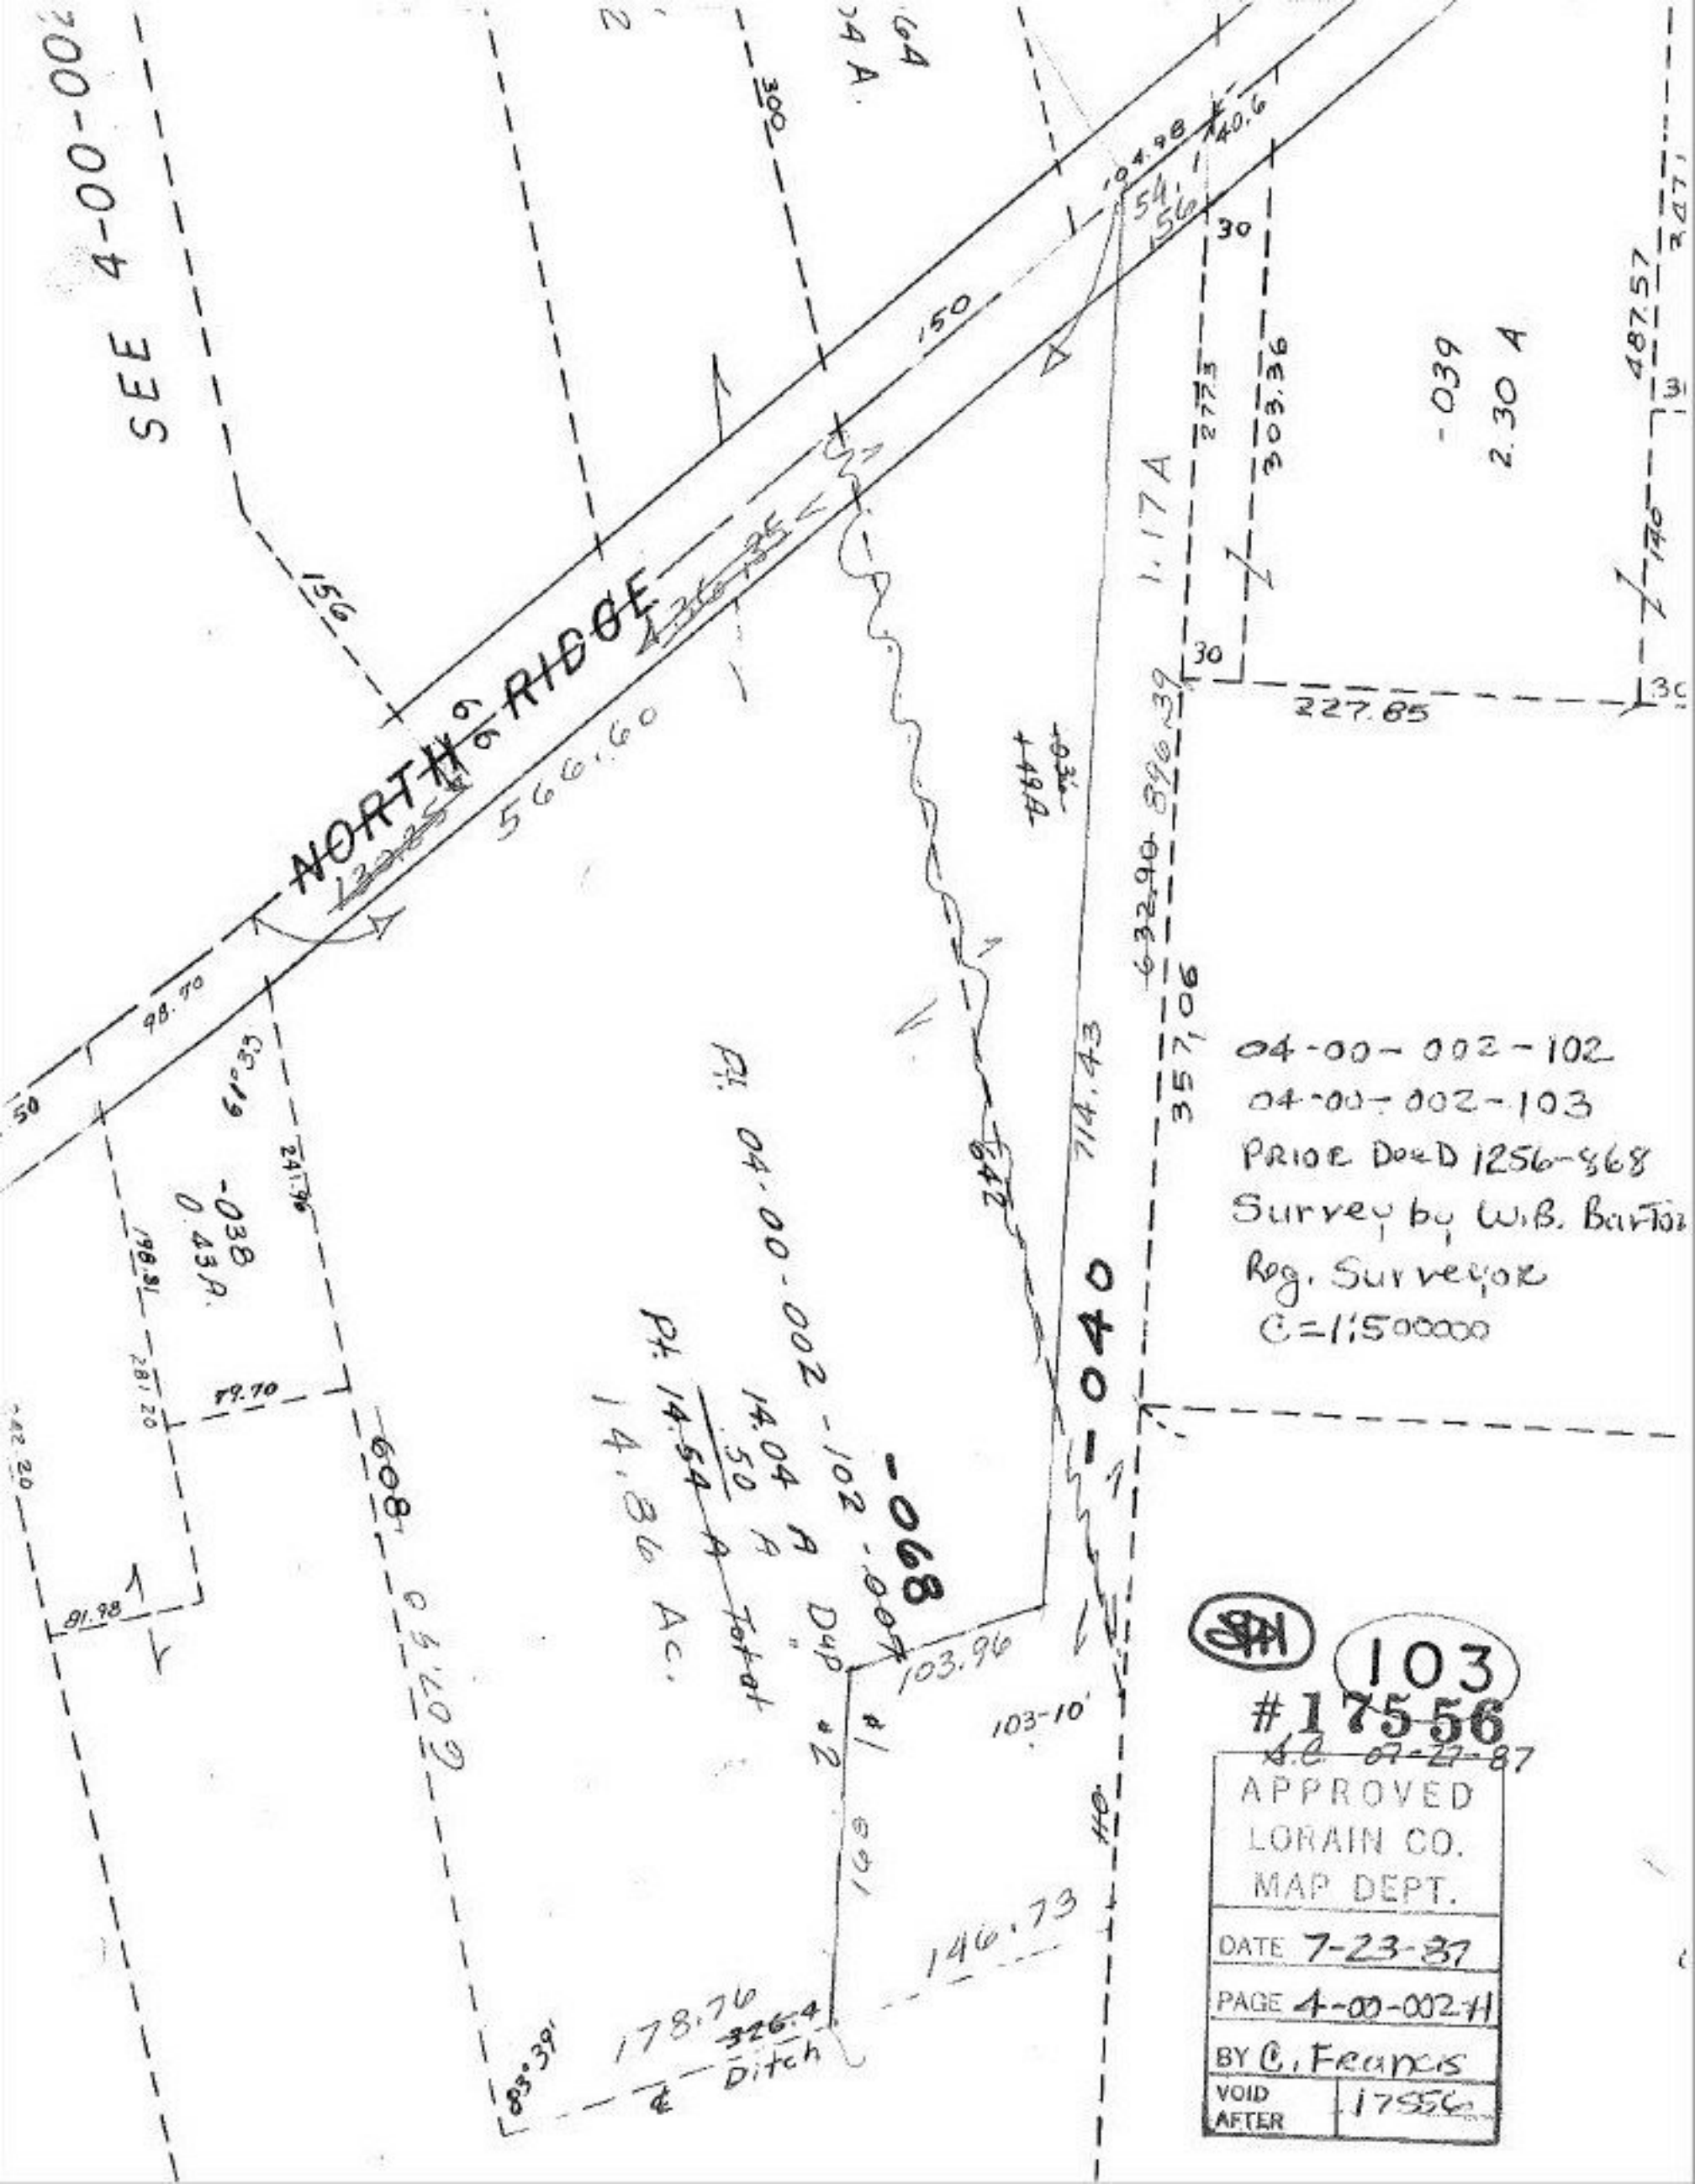
SEE 4-00-002
NORTH RIDGE
566.60
-039
2.30 A
1.17 A
227.85
04-00-002-102
04-00-002-103
PRIOR DEED 1256-868
Survey by W.B. Barton
Reg. Surveyor
C=1:500000
-040
-068
14.04 A Dup
.50 A
14.86 Ac.
103.96
103-10'
146.73
178.76
326.4
Ditch
103
#17556
APPROVED
LORAIN CO.
MAP DEPT.
DATE 7-23-87
PAGE 4-00-002-H
BY C. Francis
VOID AFTER 17556