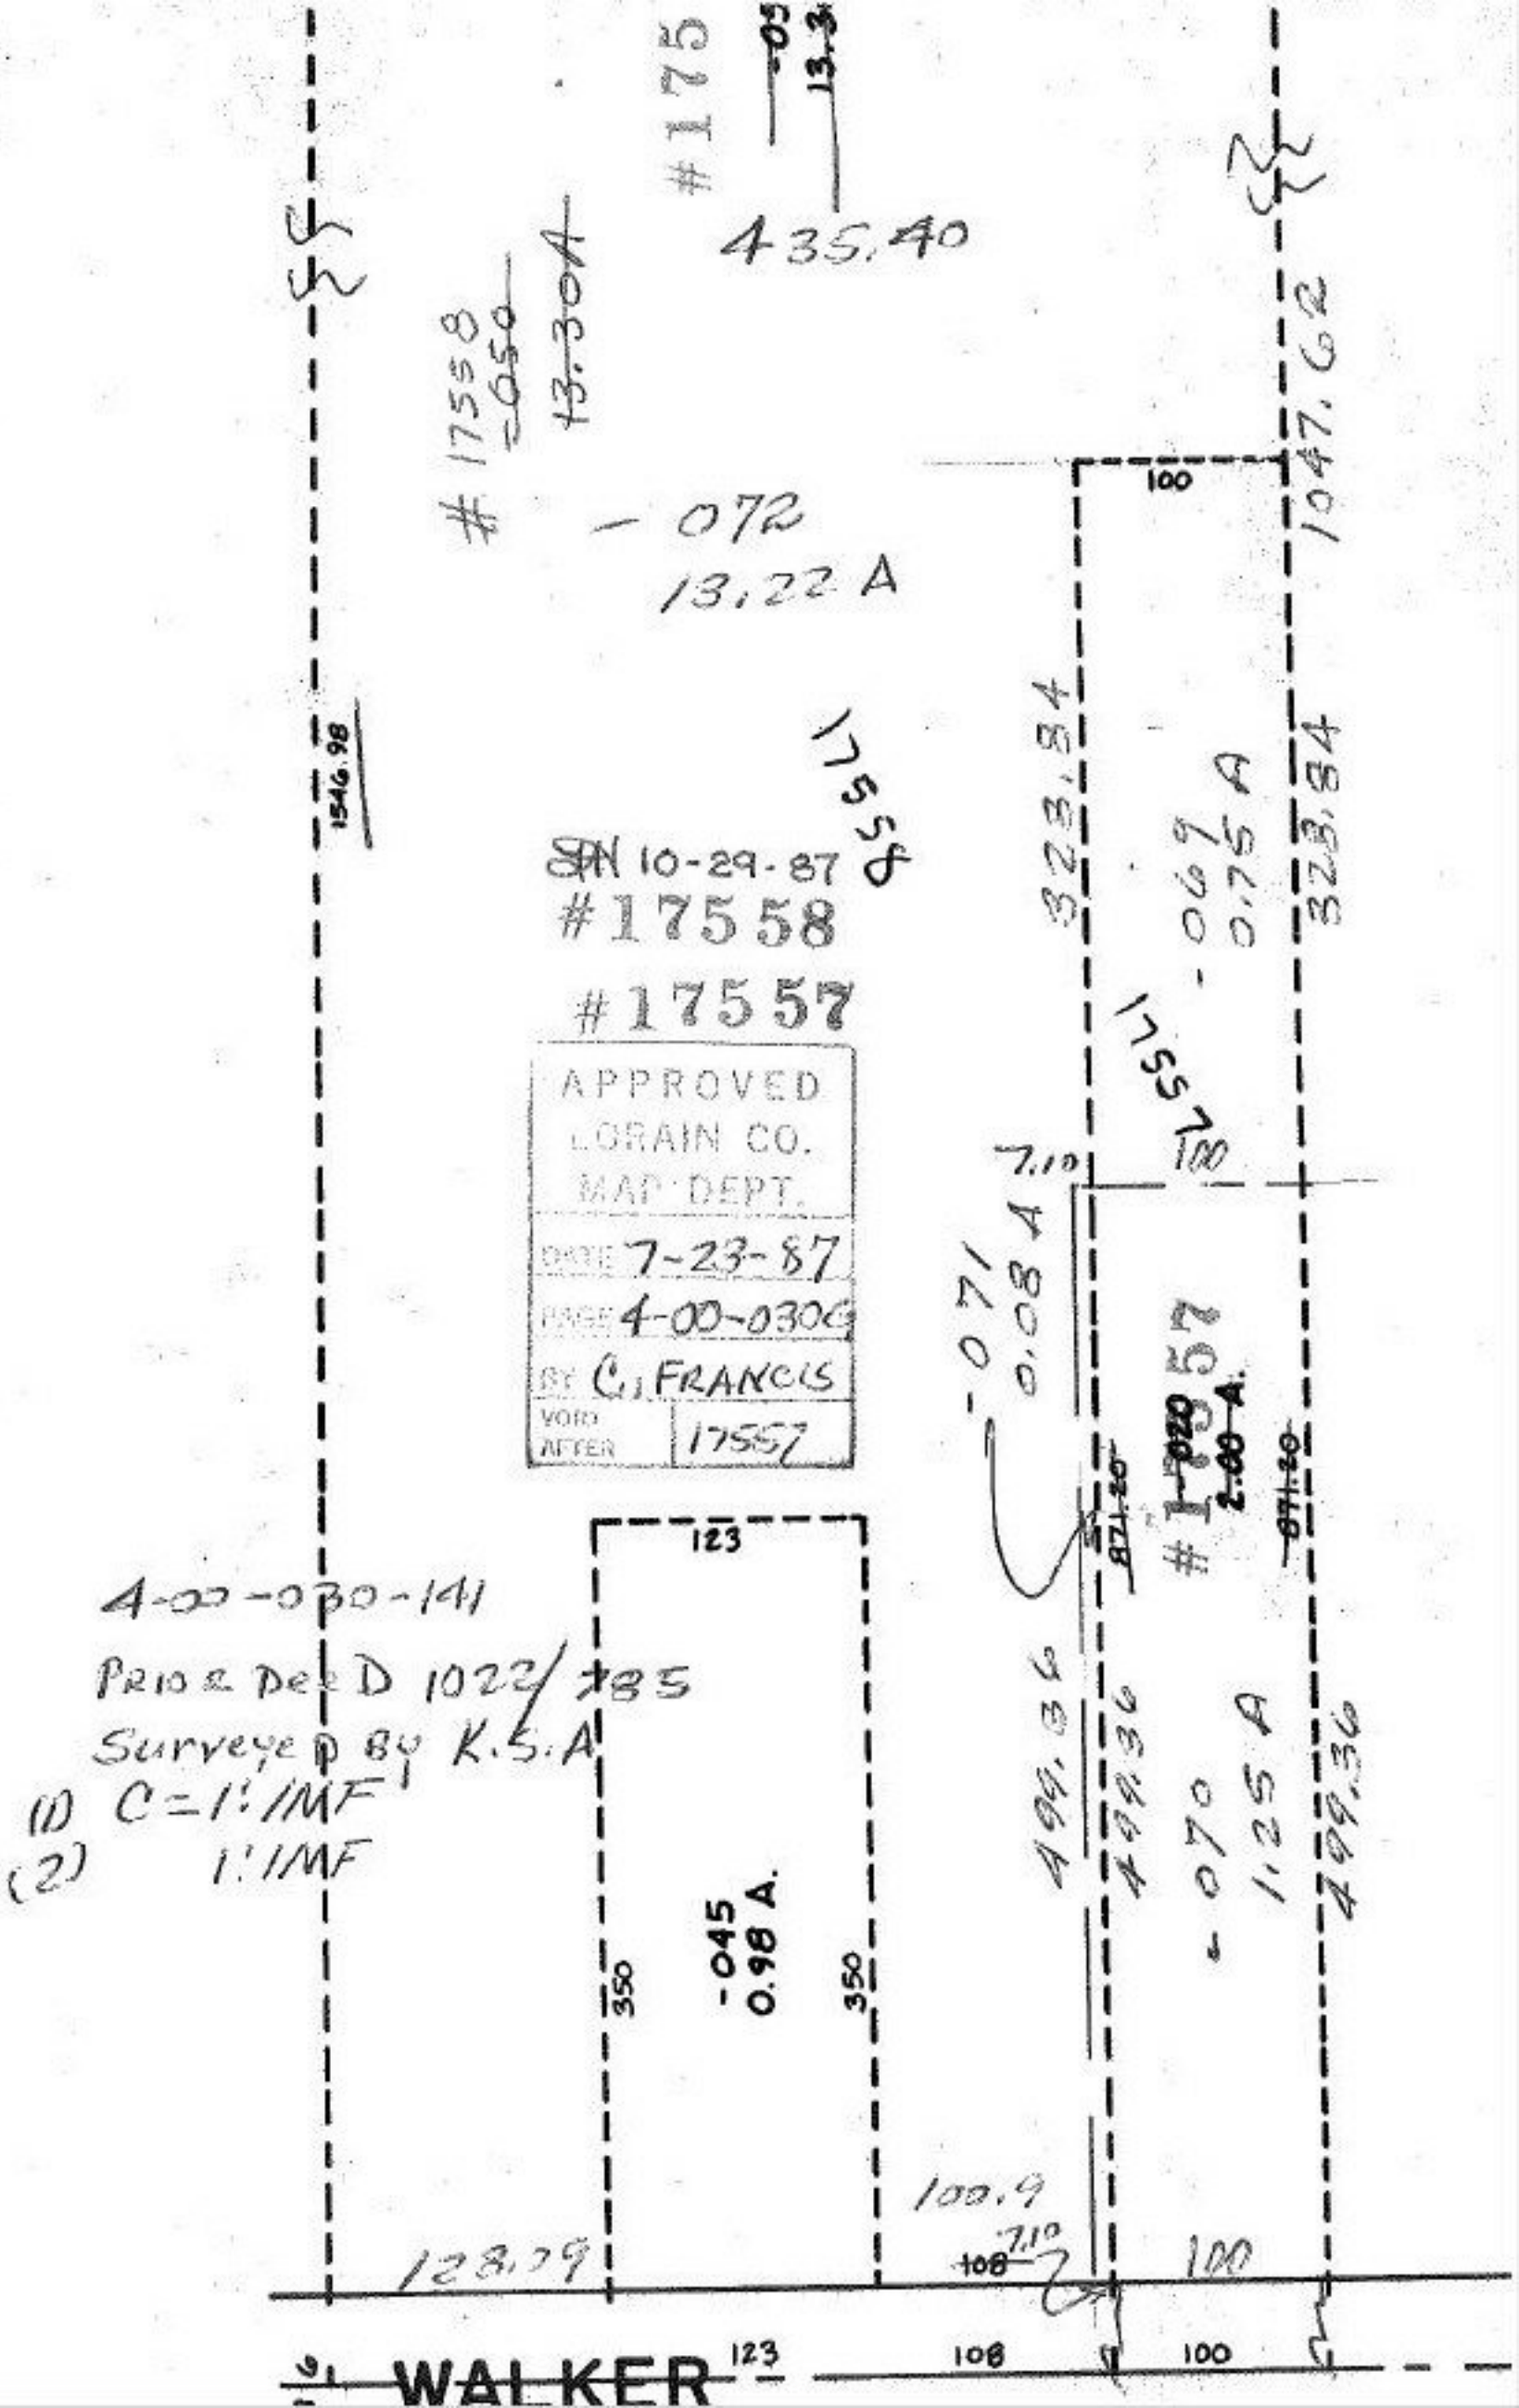

#175
-05
13.3
435.40
#17558
-050
13.30A
-072
13.22 A
1047.62
100
1546.98
17558
SPN 10-29-87
#17558
#17557
APPROVED
LORAIN CO.
MAP DEPT.
DATE 7-23-87
PAGE 4-00-030G
BY C. FRANCIS
VOID AFTER 17557
323.84
-069
0.75 A
323.84
17557
7.10
100
-071
0.08 A
#17557
2.00 A.
871.20
871.20
123
4-00-030-141
PRIOR DEED 1022/785
Surveyed BY K.S.A
(1) C=1:1MF
(2) 1:1MF
-045
0.98 A.
350
350
499.36
499.36
-070
1.25 A
499.36
100.9
7.10
108
100
128.09
123
108
100
WALKER