~~Pt. -028~~
~~Pt. 50.79 A.~~
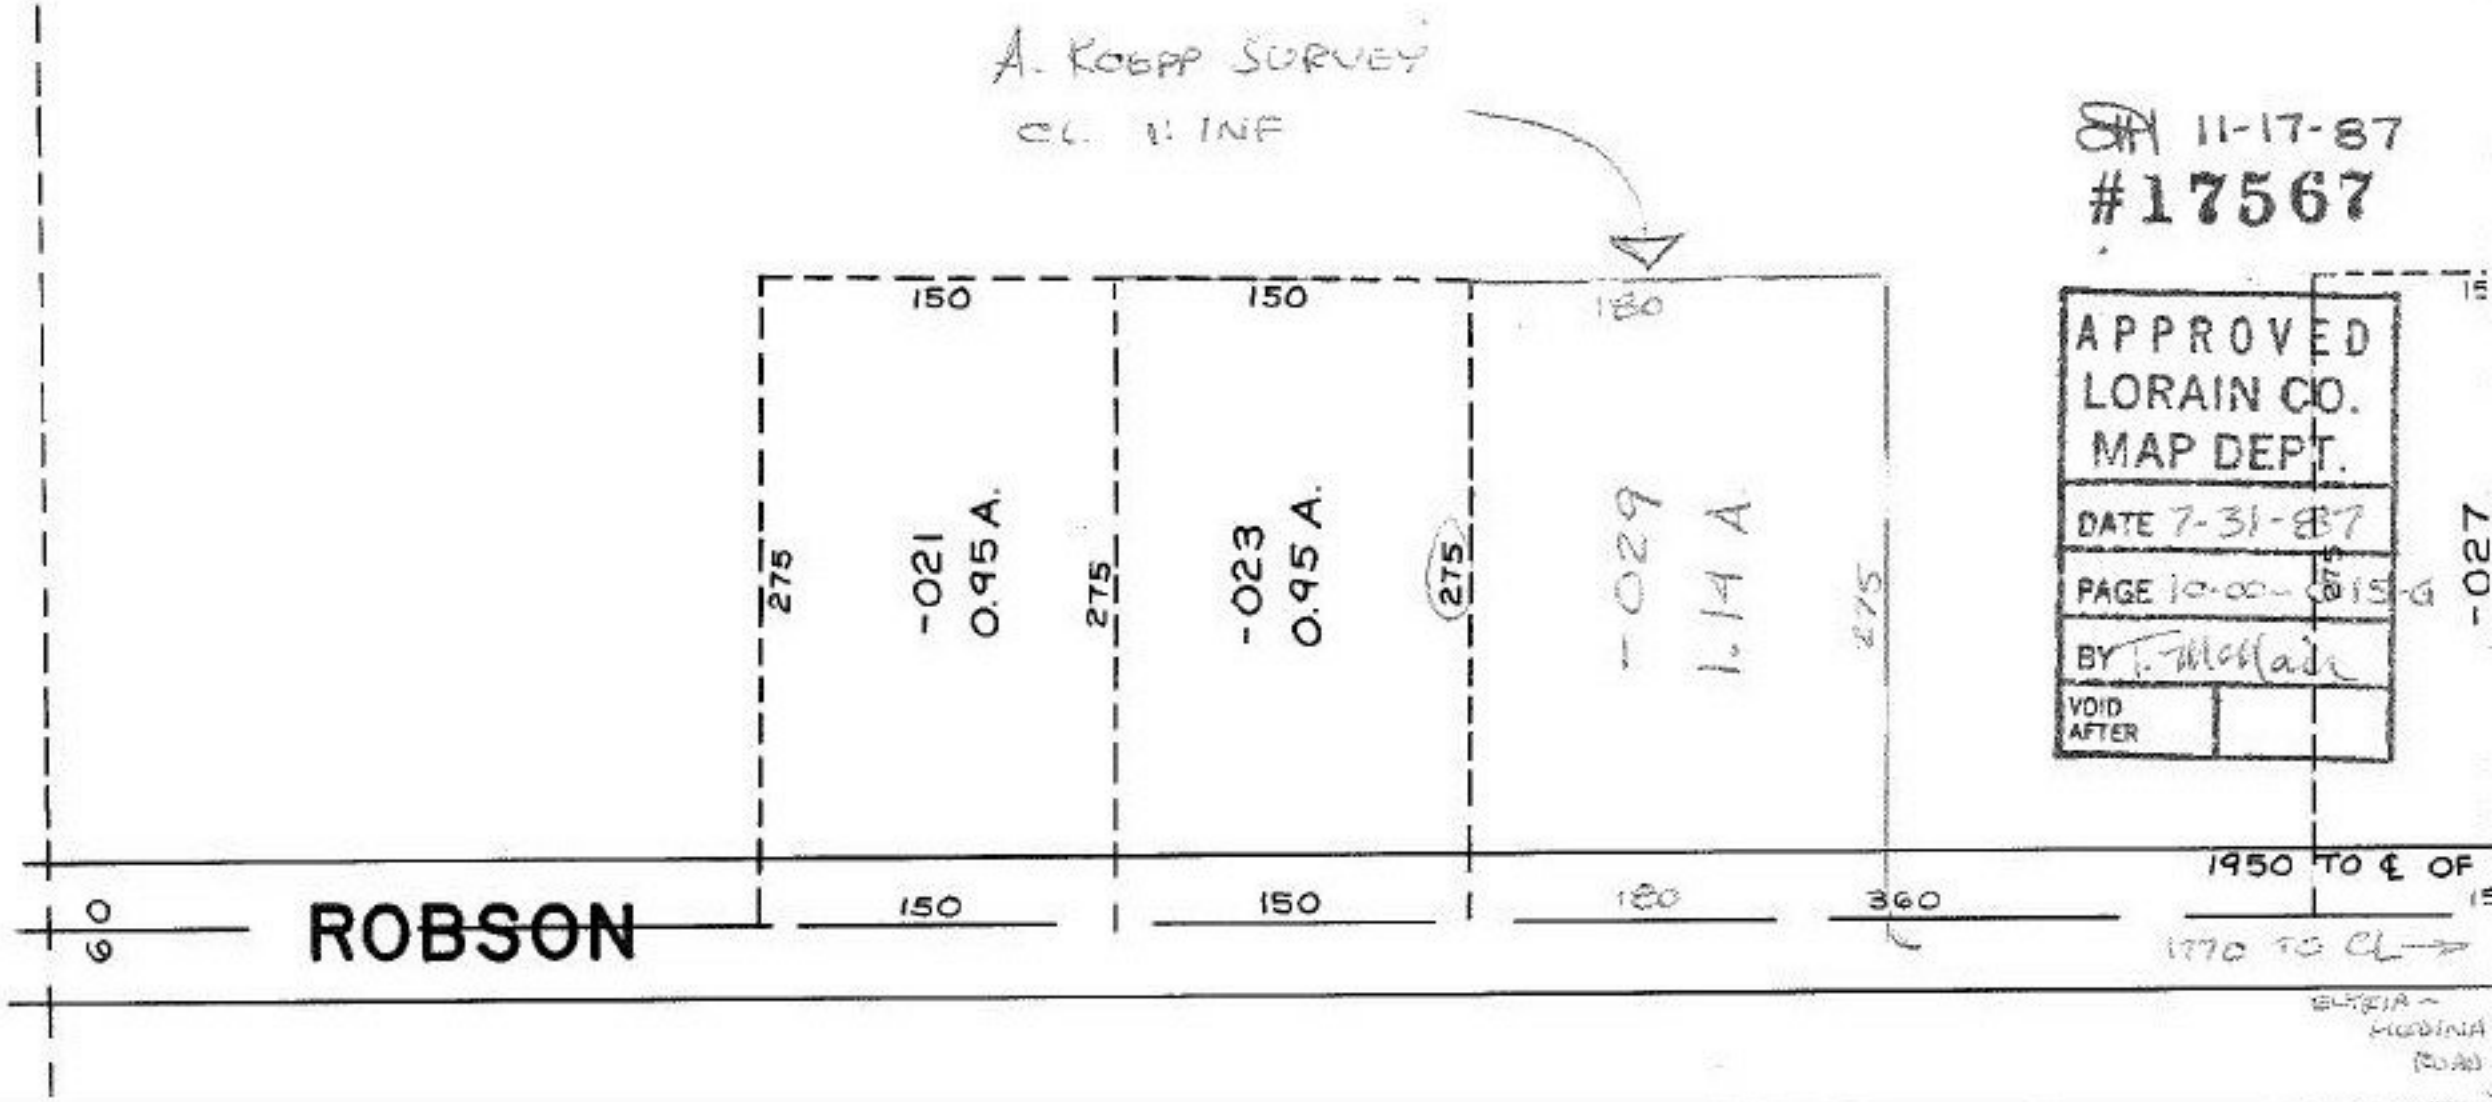
#17567
-030
49.65 A.