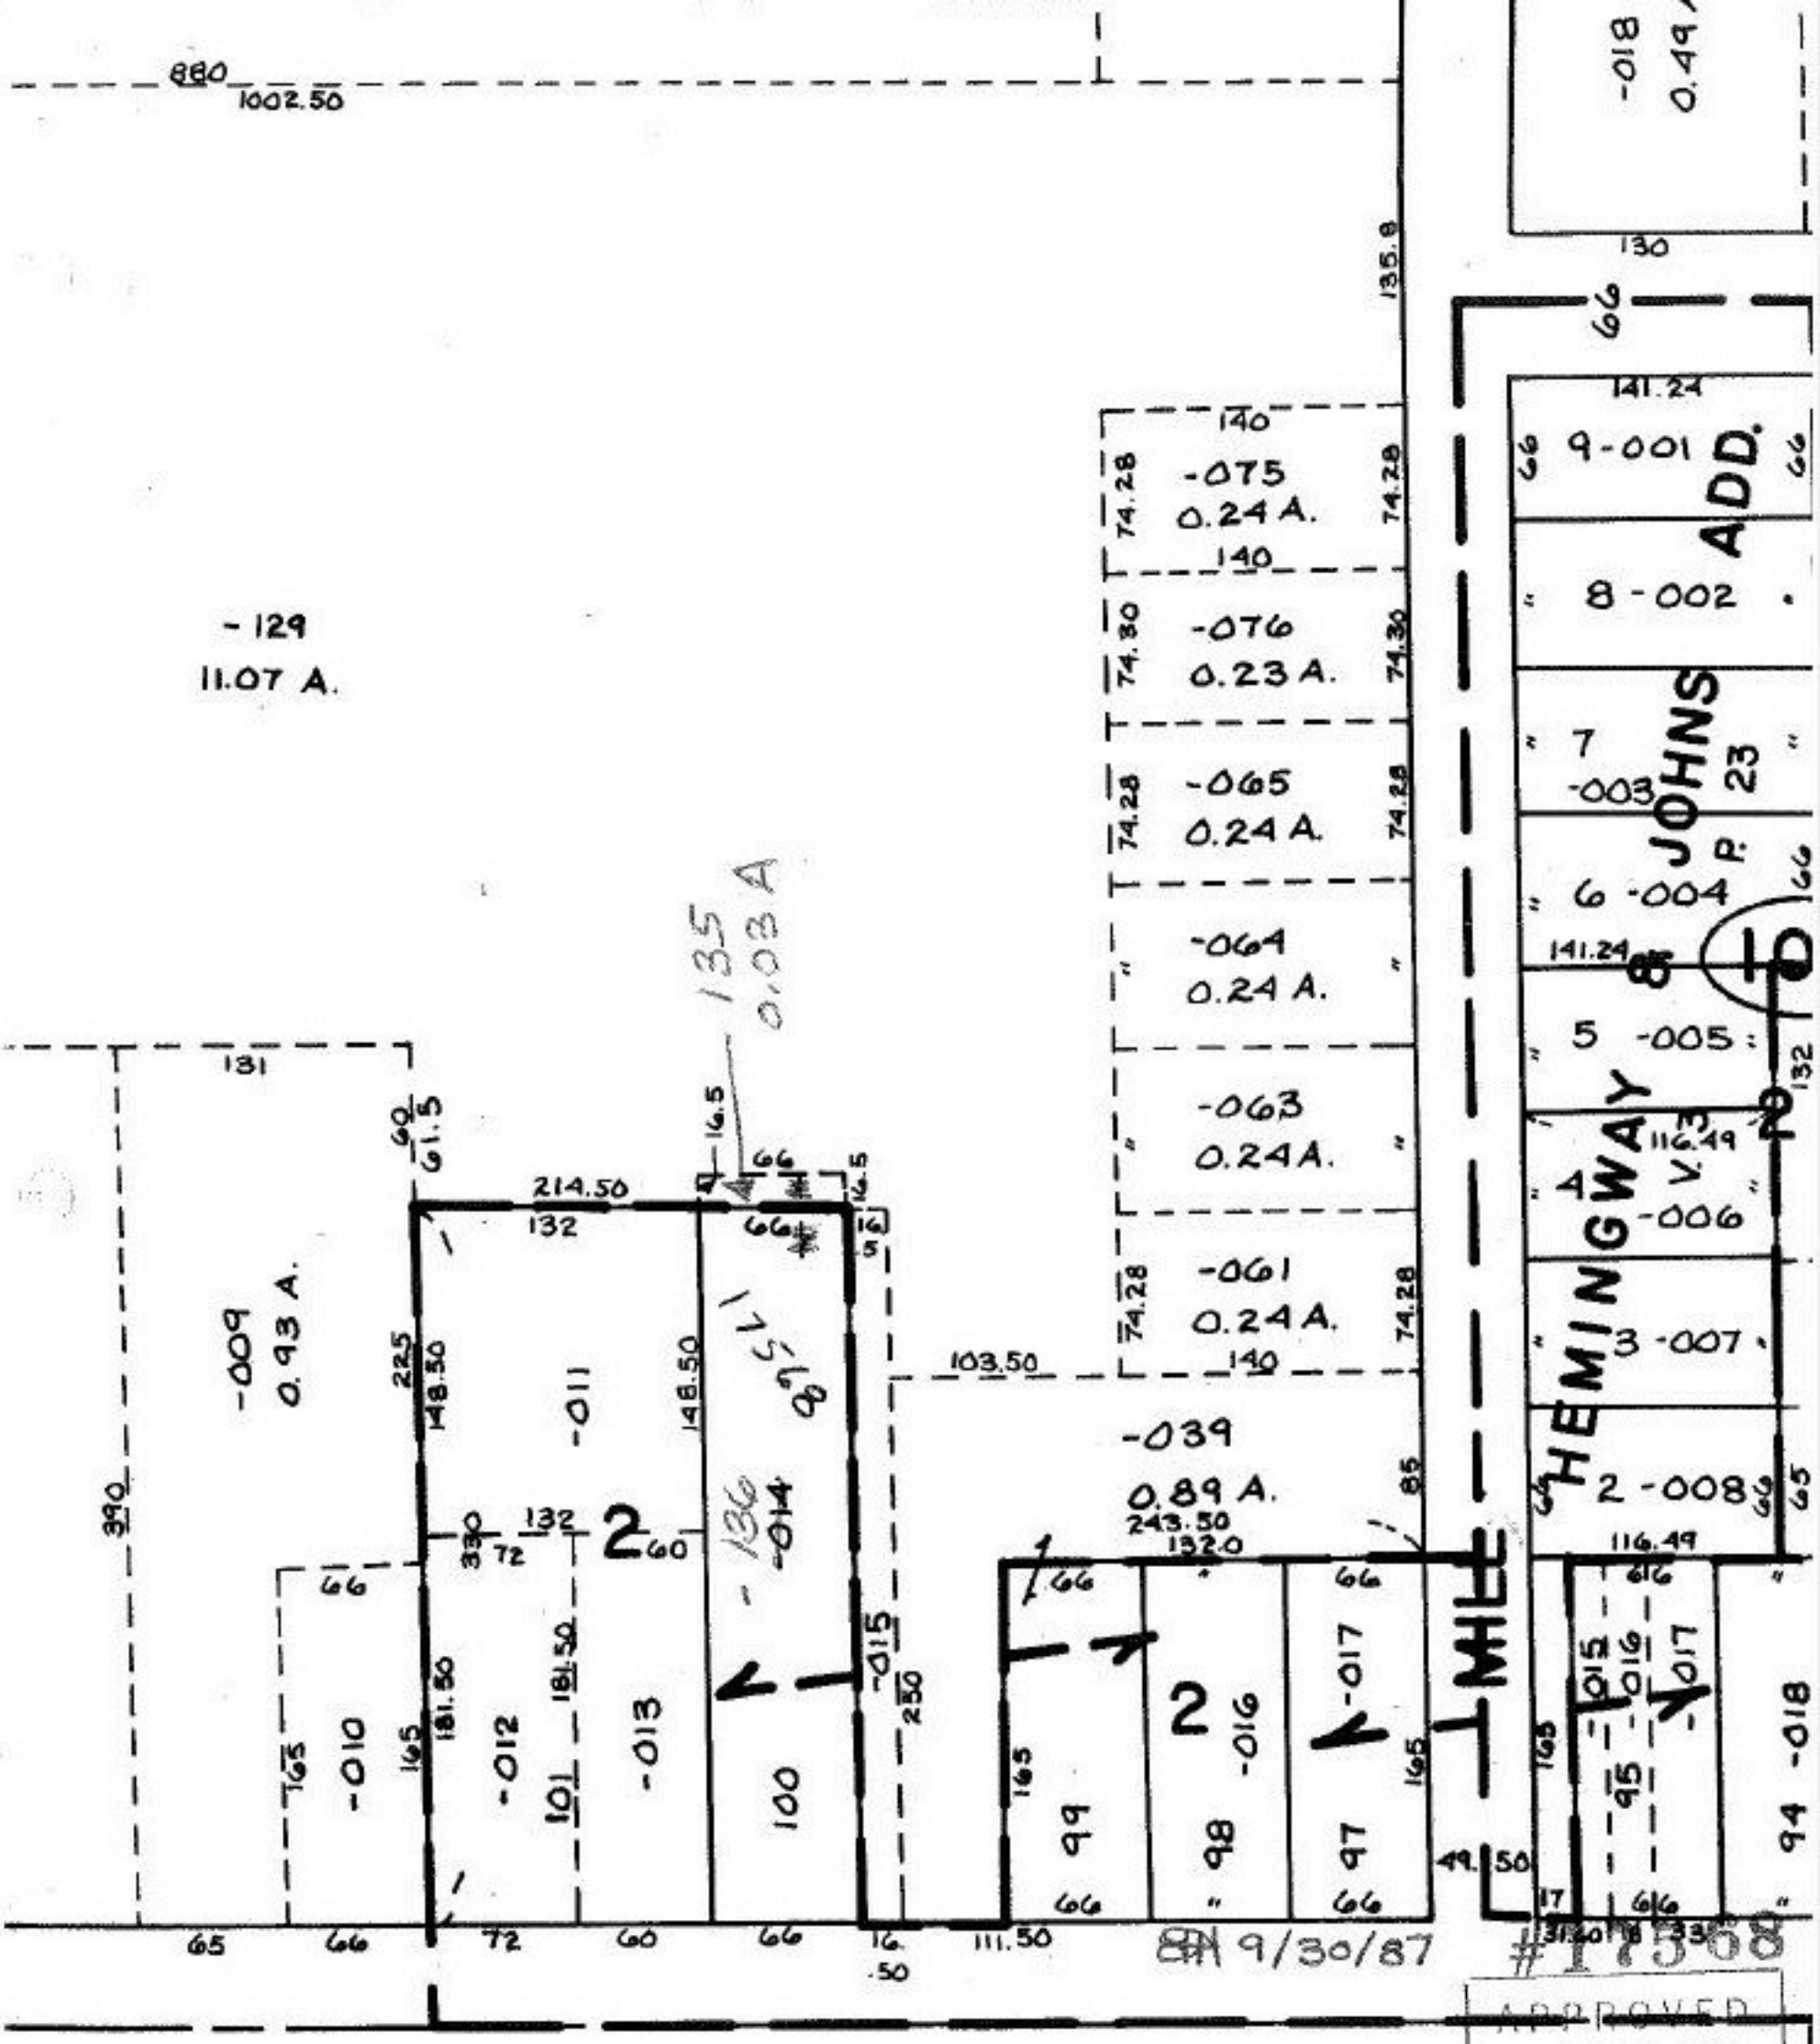

SEE 18-00-027-A

18-00-027-101
PRIOR DEED 1145-445
Surveyed By W. B. Barton
Reg. Surveyor
C=1:1NF

APPROVED
LORAIN CO.
MAP DEPT.
DATE 8-3-87
PAGE 18-00-028 C
BY C. Francis
VOID