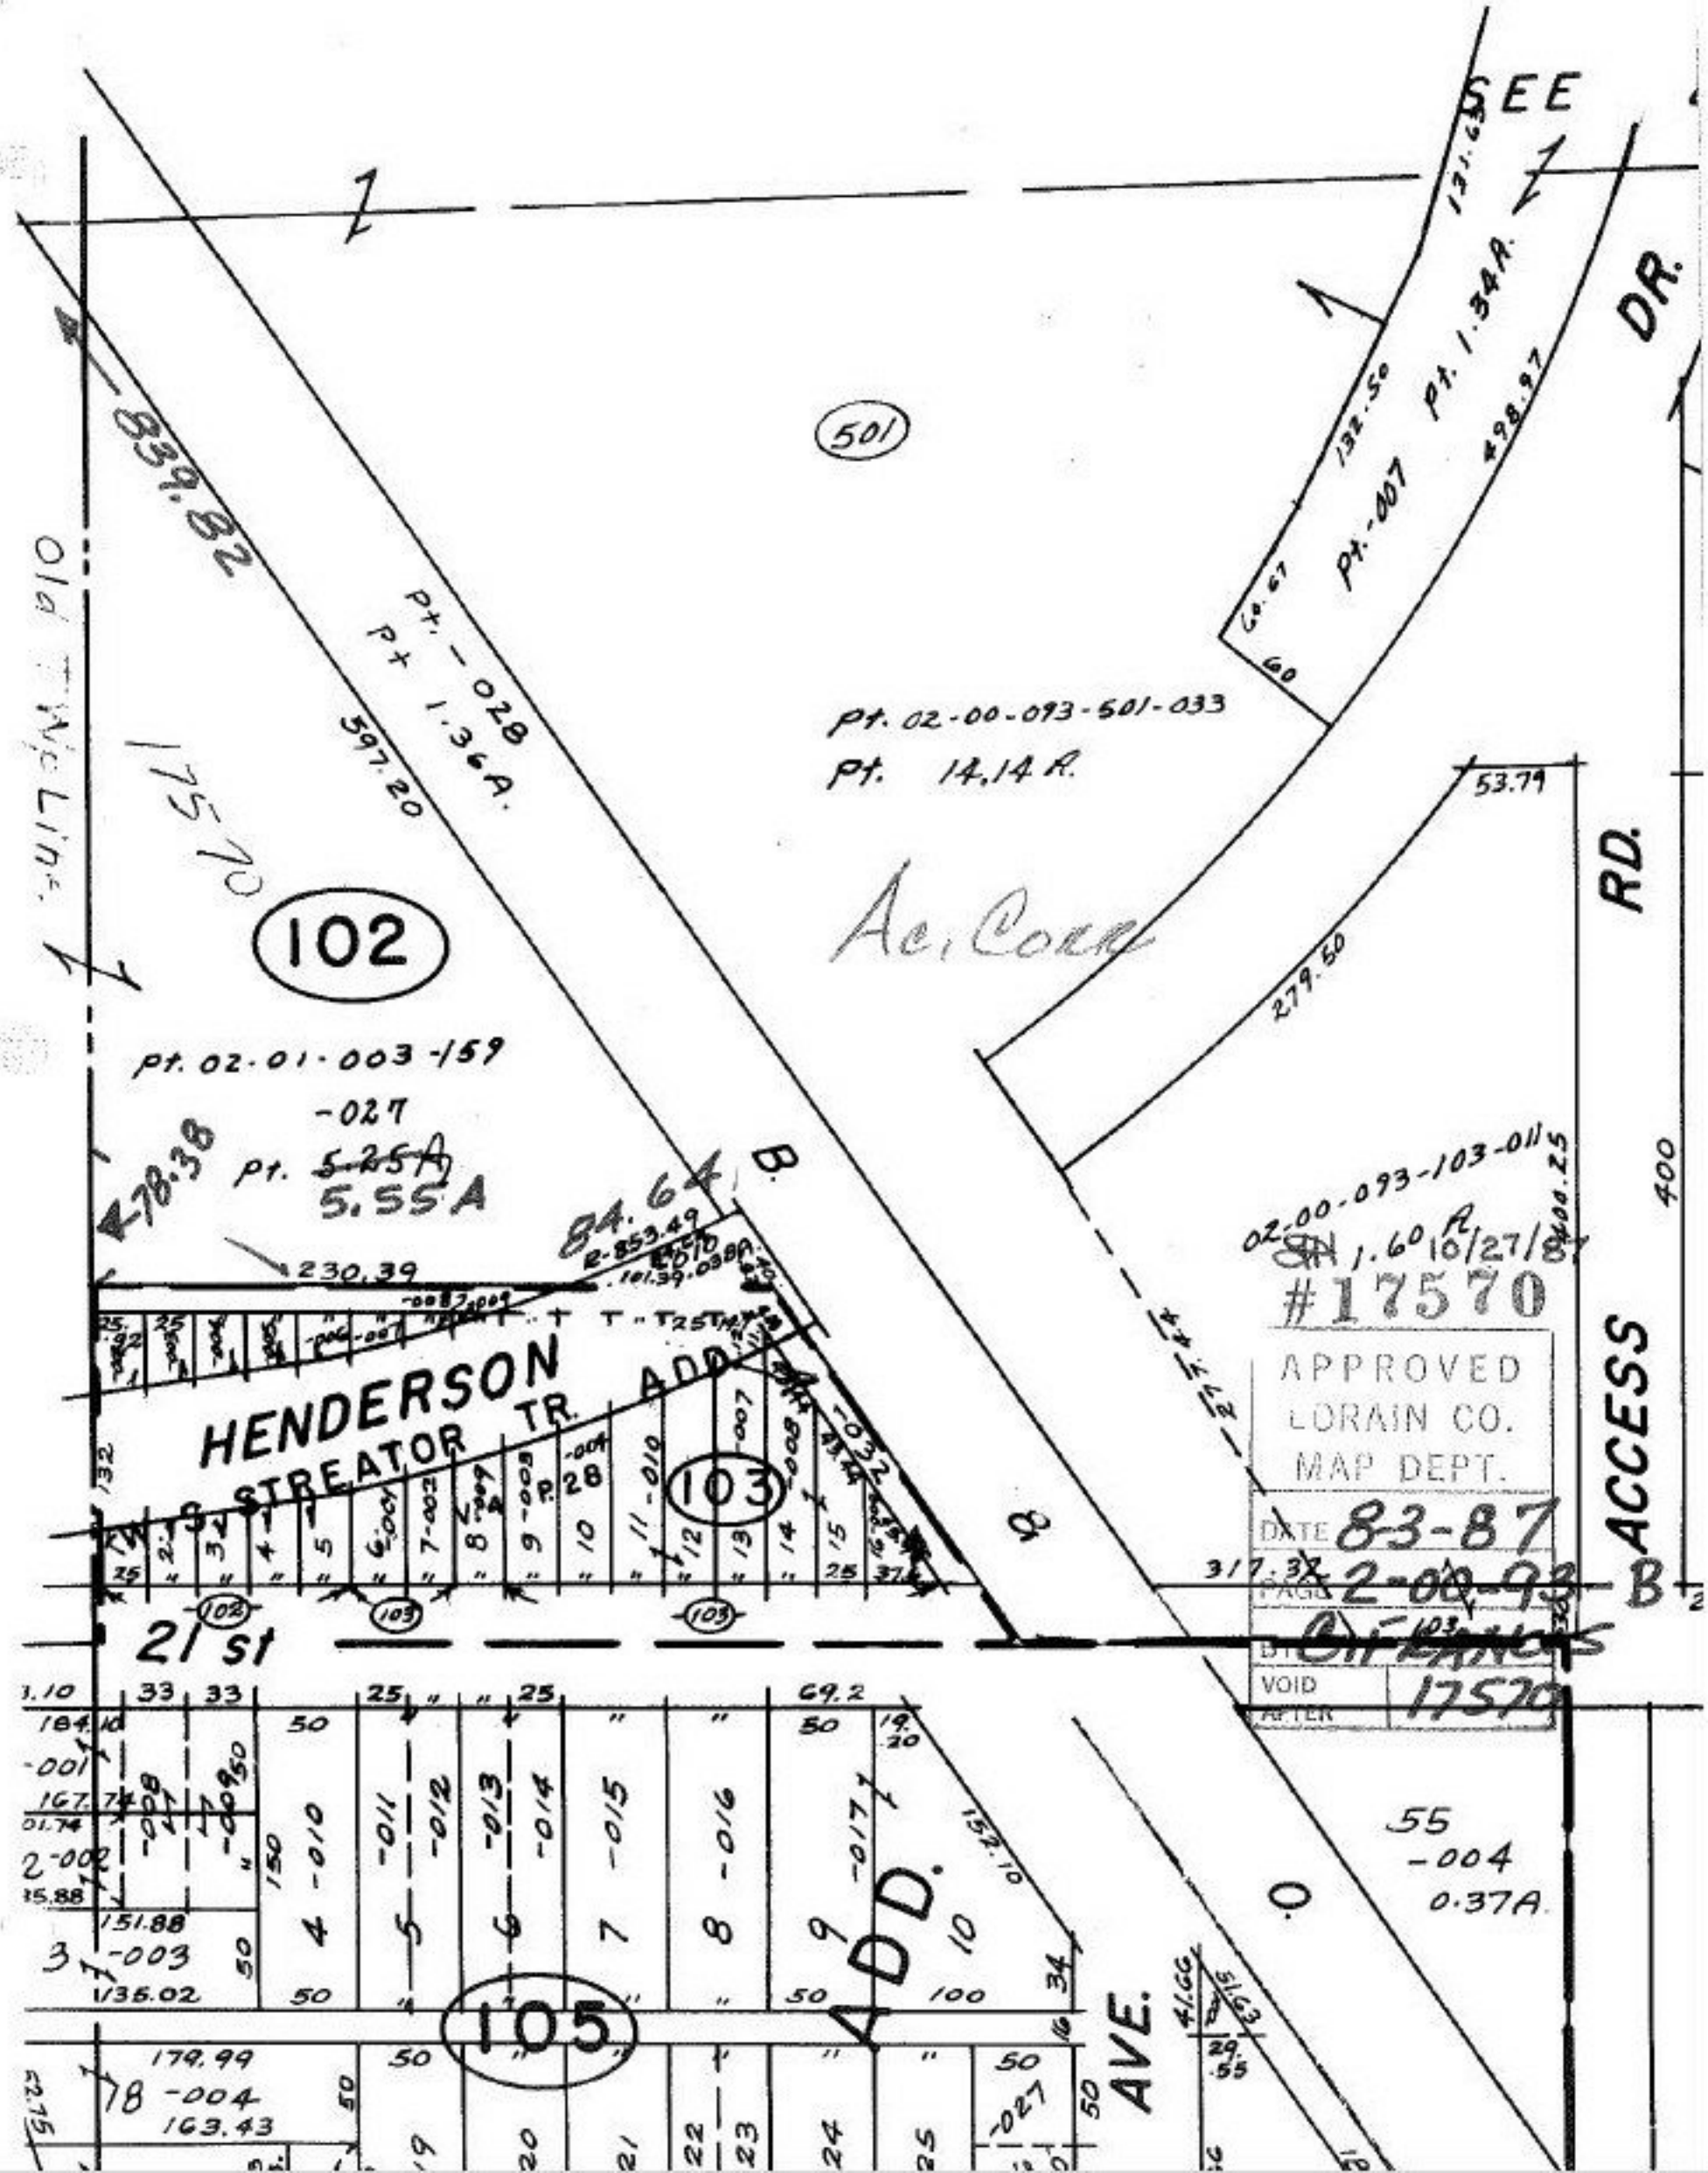
SEE
DR.
RD.
ACCESS
501
102
103
105
Pt. 02-00-093-501-033
Pt. 14.14 R.
Pt. -007
Pt. 1.34 A.
Pt. -028
Pt 1.36 A.
Pt. 02-01-003-159
-027
Pt. 5.25 A
5.55 A
HENDERSON
STREATOR TR. ADD.
21 st
ADD.
AVE.
Old Twp Line
839.82
597.20
230.39
84.64
78.38
53.79
279.50
400
55
-004
0.37A.
#17570
APPROVED
LORAIN CO.
MAP DEPT.
DATE 8-3-87
PAGE 2-00-93-B
VOID
AFTER 17570