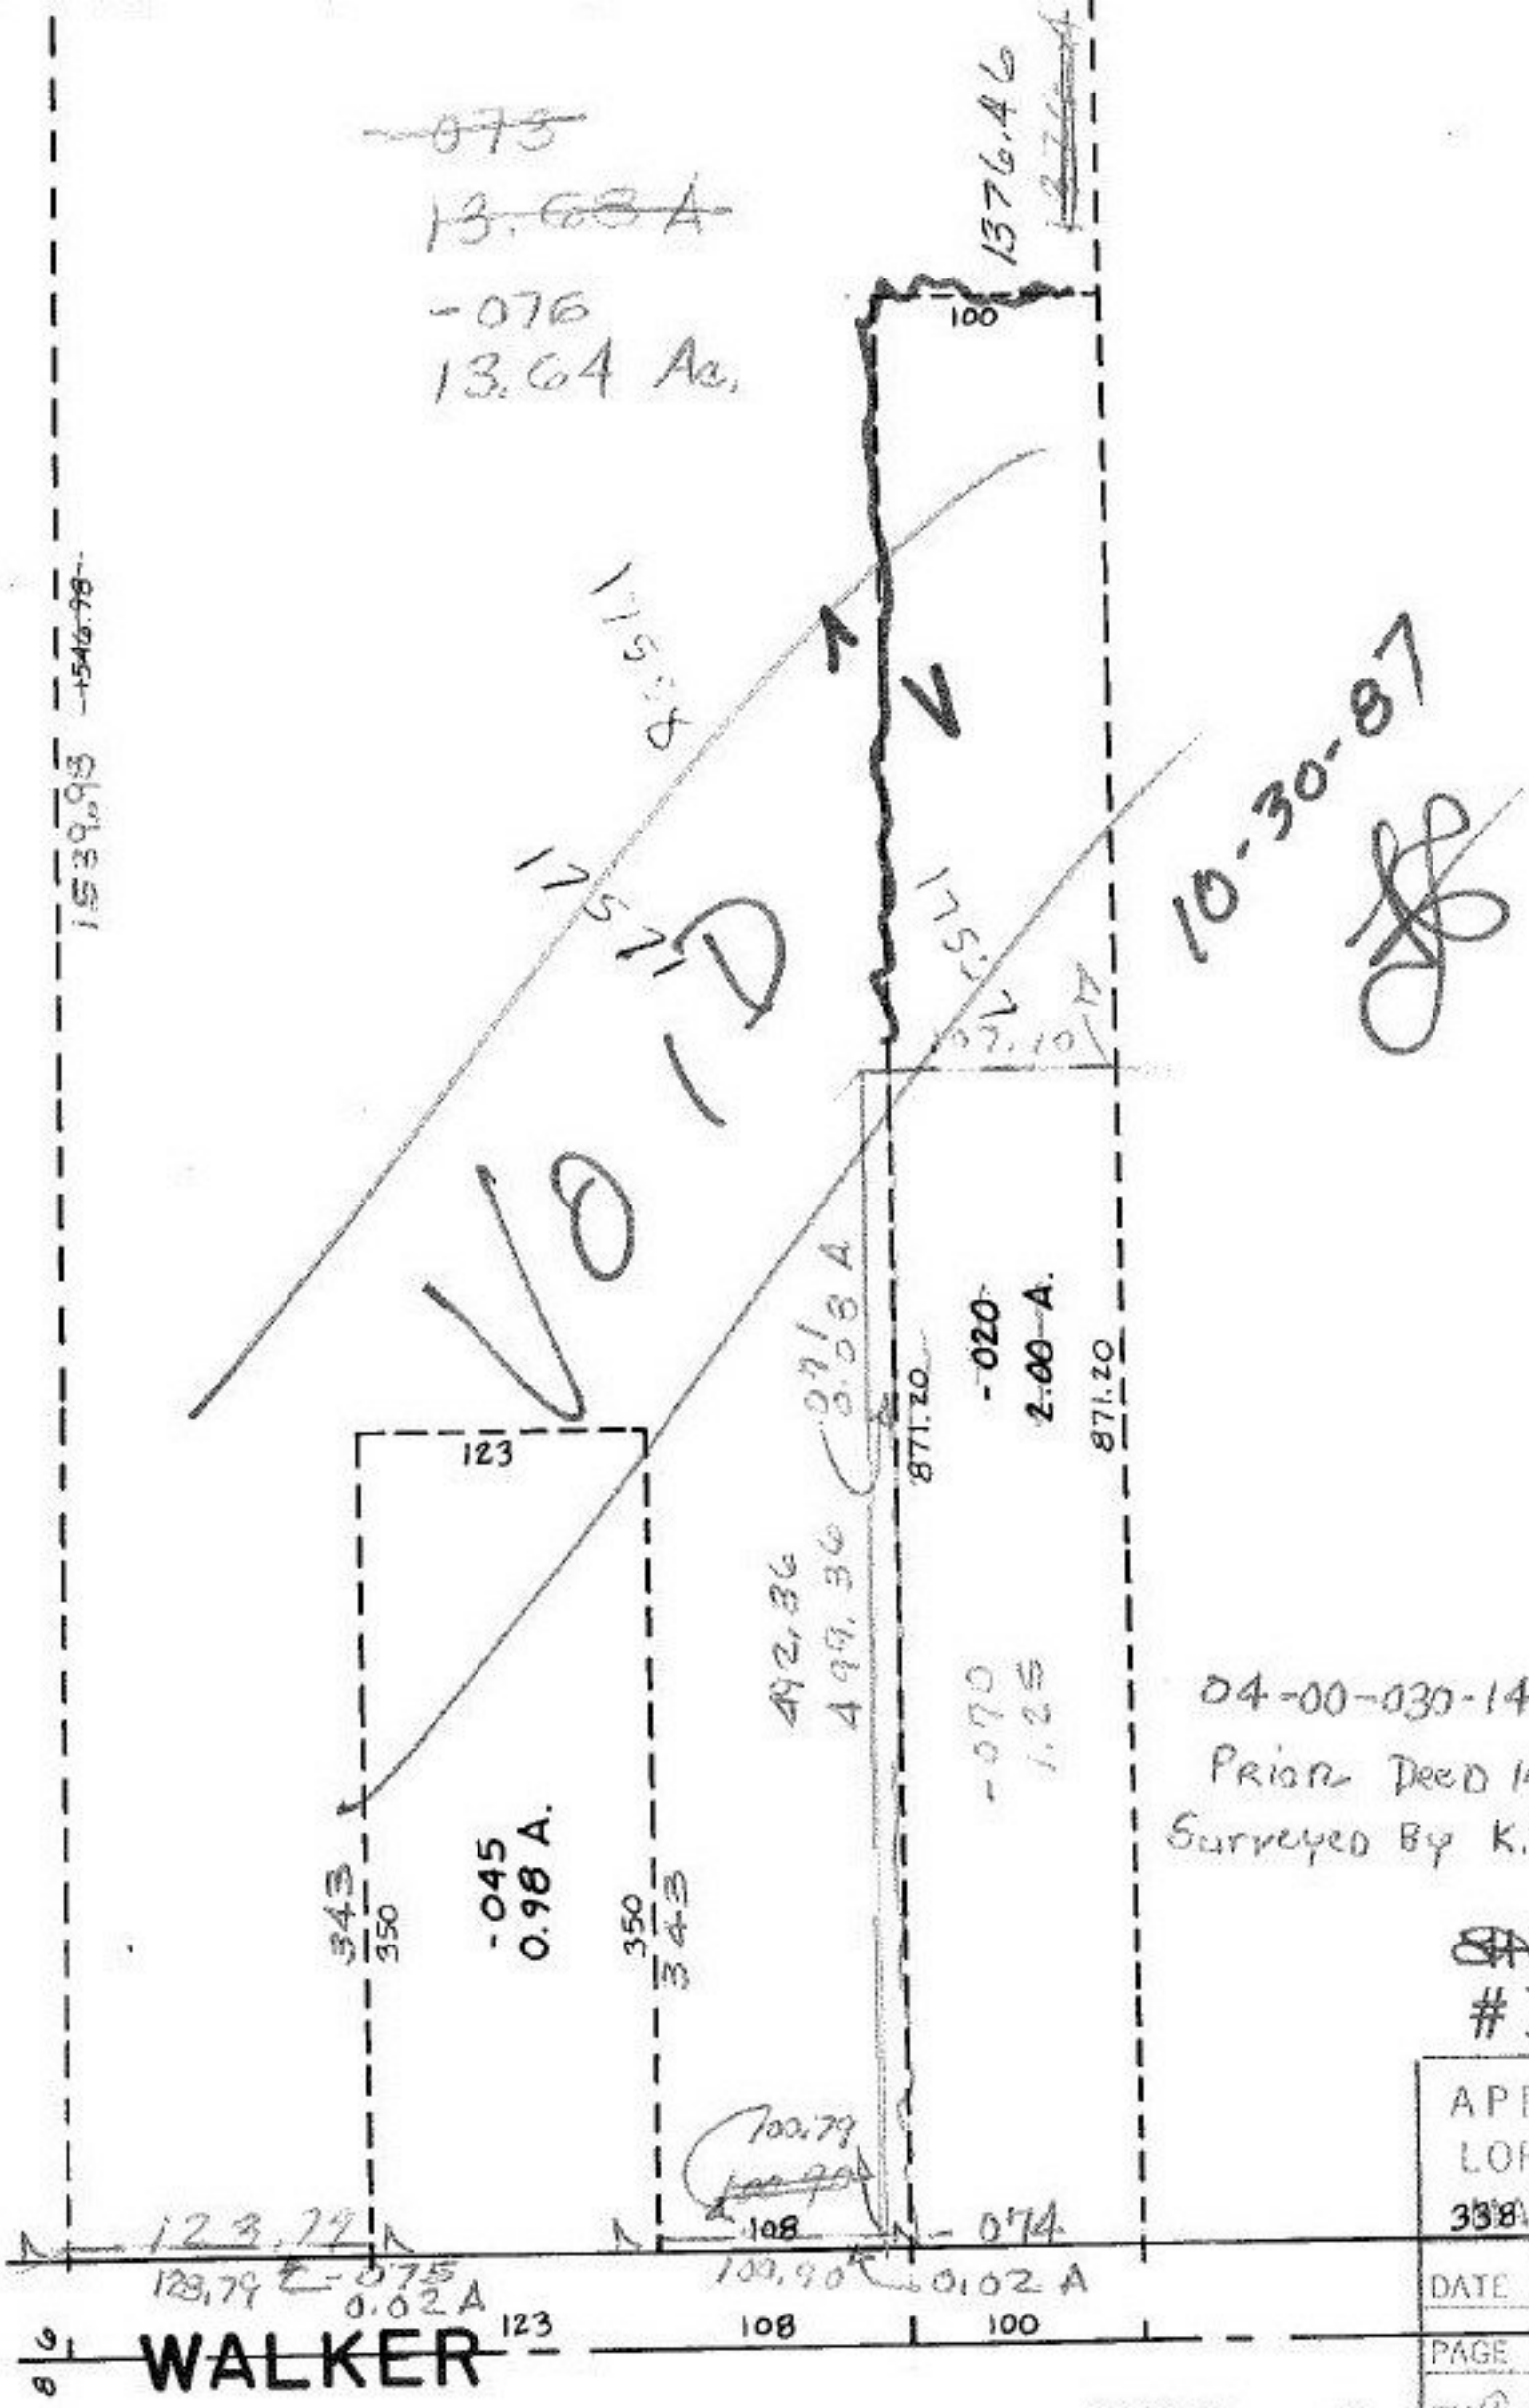

04-00-030-141-
Prior Deed 1427-25
Surveyed By K.S. & Assoc.

11-5-87
#17571

APPROVED
LORAIN CO.
338.70 DEPT.
DATE 8-4-87
PAGE 4-00-030G
BY C. Francis
VOID AFTER 17571

SEE 4-D