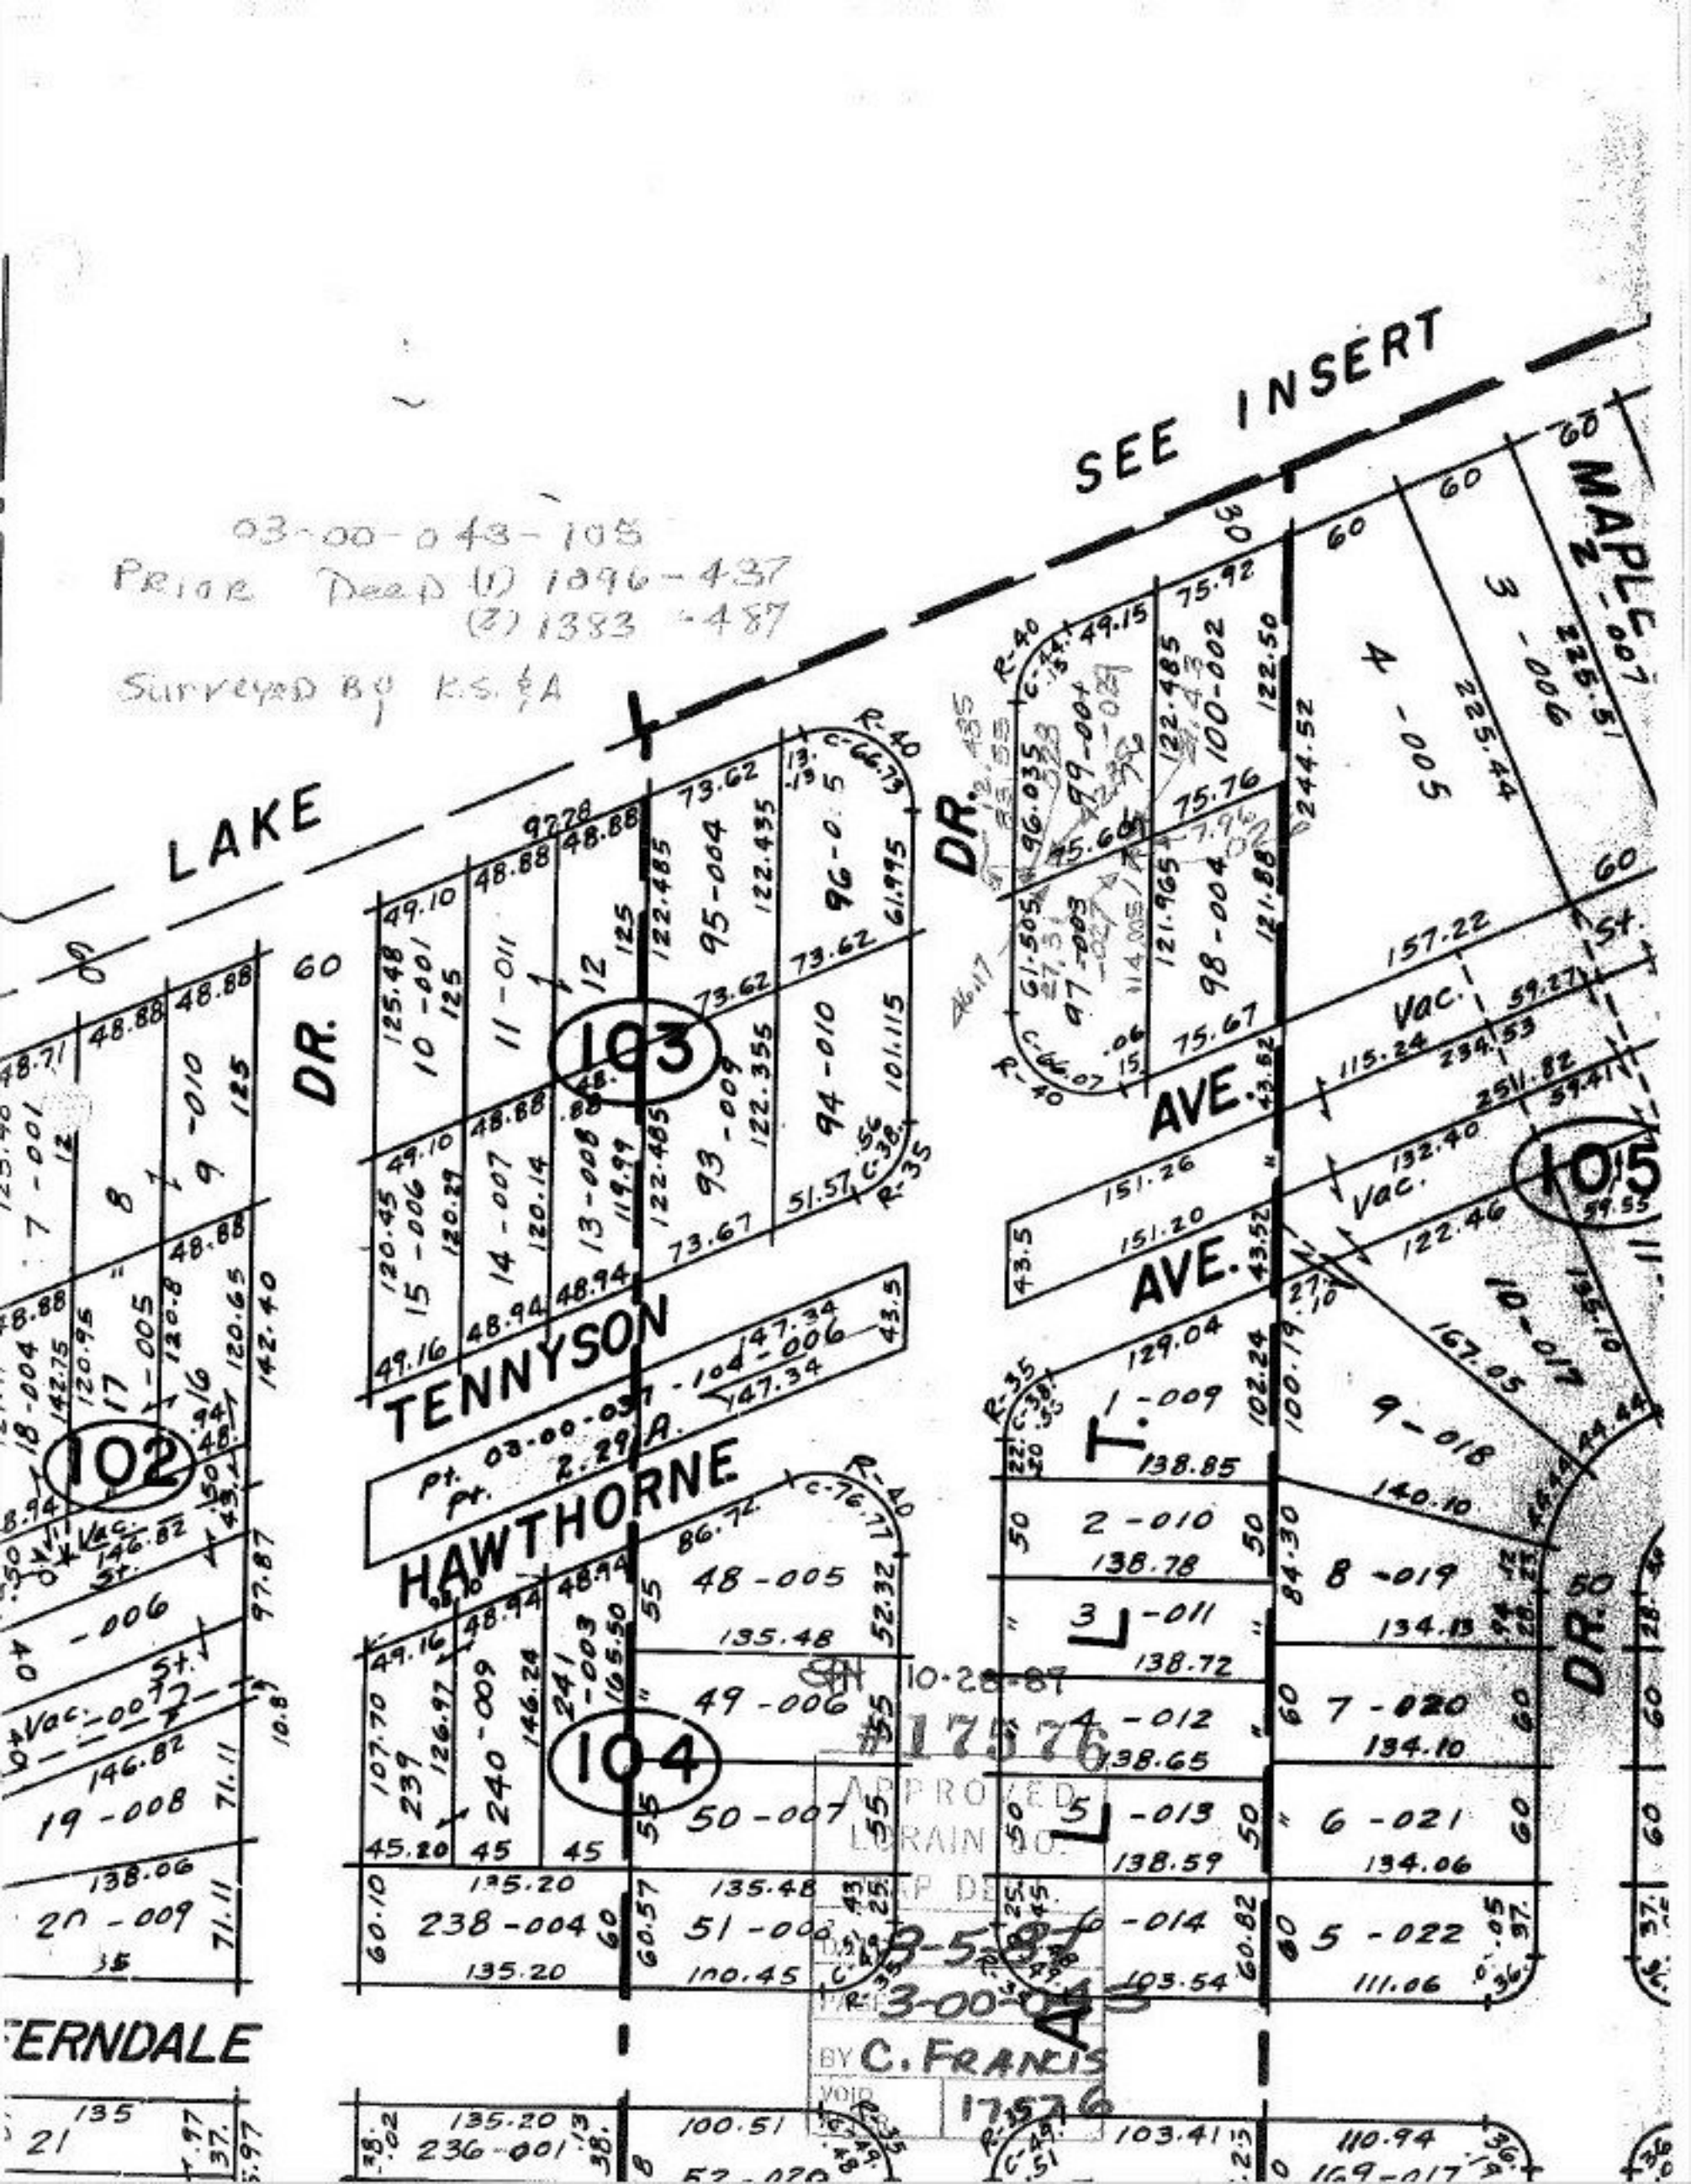
03-00-043-105
PRIOR DEED (1) 1096-437
(2) 1383-487
SURVEYED BY K.S. & A
SEE INSERT
LAKE
DR.
TENNYSON
HAWTHORNE
AVE.
AVE.
MAPLE
DR.
FERNDALE
103
102
104
105
Pt. 03-00-037-104-006
Pt. 2.29 A.
10-28-87
#17576
APPROVED
LORAIN CO.
MAP DEPT.
3-5-87
3-00-043
BY C. FRANCIS
VOID
17576