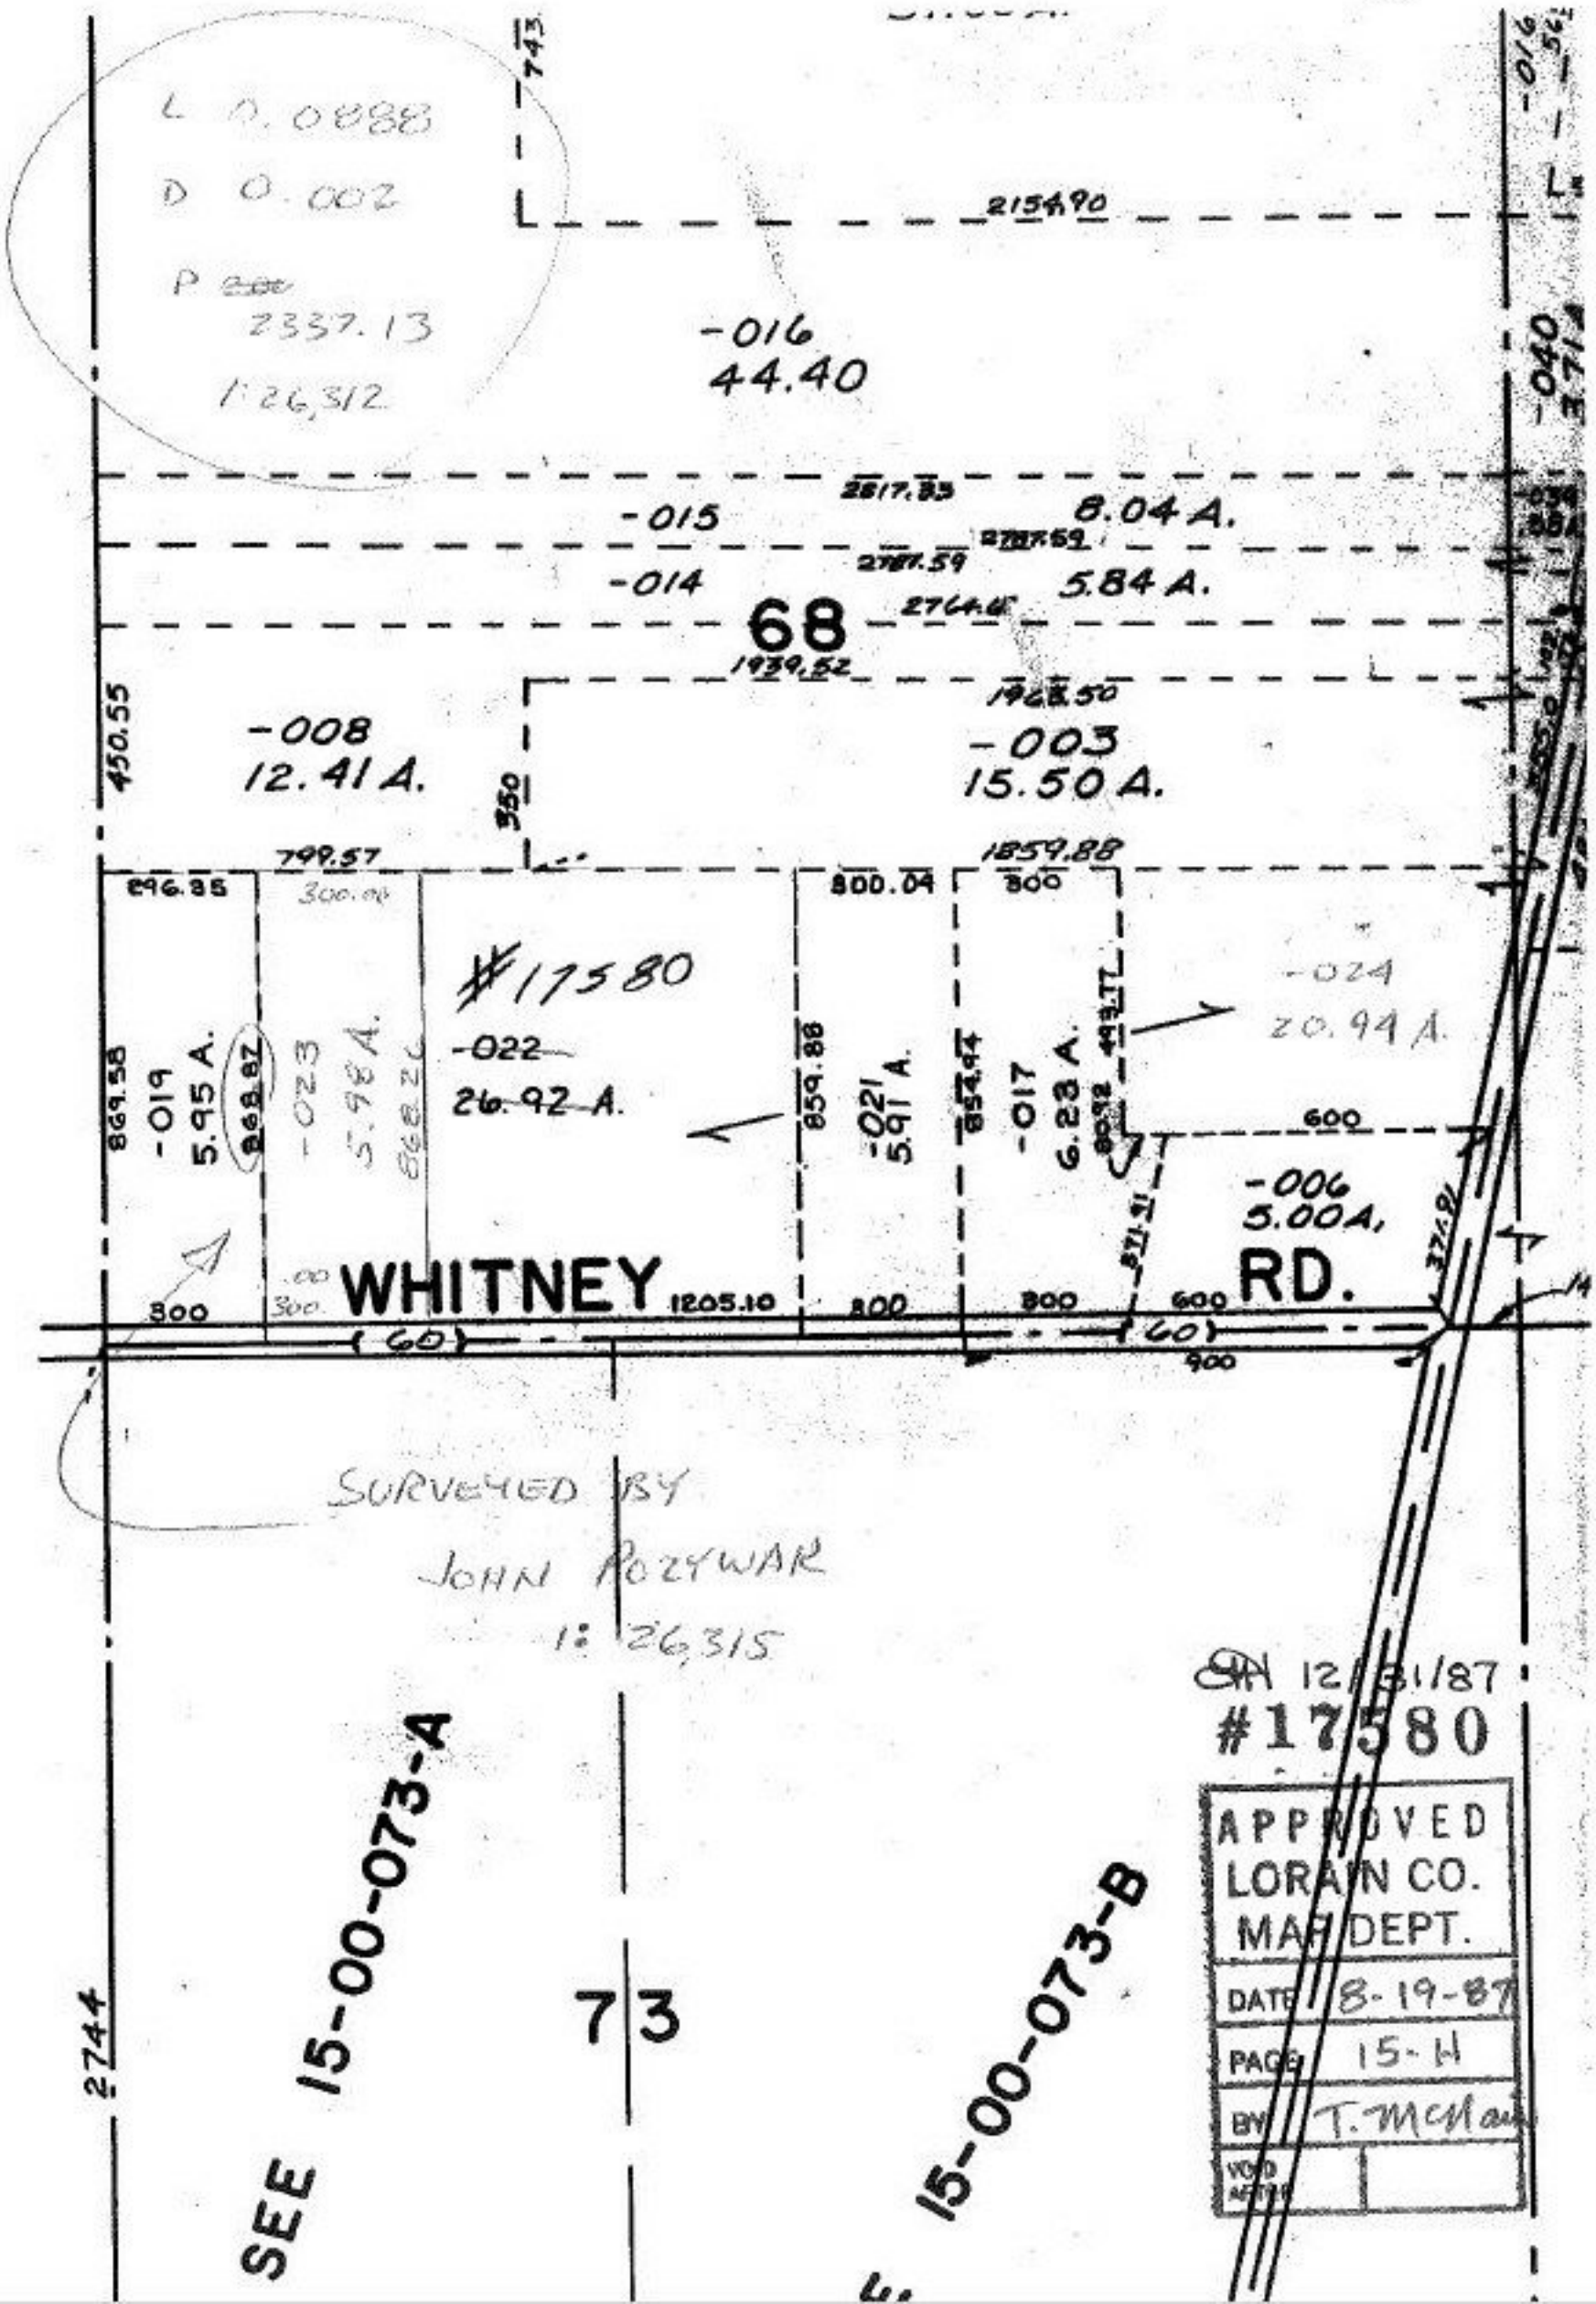
L 0.0888
D 0.002
P 2337.13
1:26,312
2154.90
-016
44.40
2817.33
-015
8.04 A.
2787.59
-014
5.84 A.
68
1939.52
1968.50
-008
12.41 A.
-003
15.50 A.
450.55
350
799.57
1859.88
296.35
300.00
800.04
300
#17580
-022
26.92 A.
-024
20.94 A.
869.58
-019
5.95 A.
868.87
-023
5.98 A.
868.26
859.88
-021
5.91 A.
854.94
-017
6.23 A.
600
-006
5.00 A.
WHITNEY
RD.
1205.10
300
600
900
SURVEYED BY
JOHN POZYWAR
1: 26,315
12/31/87
#17580
APPROVED
LORAIN CO.
MAP DEPT.
DATE 8-19-87
PAGE 15-H
BY T. McNair
VOID AFTER
SEE 15-00-073-A
73
15-00-073-B
2744