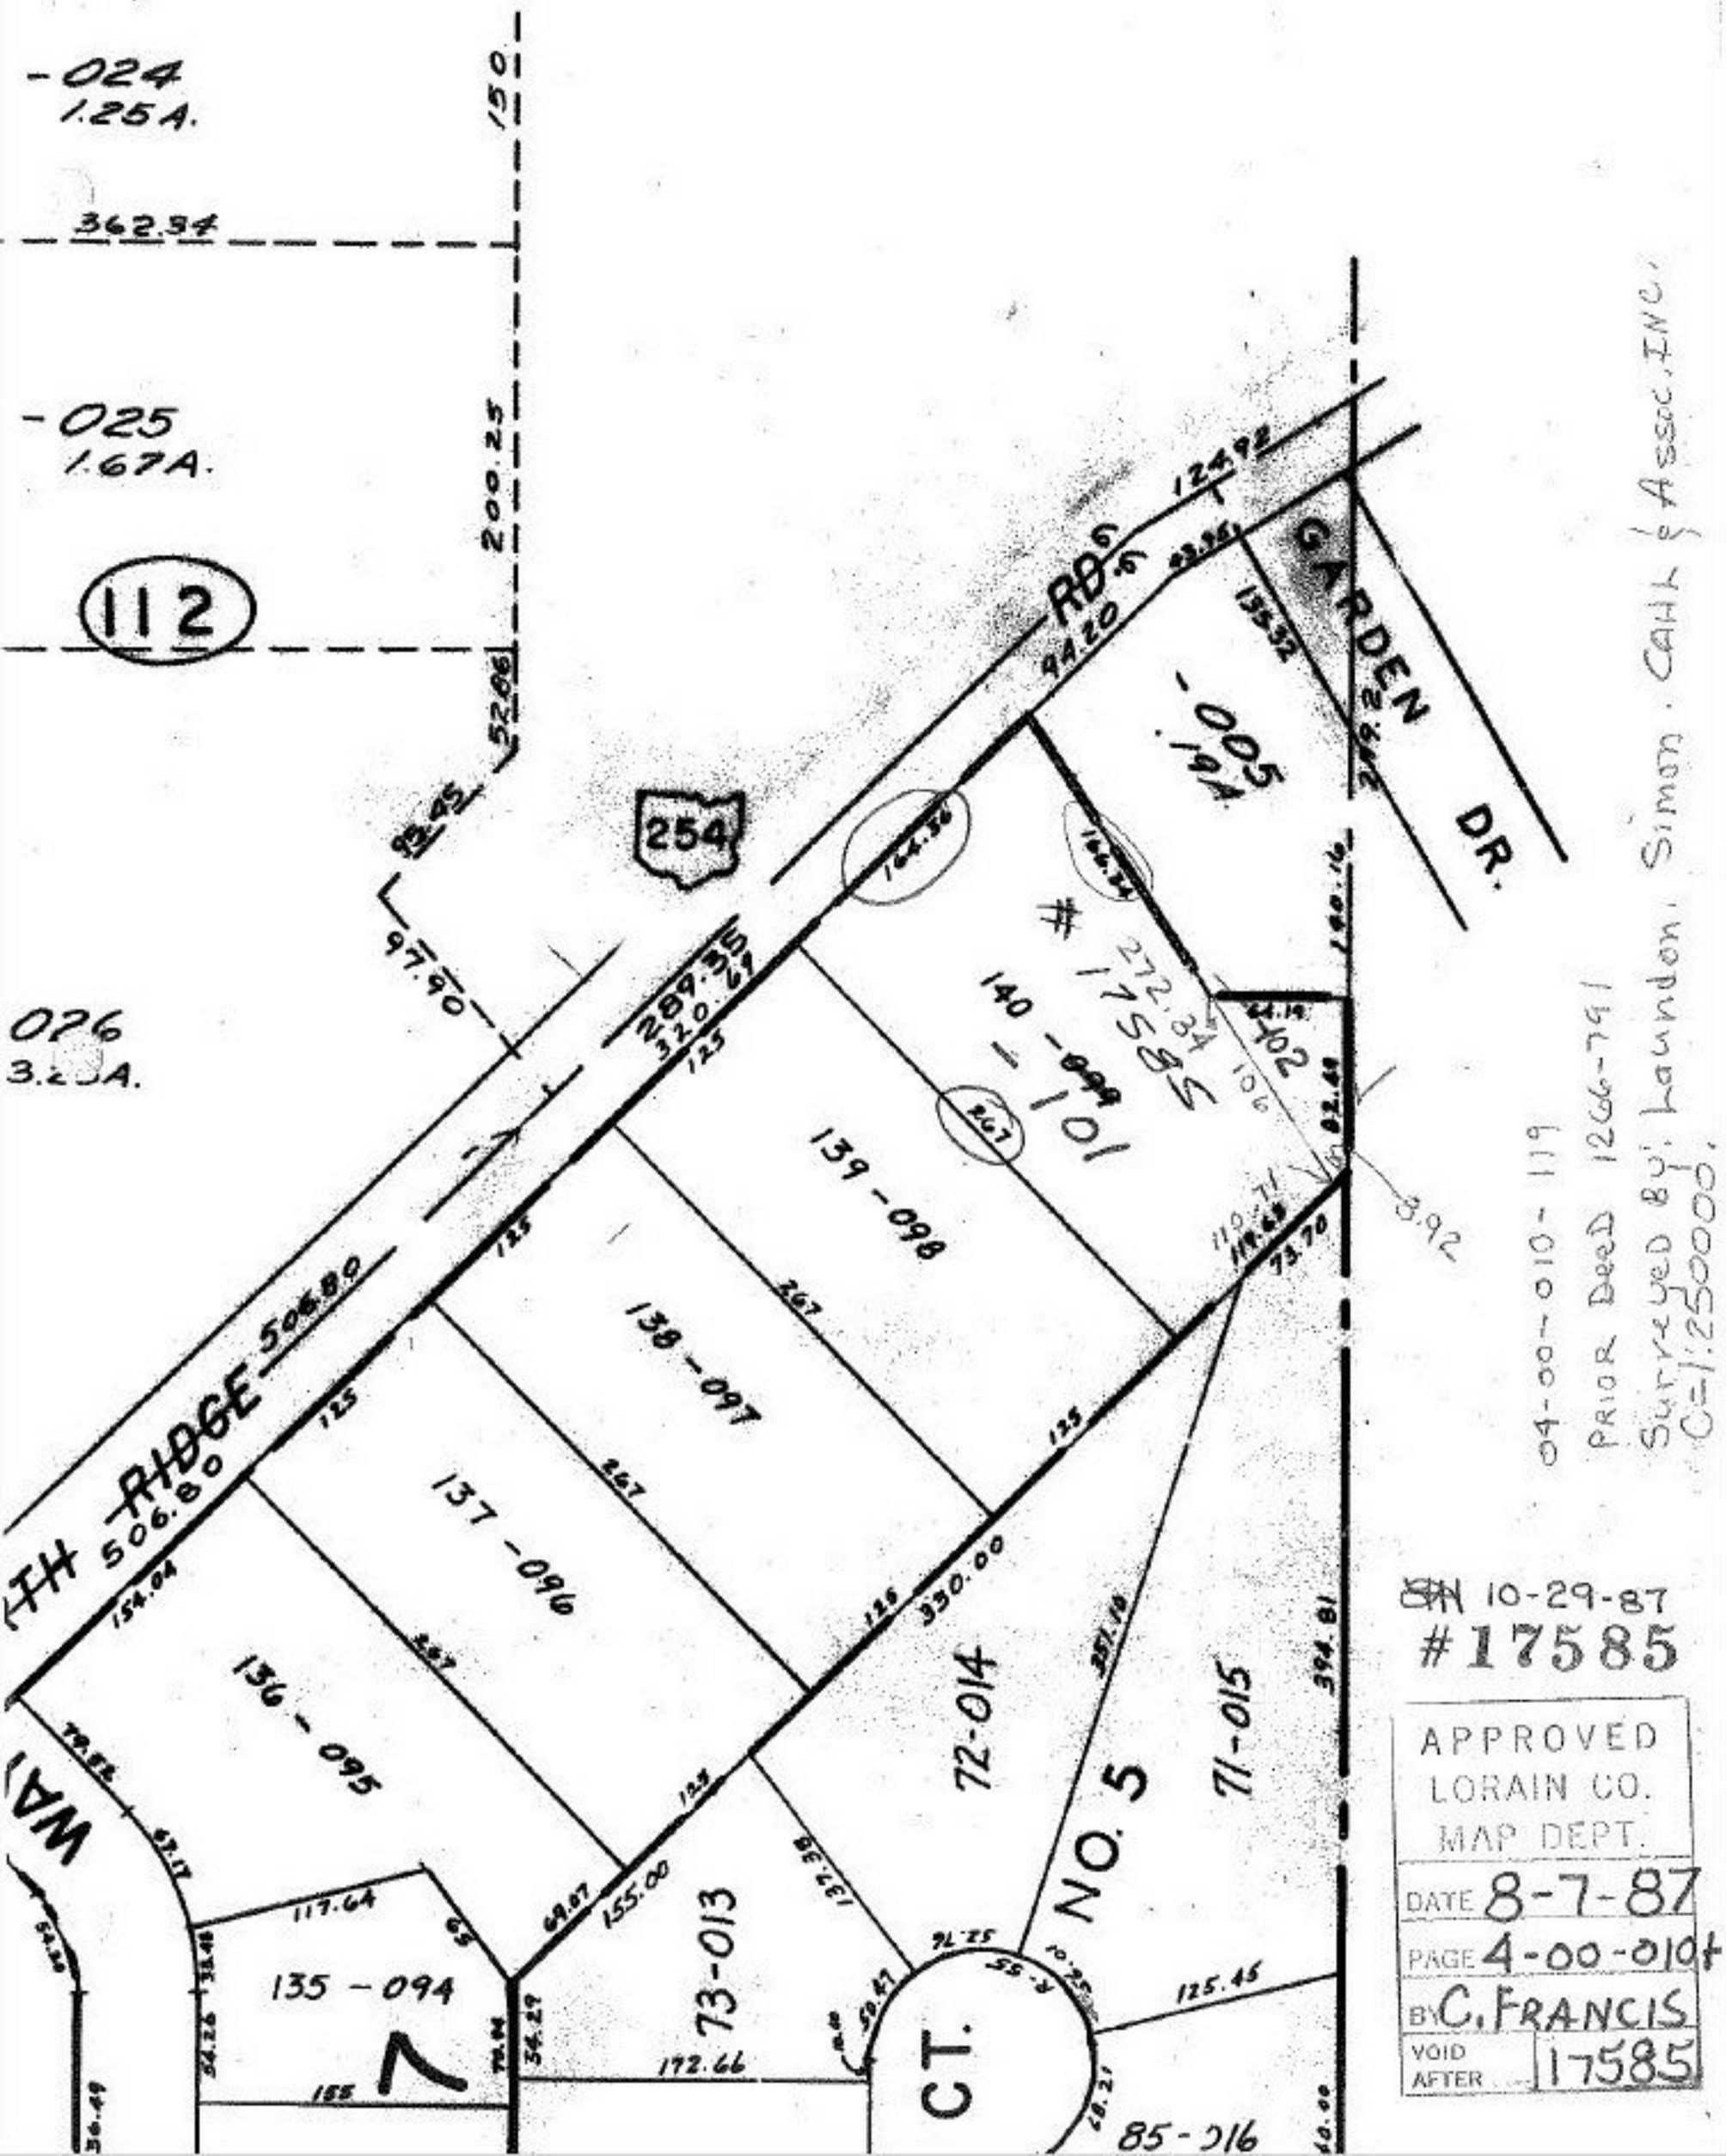

-024
1.25A.
362.34
-025
1.67A.
112
150
200.25
52.86
95.45
97.90
254
RD.
124.92
94.20
GARDEN DR.
-005
.19A.
289.35
320.69
125
140 -099
-101
272.34
#17585
102
106
139-098
138-097
137-096
136-095
135-094
506.80
506.80
154.04
330.00
72-014
71-015
NO. 5
73-013
CT.
85-016
117.64
155.00
172.66
125.45
394.81
73.70
8.92
04-00-010-119
PRIOR DEED 1266-791
Surveyed By: Laundon, Simon, CAHL & Assoc. INC.
C=1:250000.
10-29-87
#17585
APPROVED
LORAIN CO.
MAP DEPT.
DATE 8-7-87
PAGE 4-00-010+
BY C. FRANCIS
VOID AFTER 17585