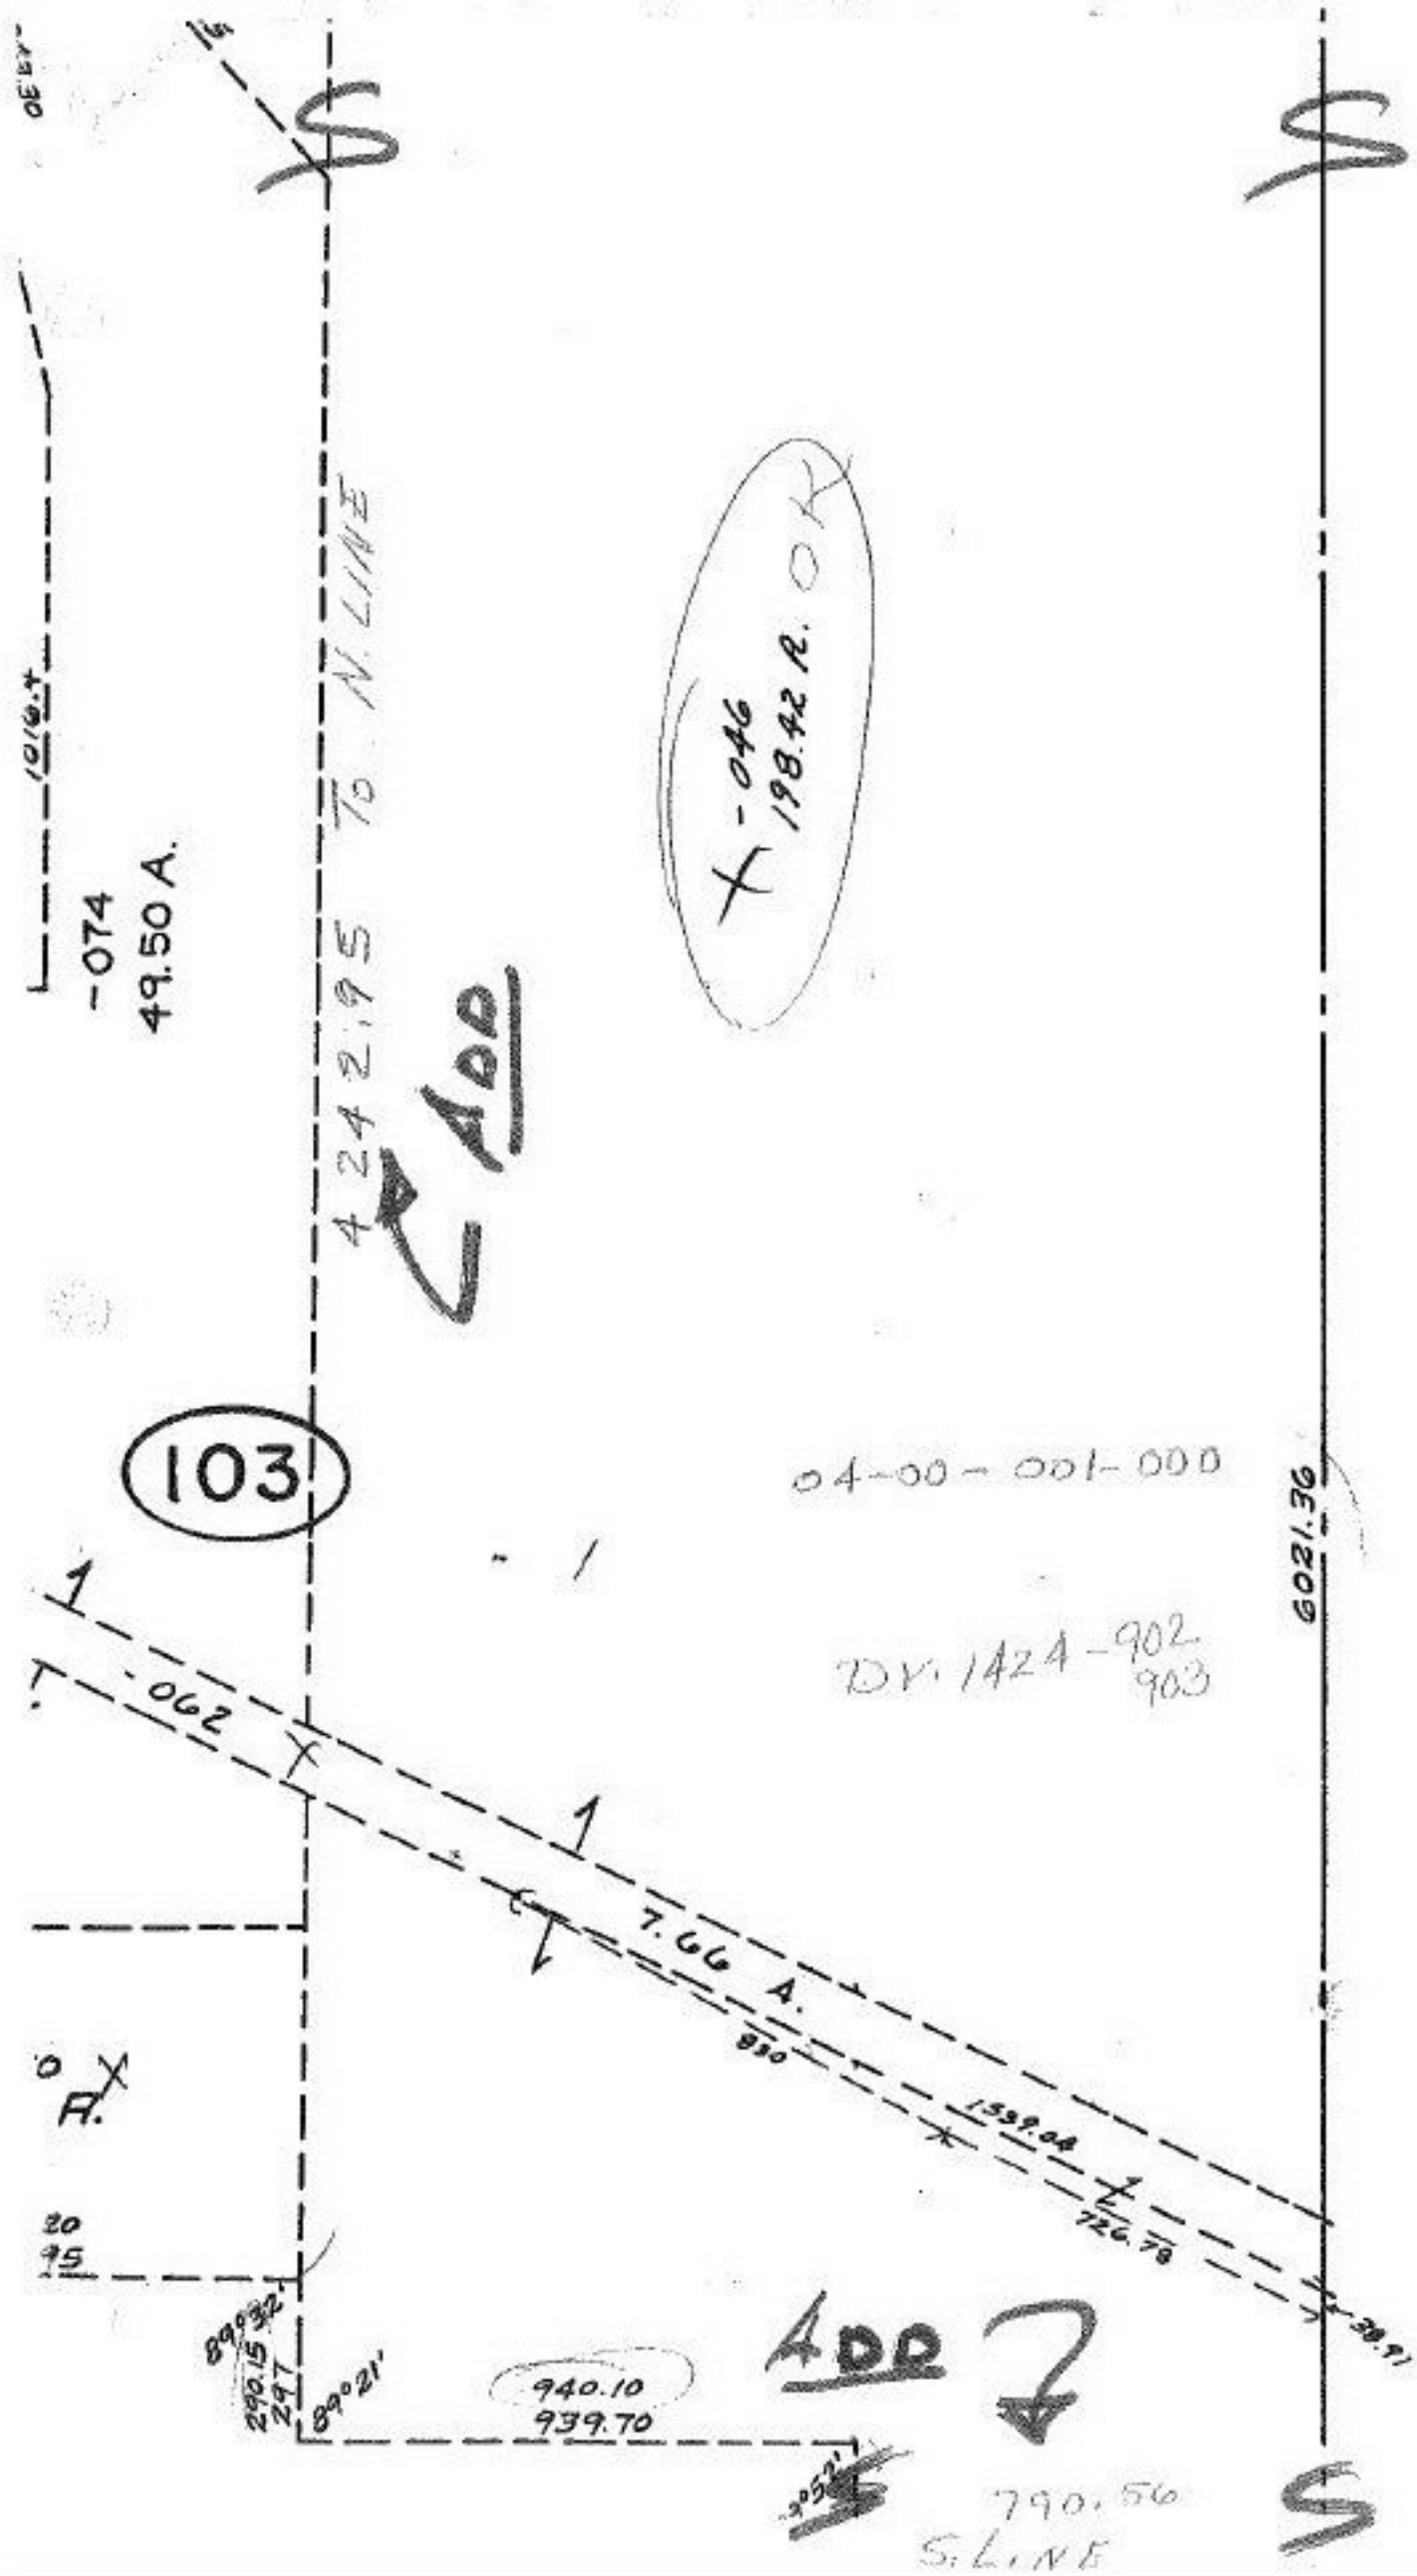

ADD DISTANCES ONLY

JH 10/29/87

#17587

APPROVED
LORAIN CO.
MAP DEPT.

DATE 8-10-87

PAGE 4-I

BY C. FRANCIS

VOID AFTER 17587